

EXCAVATION AND REMOVAL OF ROAD SURFACES AND/OR PAVEMENTS ITEM 119

Rt  
59+00-62+00  
2+50

CONSTRUCT APPROACH


Rt  
58+80  
SUB-BASE OF SAND  
63+30-65+00  
2+75

CONSTRUCT SPECIAL DITCH  
(to be paid under Item 103-A-1)

Rt  
62+75-66+00

CONSTRUCT DRIVE

Rt  
57+25  
65+25  
63+50  
62+60  
SIT 12" Elm  
Assm'd Elev 498.48

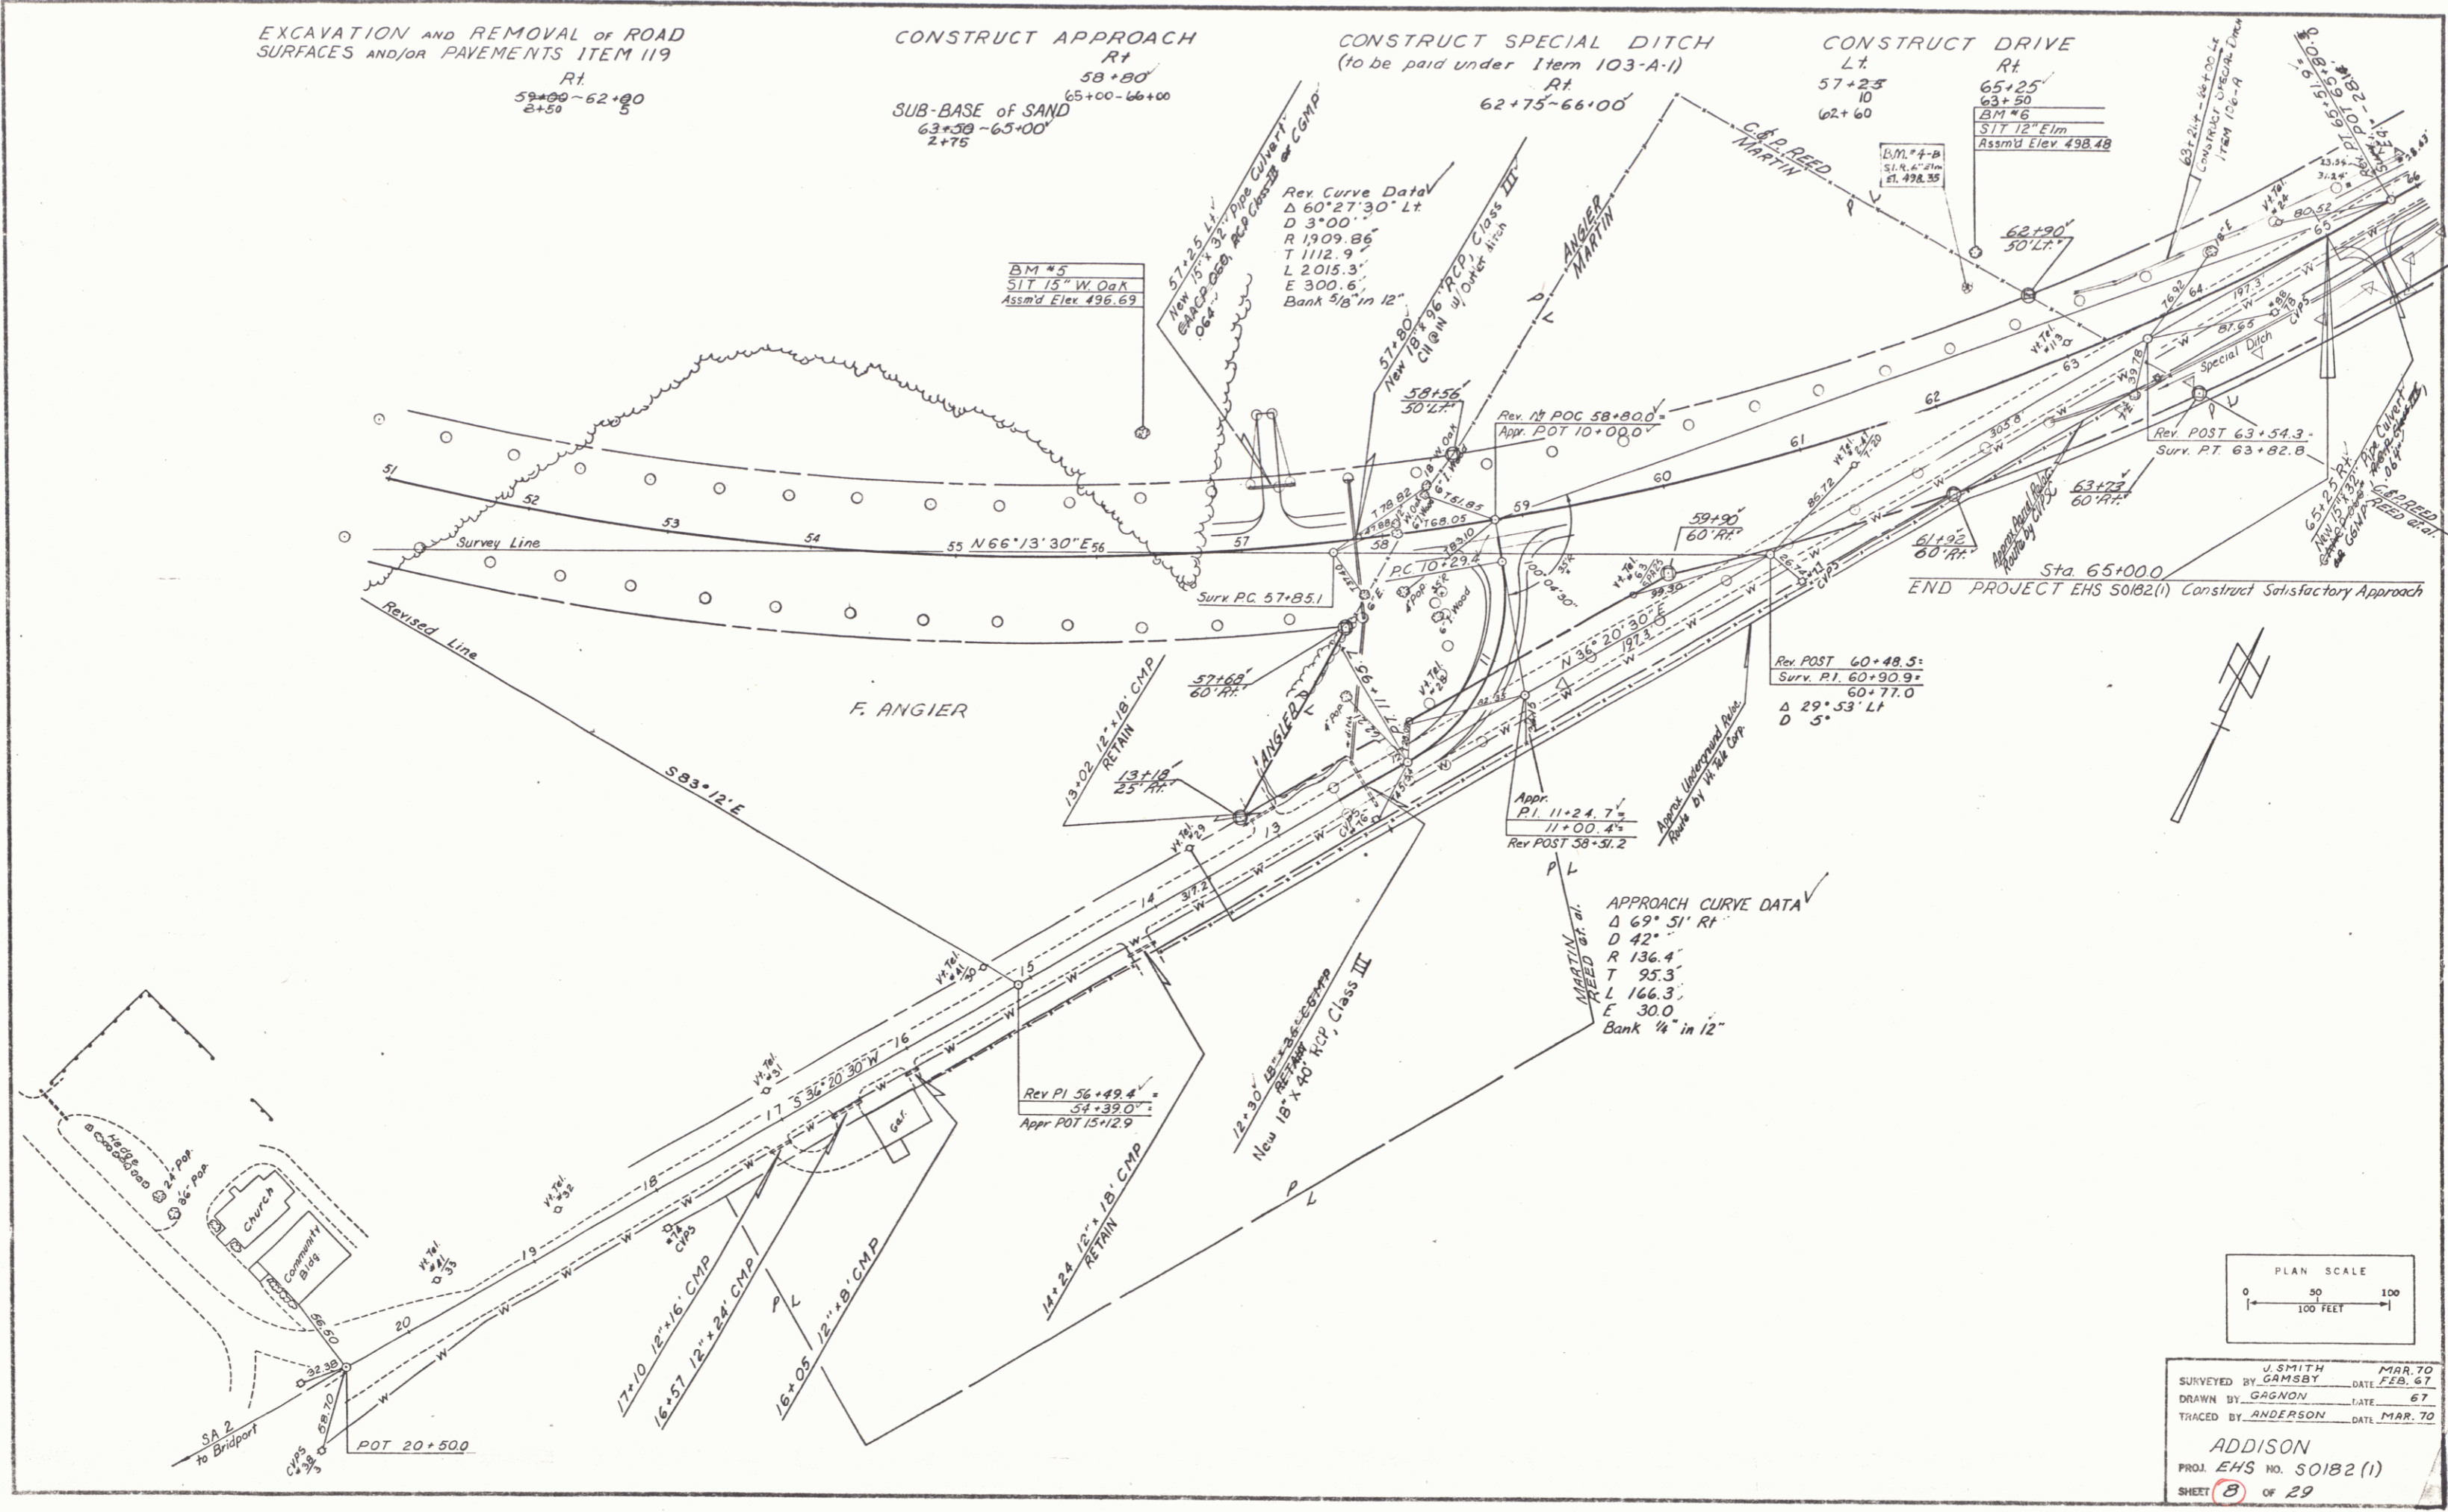

DM # 6  
SIT 15" W. Oak  
Assm'd Elev 496.69

Rev Curve Data  
Δ 60° 27' 30" Lt  
D 3° 00'  
R 1909.86'  
T 1112.9'  
L 2015.3'  
E 300.6'  
Bank 3/8" in 12"

APPROACH CURVE DATA  
Δ 69° 51' Rt  
D 42'  
R 136.4'  
T 95.3'  
L 166.3'  
E 30.0'  
Bank 1/4" in 12"

PLAN SCALE  
0 50 100  
100 FEET

J. SMITH MAR 70  
SURVEYED BY GAMSBY DATE FEB 67  
DRAWN BY GAGNON DATE 67  
TRACED BY ANDERSON DATE MAR 70

ADDISON  
PROJ. EHS NO. 50182(1)  
SHEET 8 OF 29

D-7