


DATE: 10/20/00
 DRAWN BY: [Signature]
 CHECKED BY: [Signature]
 NO. 1

DATE: 10/20/00
 DRAWN BY: [Signature]
 CHECKED BY: [Signature]
 NO. 1

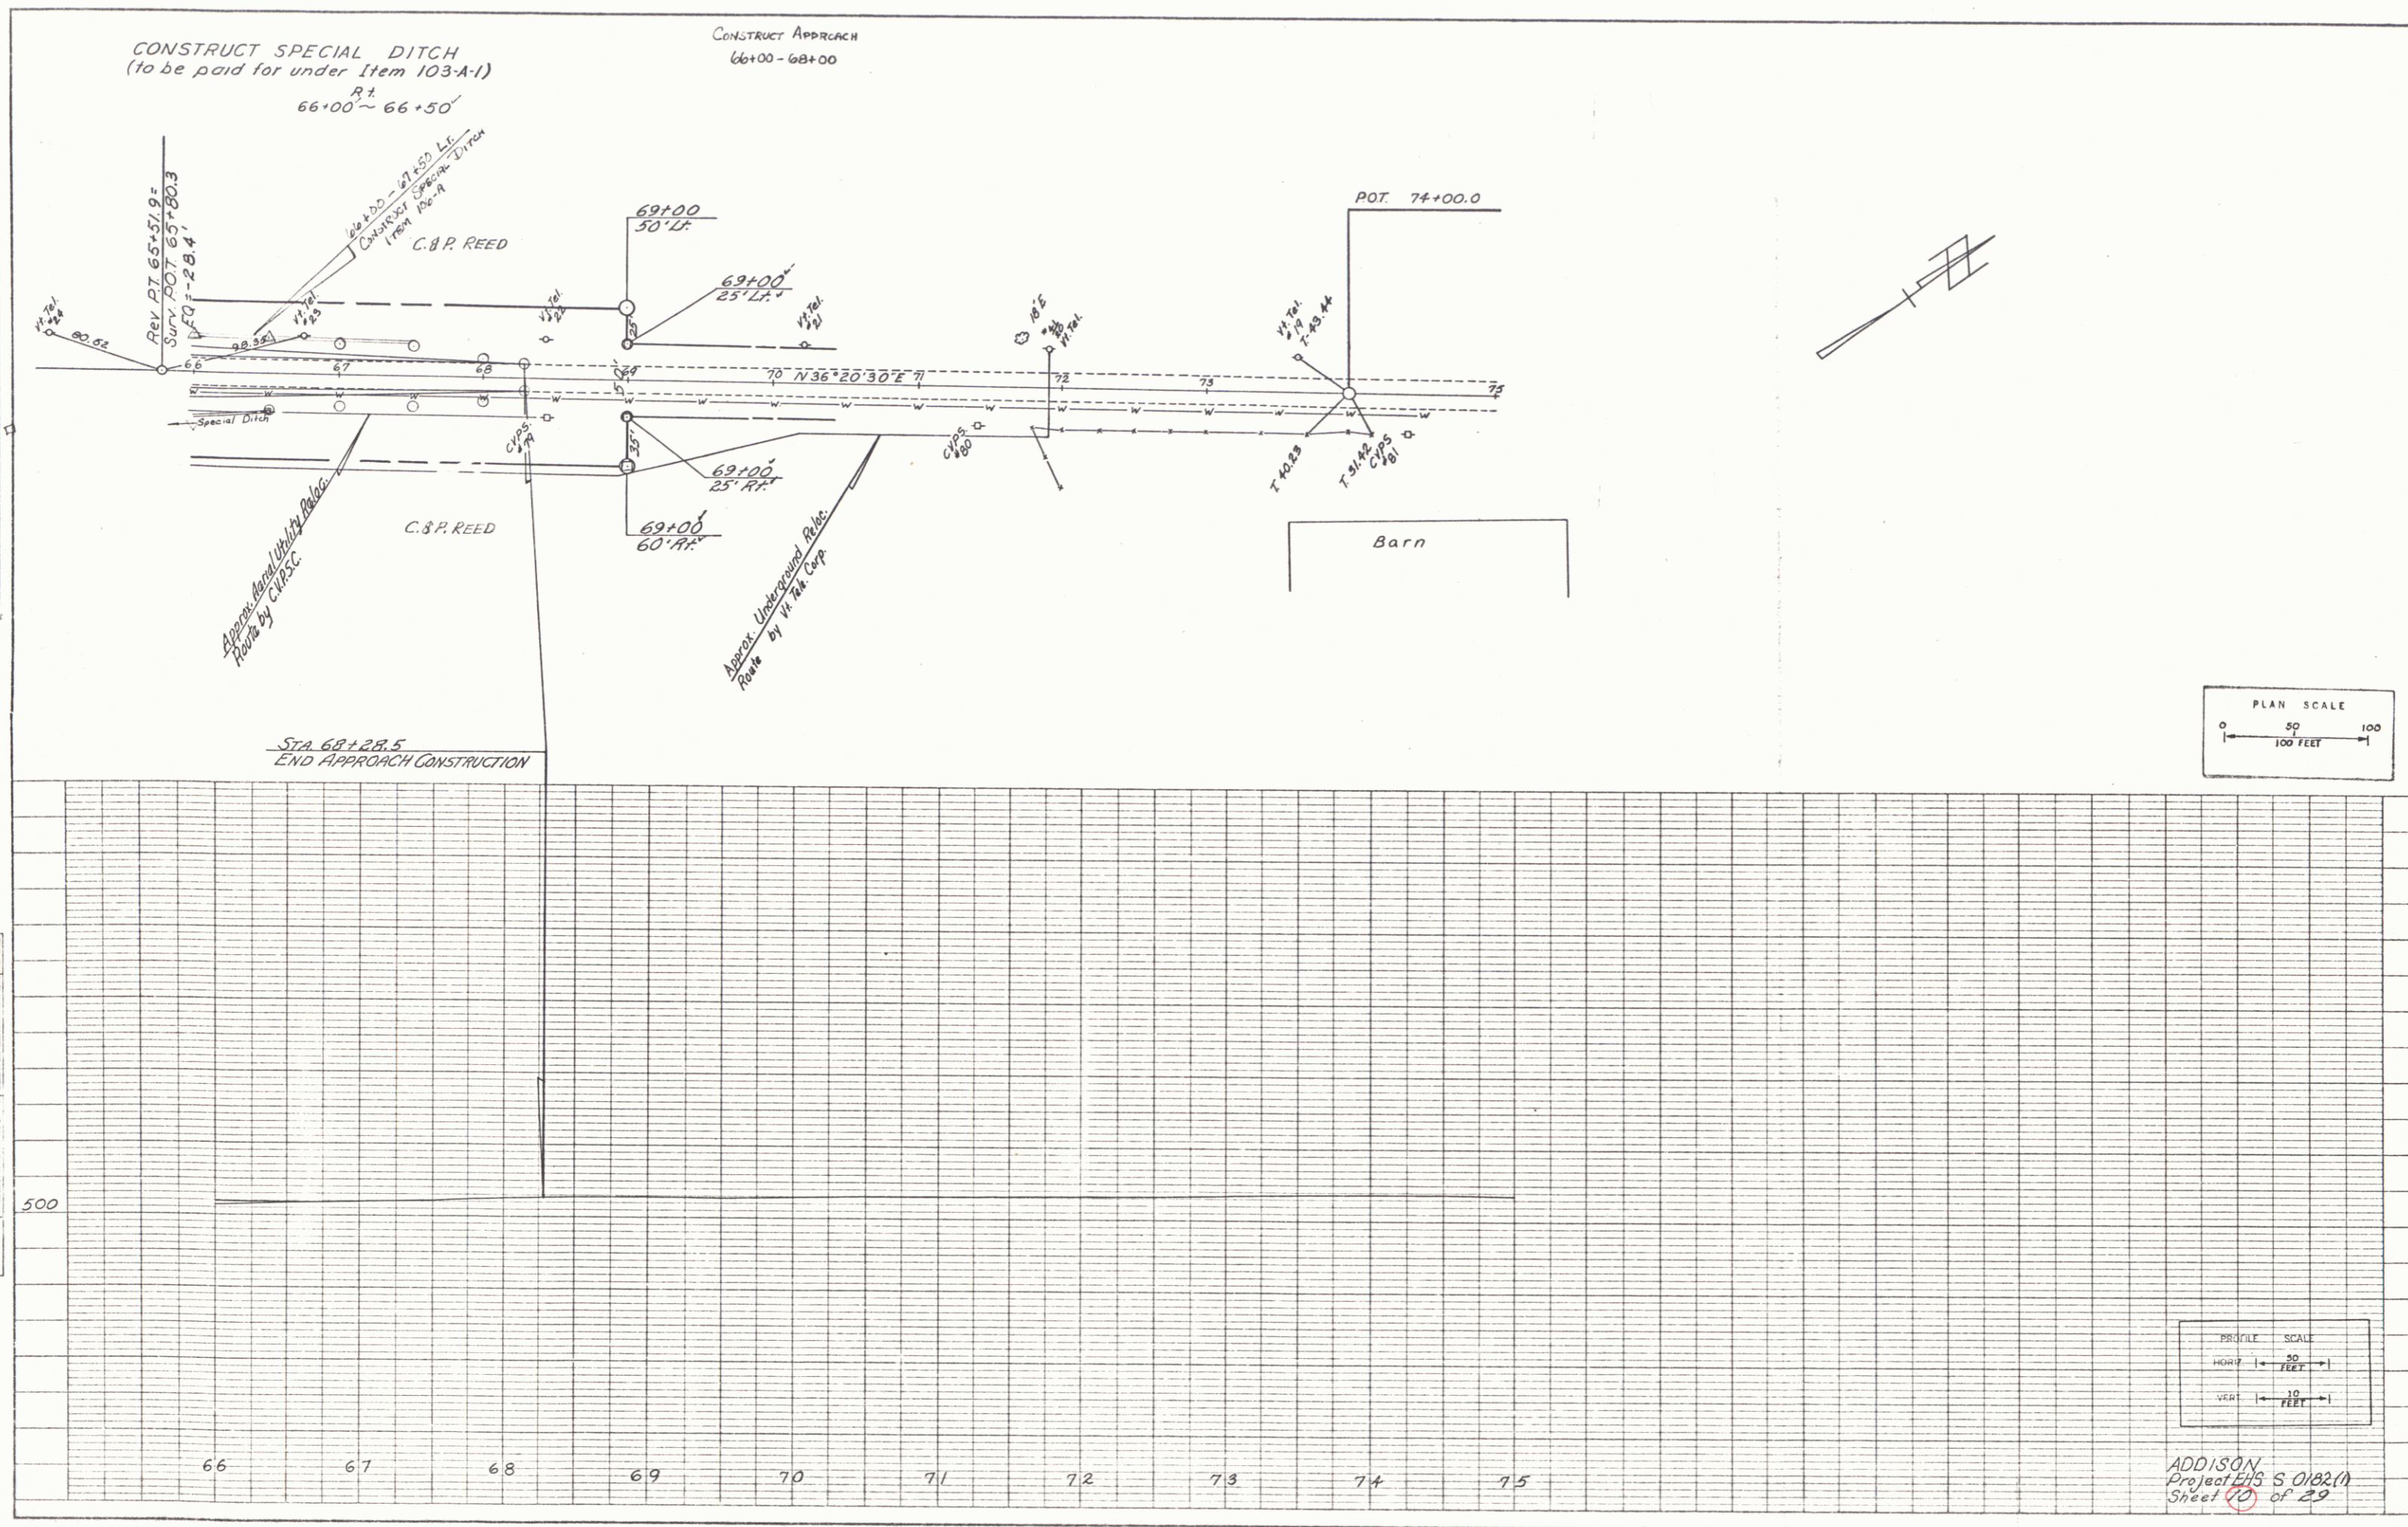

PROFILE SCALE
 HORIZ. 1" = 20 FEET
 VERT. 1" = 10 FEET

ADDISON
 Project # S 0102(1)
 Sheet 10 of 29

5