

DATE: 1/22/22
 BY: S. J. [Signature]
 PROJECT: [Signature]
 PLAN: [Signature]
 NOTE BOOK: [Signature]
 NO.:

DATE: 1/22/22
 BY: S. J. [Signature]
 PROJECT: [Signature]
 PROFILE: [Signature]
 NOTE BOOK: [Signature]
 NO.:

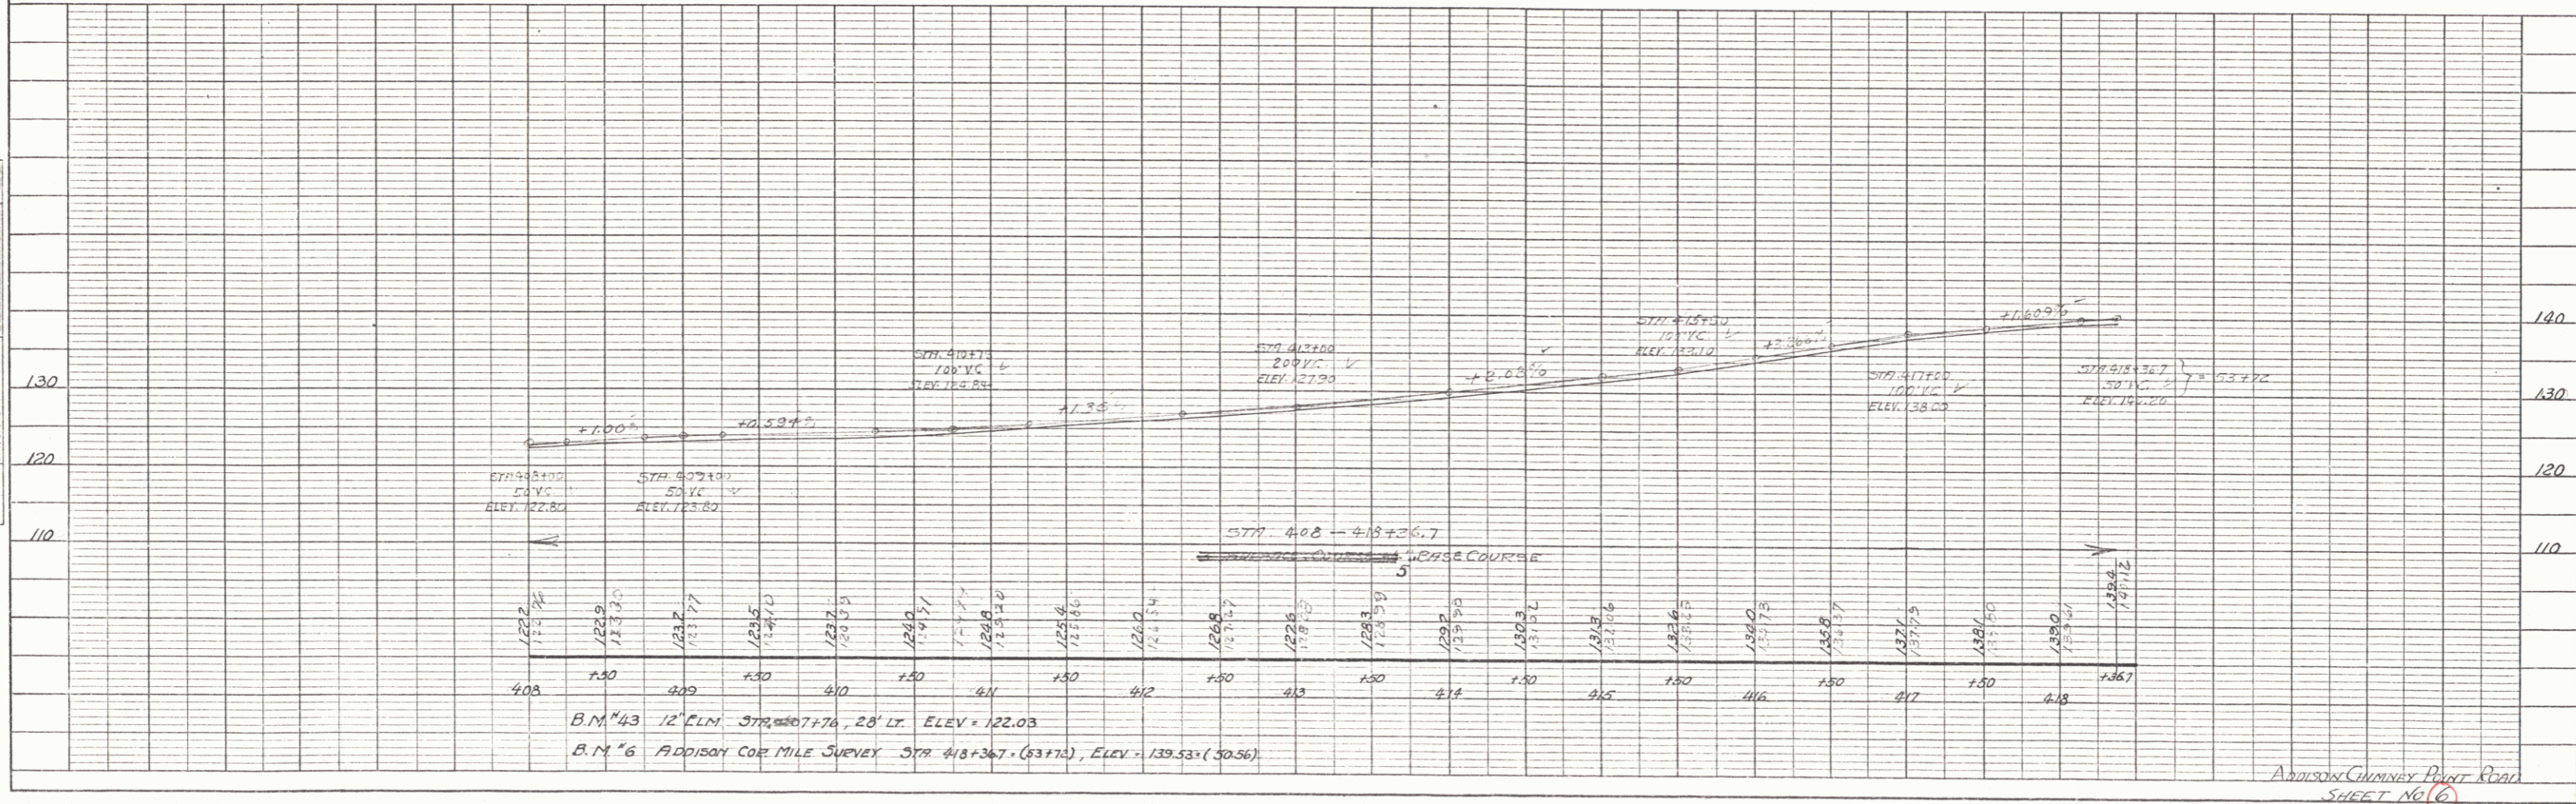
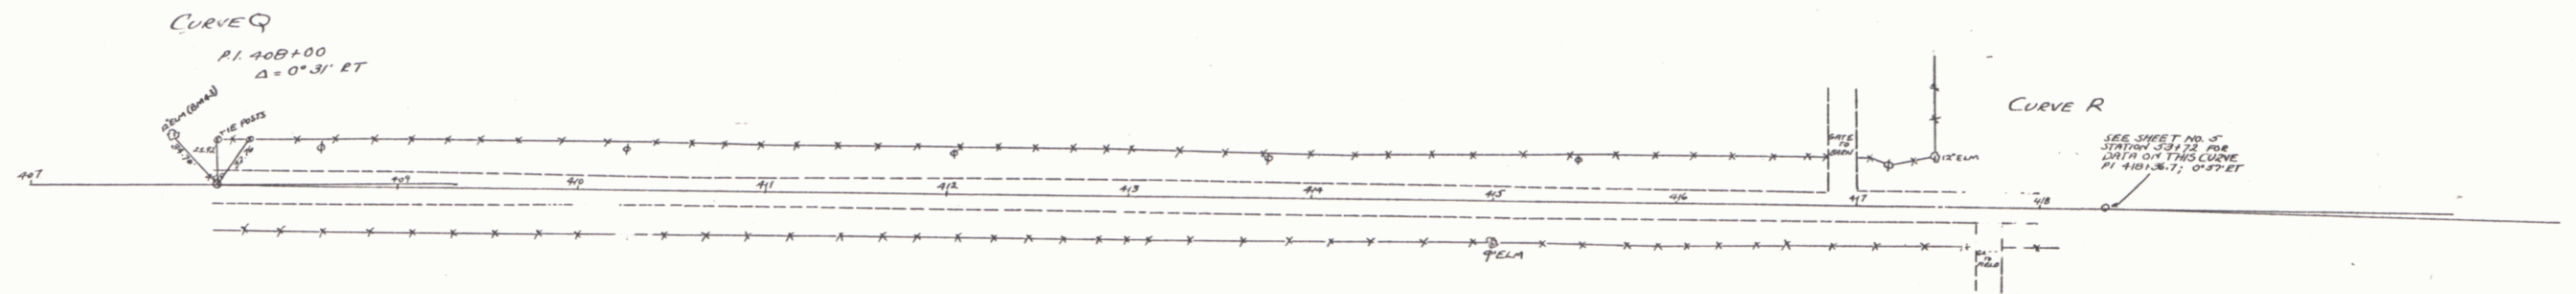


PLATE 1 - PLAN - PROFILE OF P. & A. L. STANDARD
 KUFFEL & ESSER CO. NEW YORK

ADDISON CHIMNEY POINT ROAD
 SHEET NO. 6