


PLAN
 DATE: 1/23/24
 DRAWN BY: [Signature]
 CHECKED BY: [Signature]
 PROJECT: [Project Name]
 SHEET NO. 3

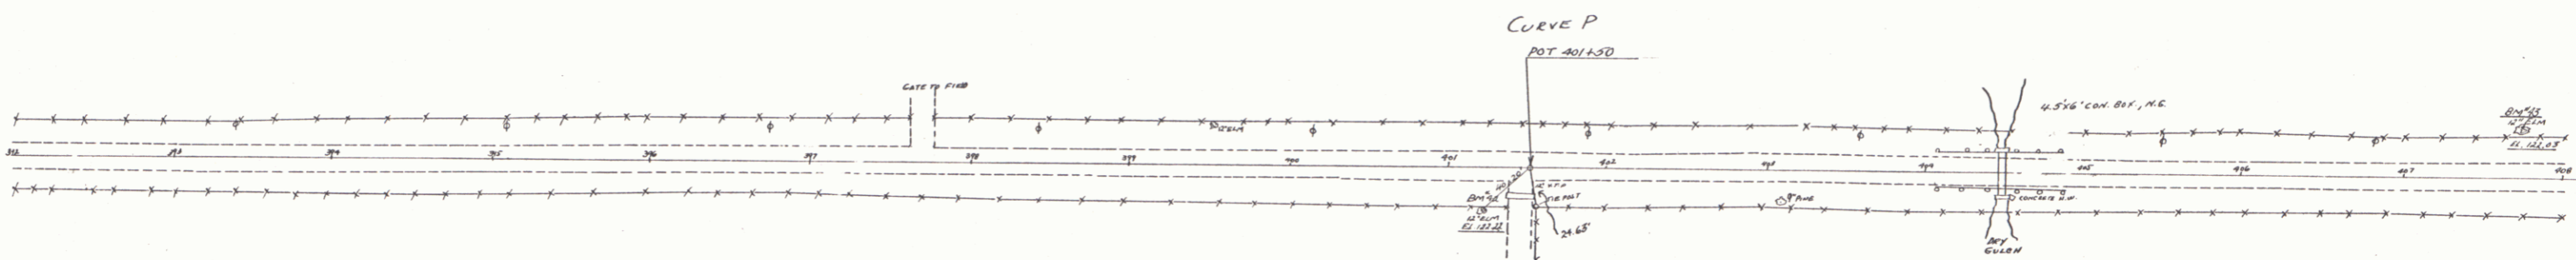

PROFILE
 DATE: 1/23/24
 DRAWN BY: [Signature]
 CHECKED BY: [Signature]
 PROJECT: [Project Name]
 SHEET NO. 3

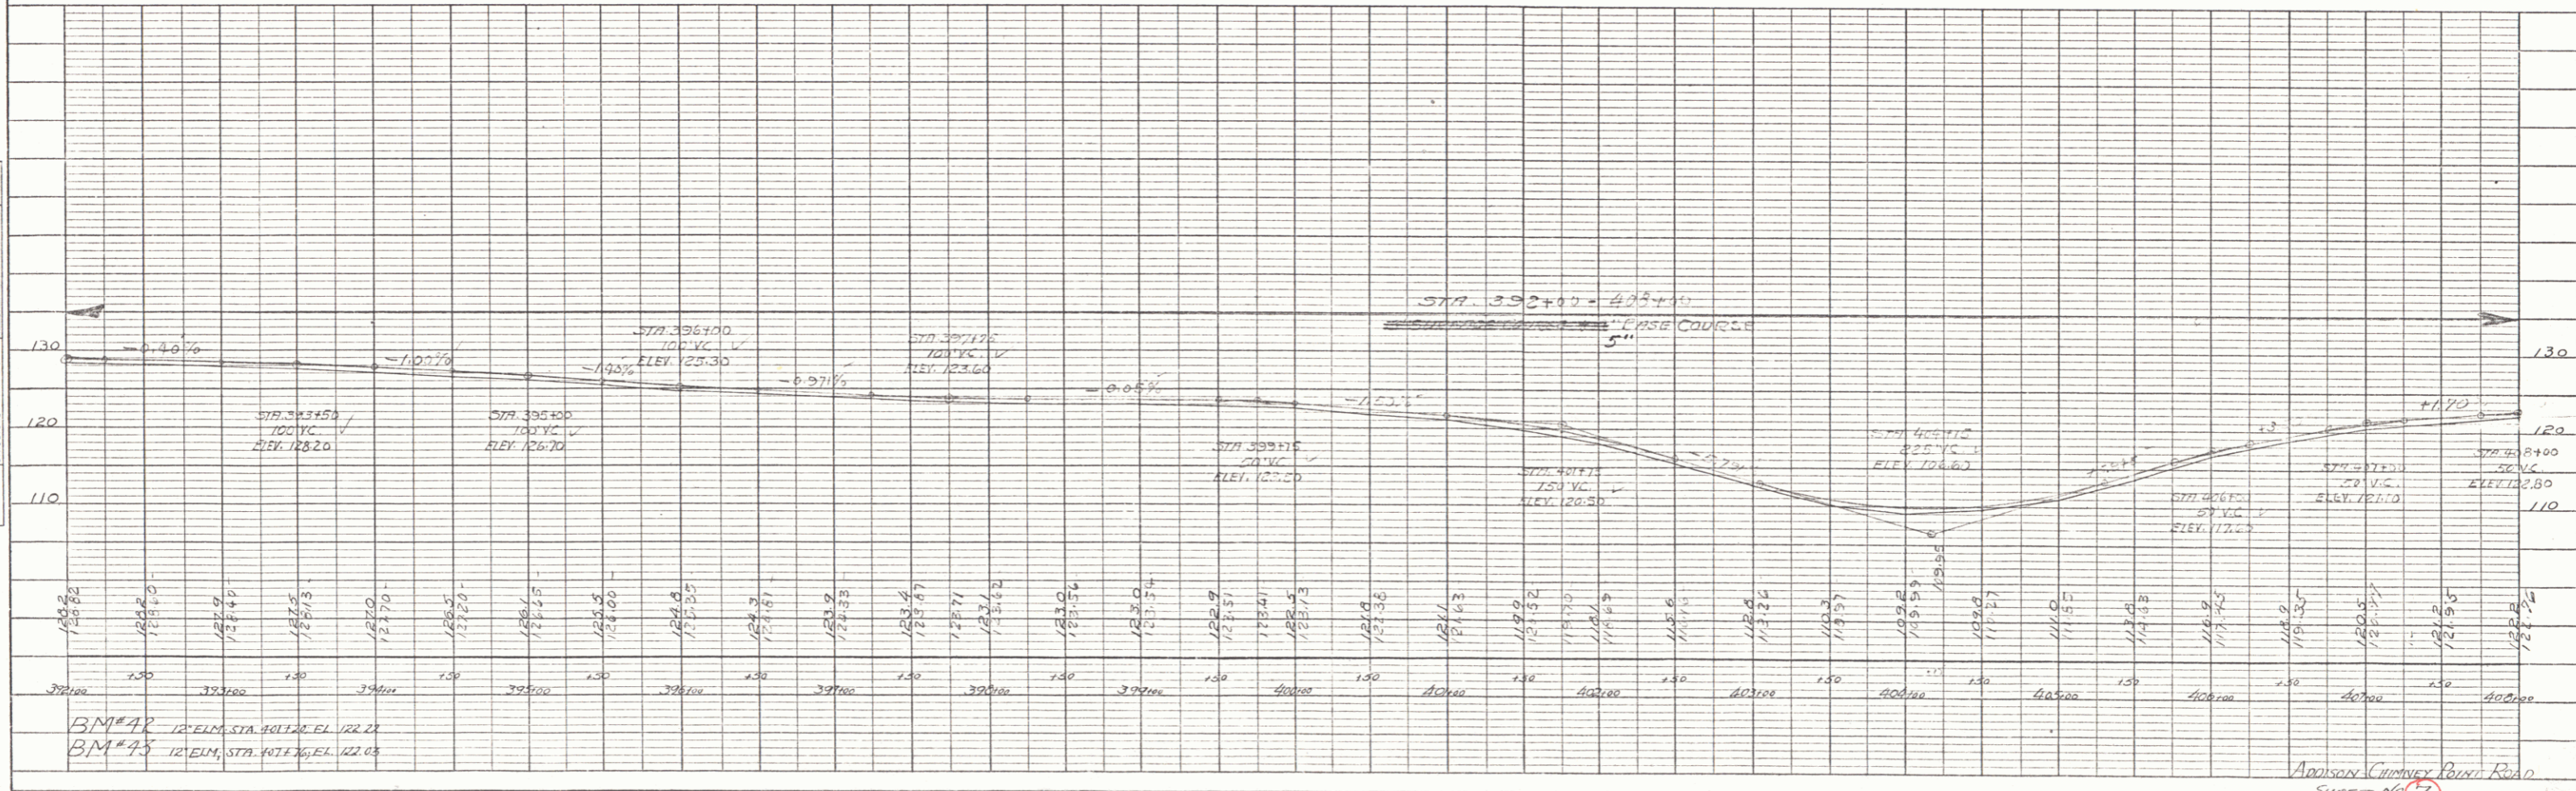


PLATE 1 - PLAN - PROFILE OF P. A. & L. STANBARD
 NEW YORK

Addison Chimney Point Road
 SHEET NO. 3