

DATE: 12/22/2011  
 PLAN: 100%  
 CHECKED: [Signature]  
 DATE: 12/22/2011  
 PLAN: 100%  
 CHECKED: [Signature]

DATE: 12/22/2011  
 PROFILE: 100%  
 CHECKED: [Signature]  
 DATE: 12/22/2011  
 PROFILE: 100%  
 CHECKED: [Signature]

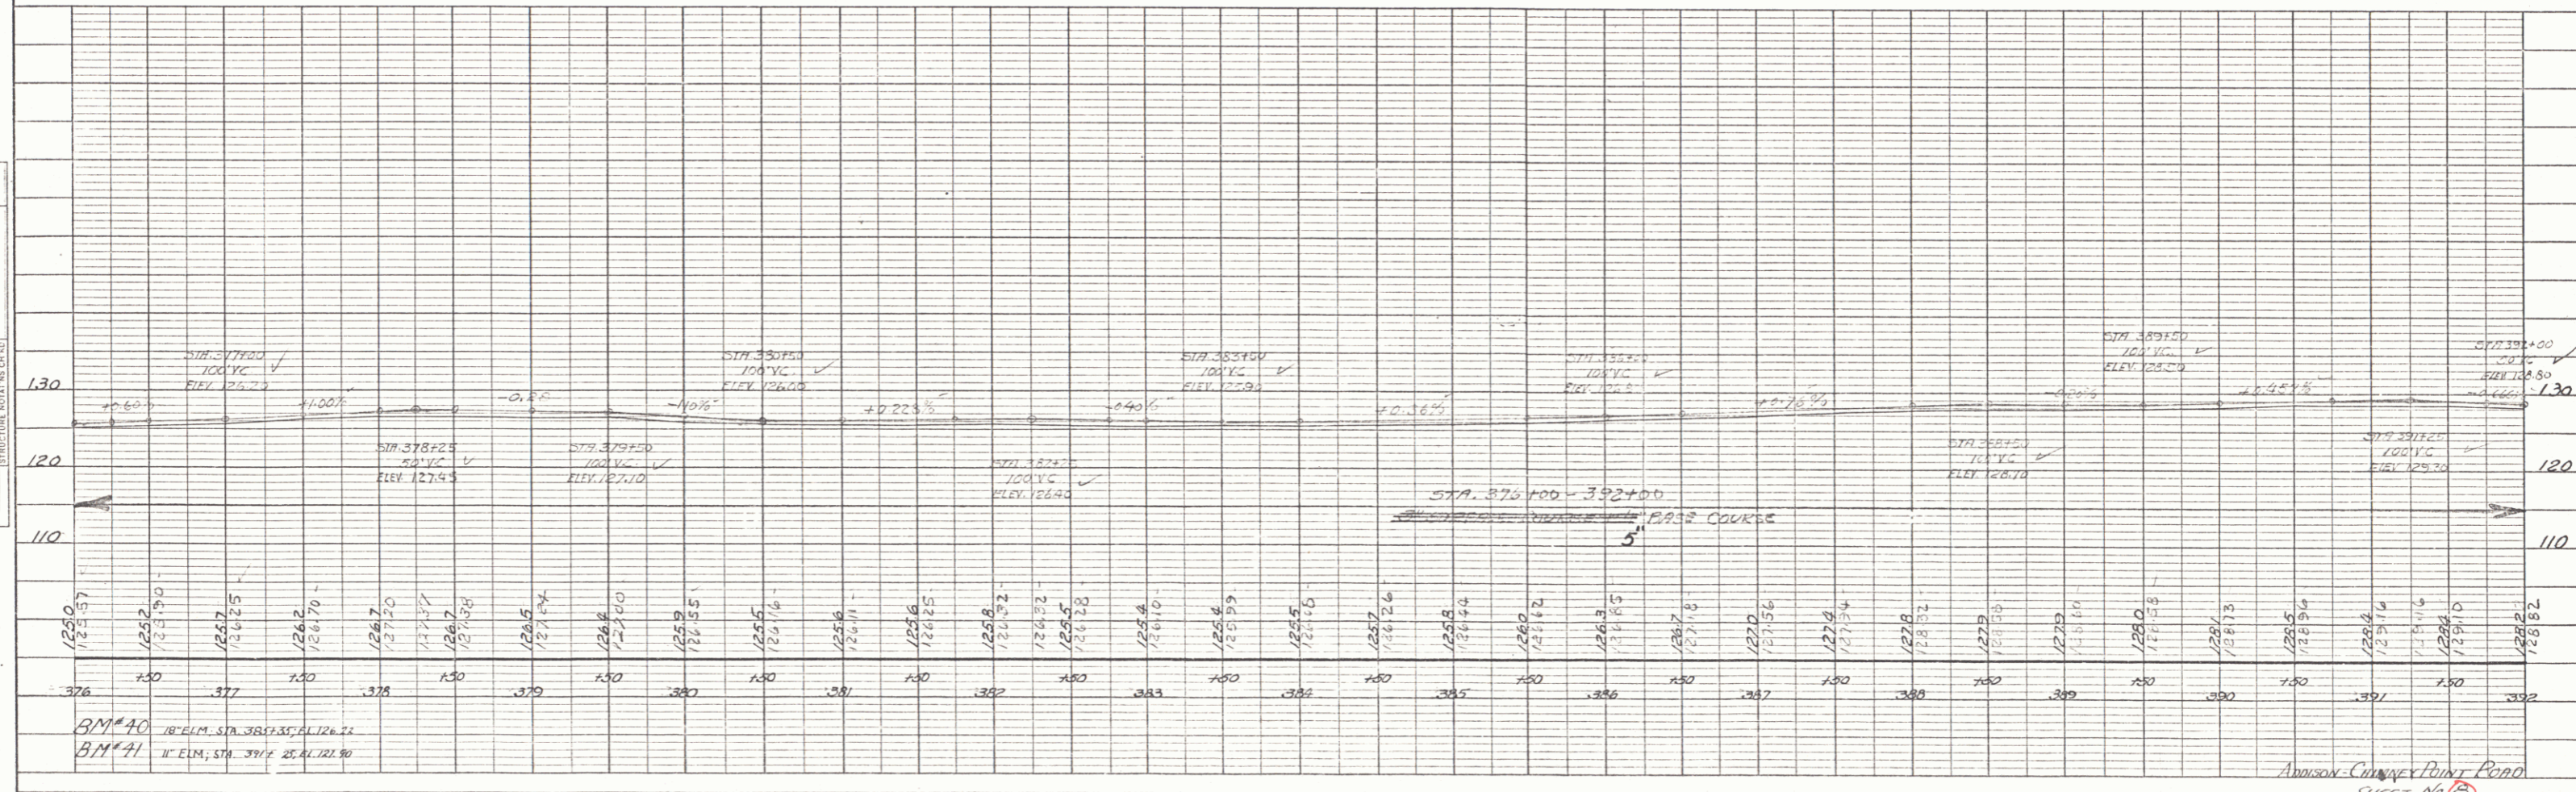
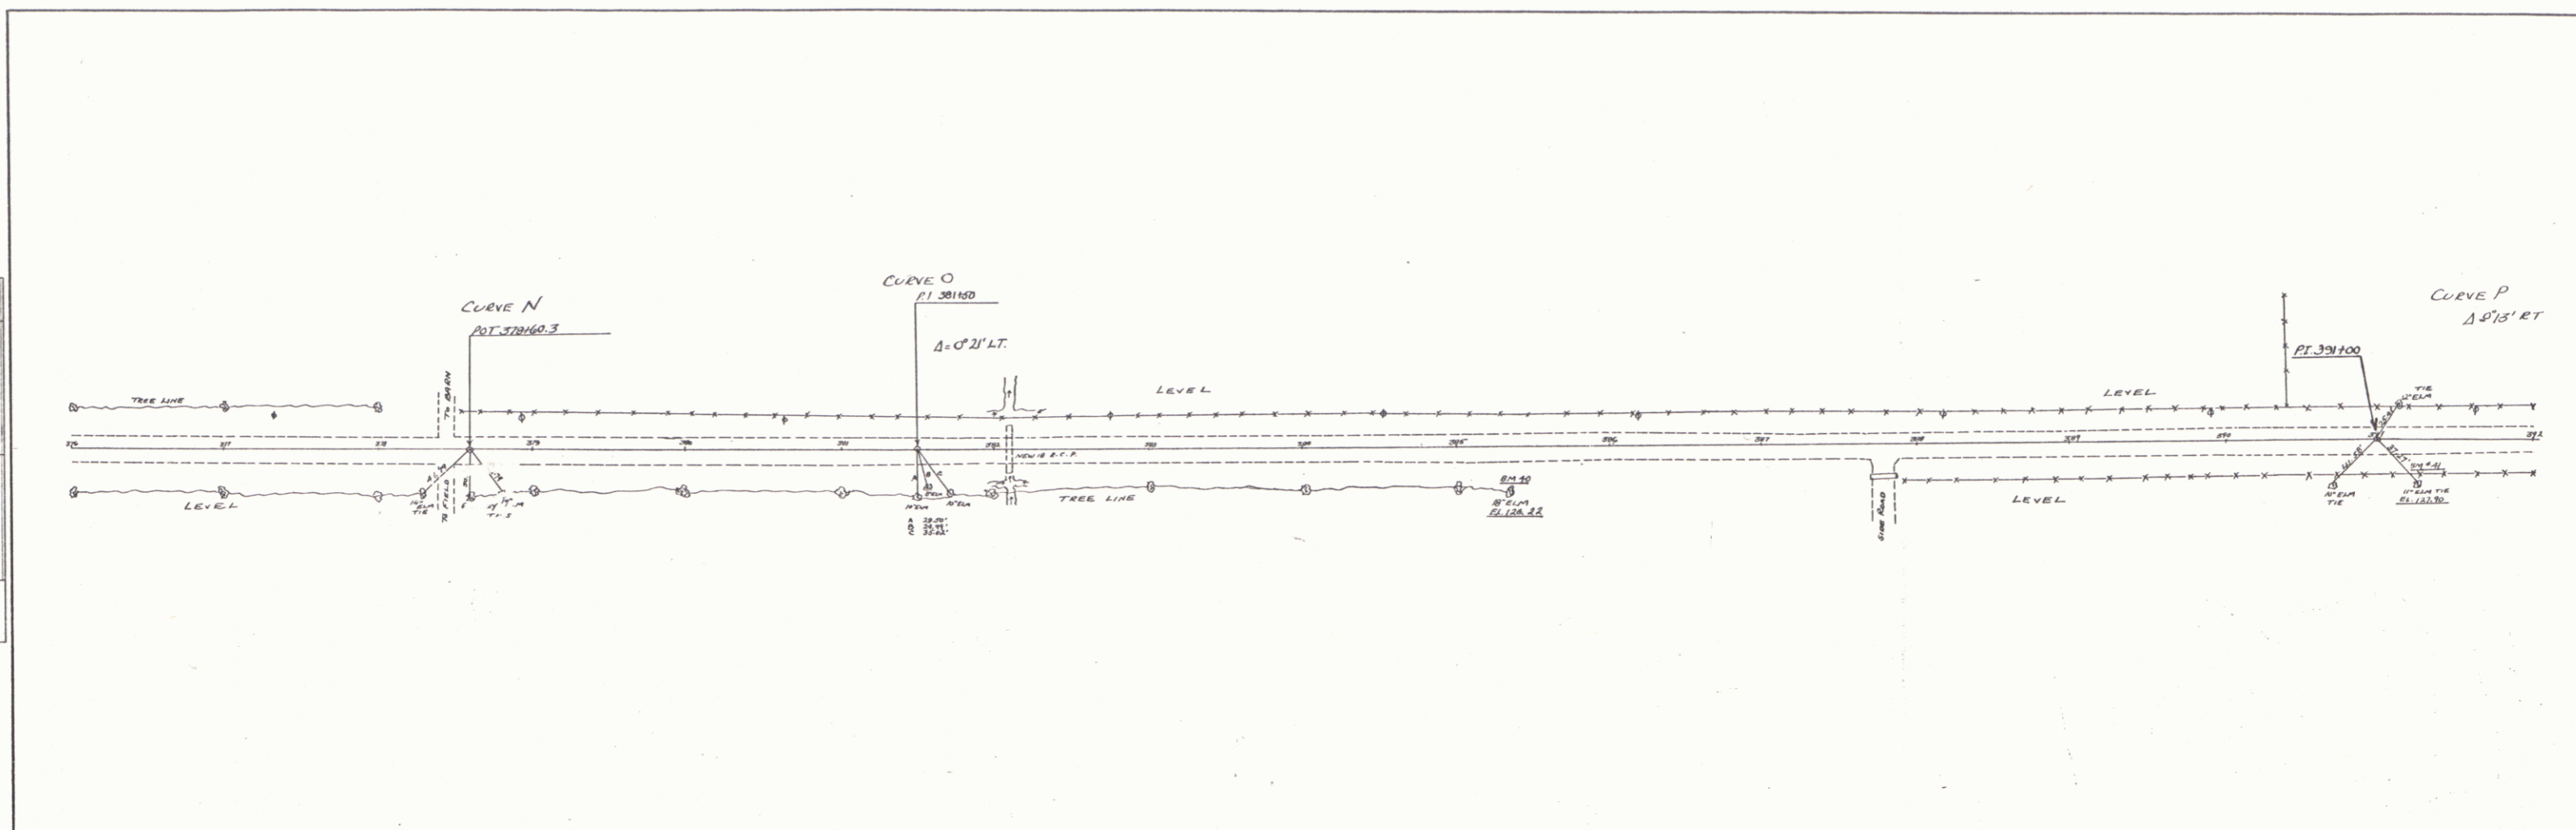


PLATE 1 - PLAN - PROFILE - P & R - S STANDARDS  
 KUFFEL & LUDWIG CO. NEW YORK

ANDREWS COMPANY POINT POINT  
 SHEET NO. 4