


DATE: 10/1/54
 BY: C.E. PLATT
 CHECKED: A. J. REICHERT
 PLAN
 DRAWING NO. 3152
 SHEET NO. 5
 PROJECT: ADOLPH CHIMNEY POINT ROAD
 SECTION: 100+00 TO 124+00
 SCALE: 1" = 40'

CURVE N
 PI. 355.141/6
 Δ = 0°33'

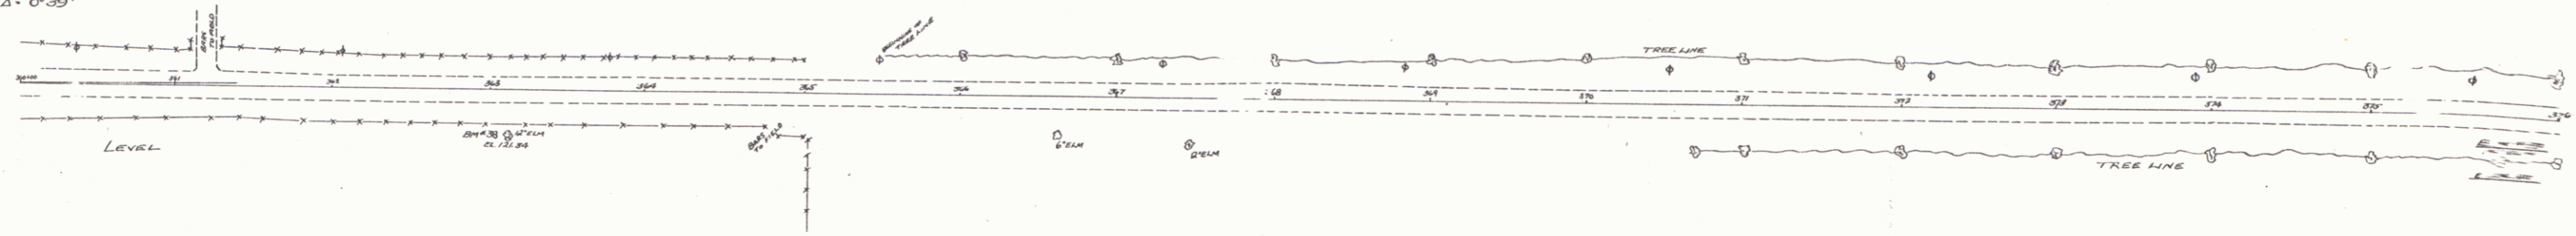

DATE: 10/1/54
 BY: C.E. PLATT
 CHECKED: A. J. REICHERT
 PROFILE
 DRAWING NO. 3152
 SHEET NO. 5
 PROJECT: ADOLPH CHIMNEY POINT ROAD
 SECTION: 100+00 TO 124+00
 SCALE: 1" = 40'

