

PLAN
 DRAWN BY: [Signature]
 CHECKED BY: [Signature]
 DATE: 10/23/09
 PROJECT: [Project Name]
 SHEET: 10

PROFILE
 DRAWN BY: [Signature]
 CHECKED BY: [Signature]
 DATE: 10/23/09
 PROJECT: [Project Name]
 SHEET: 10

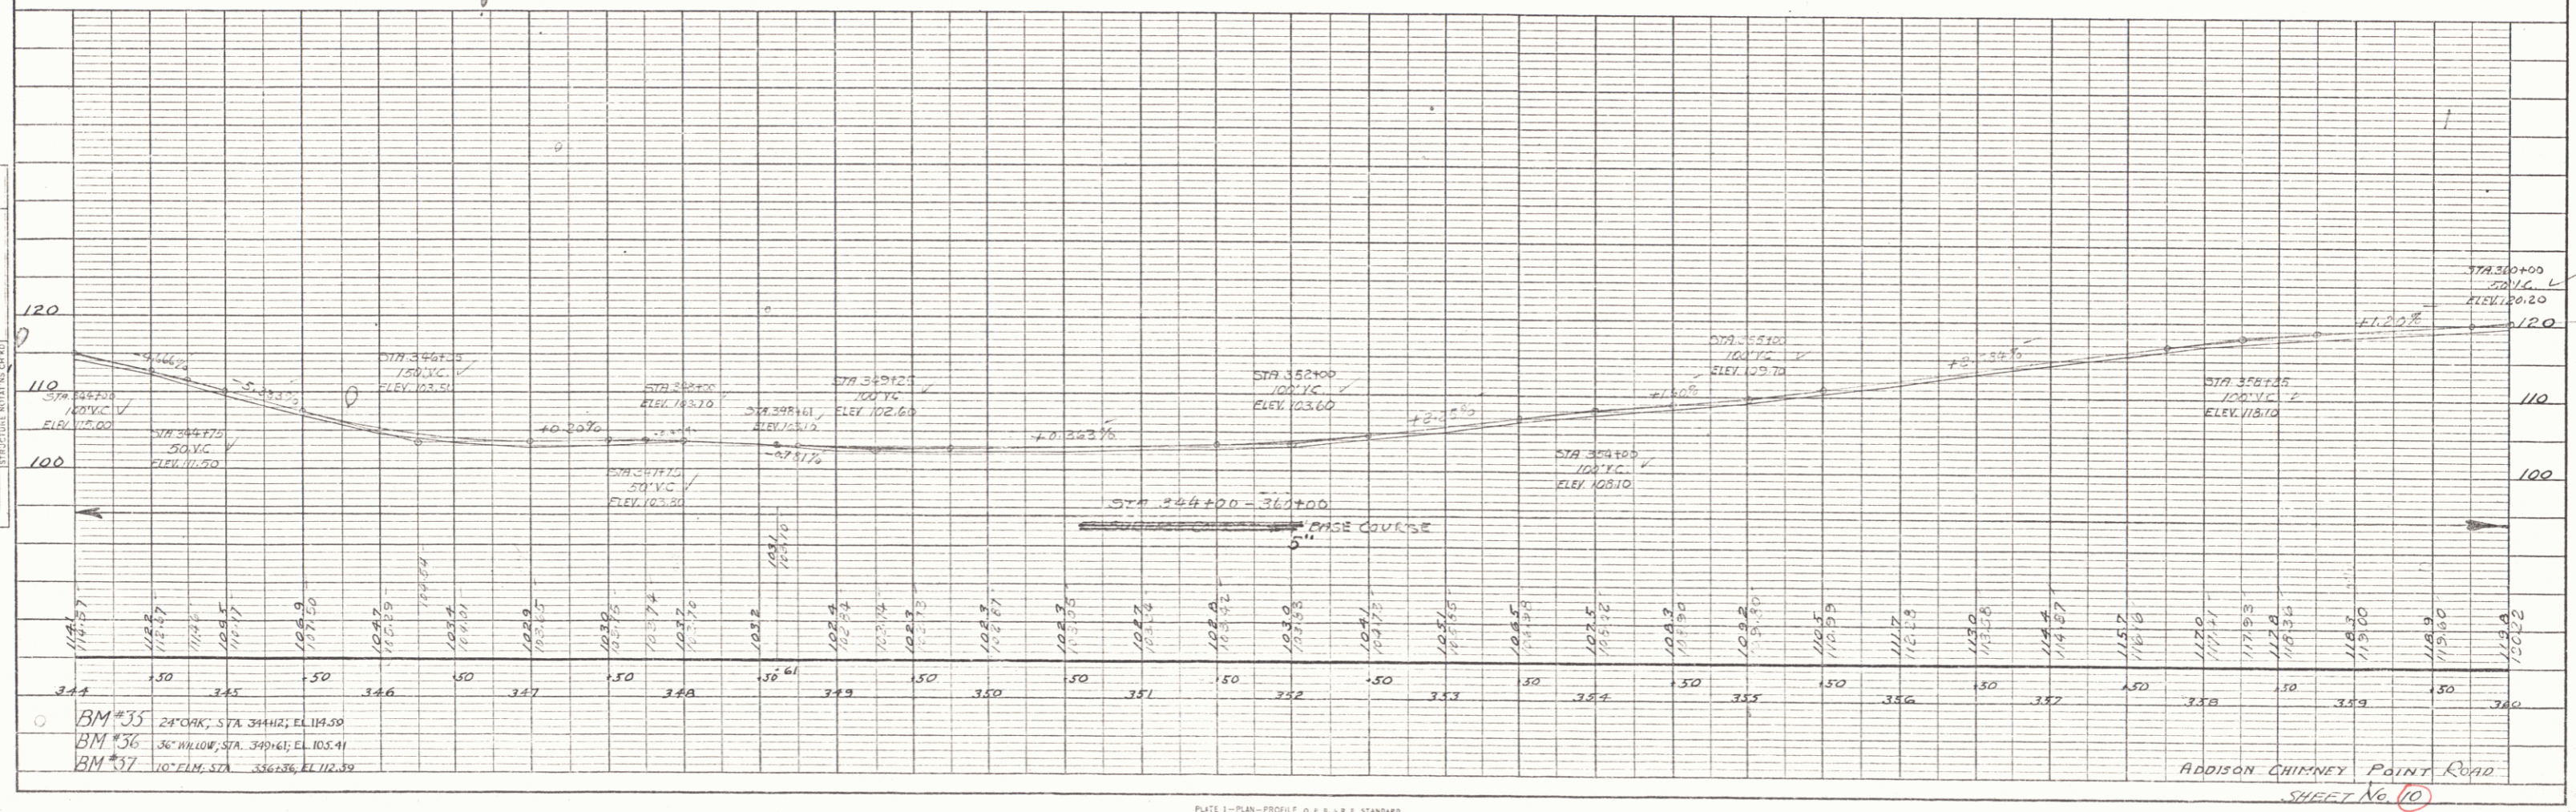
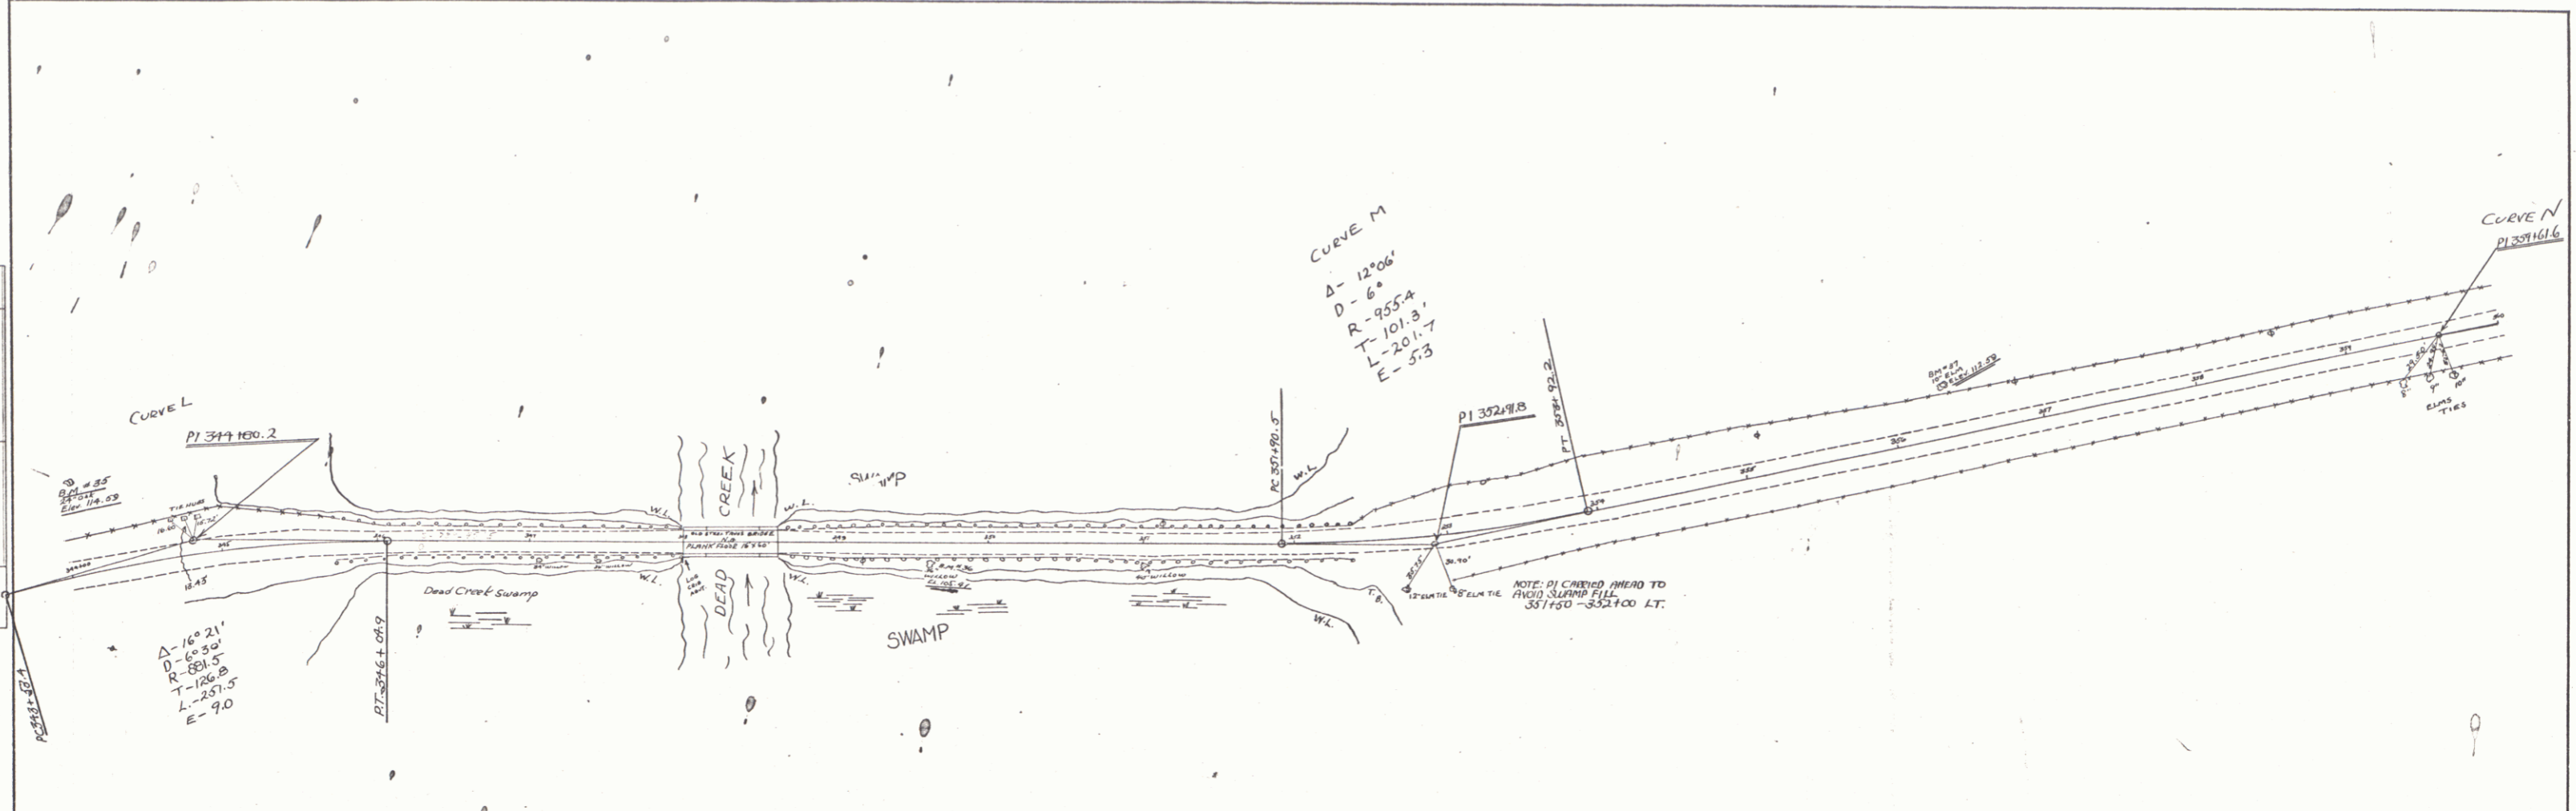


PLATE 1 - PLAN - PROFILE OF R.R. STANDARD
 MEYER & ELLER CO. NEW YORK

ADDISON CHIMNEY POINT ROAD
 SHEET No. 10