

PLAN
 DRAWN BY: []
 CHECKED BY: []
 DATE: []

PROFILE
 DRAWN BY: []
 CHECKED BY: []
 DATE: []

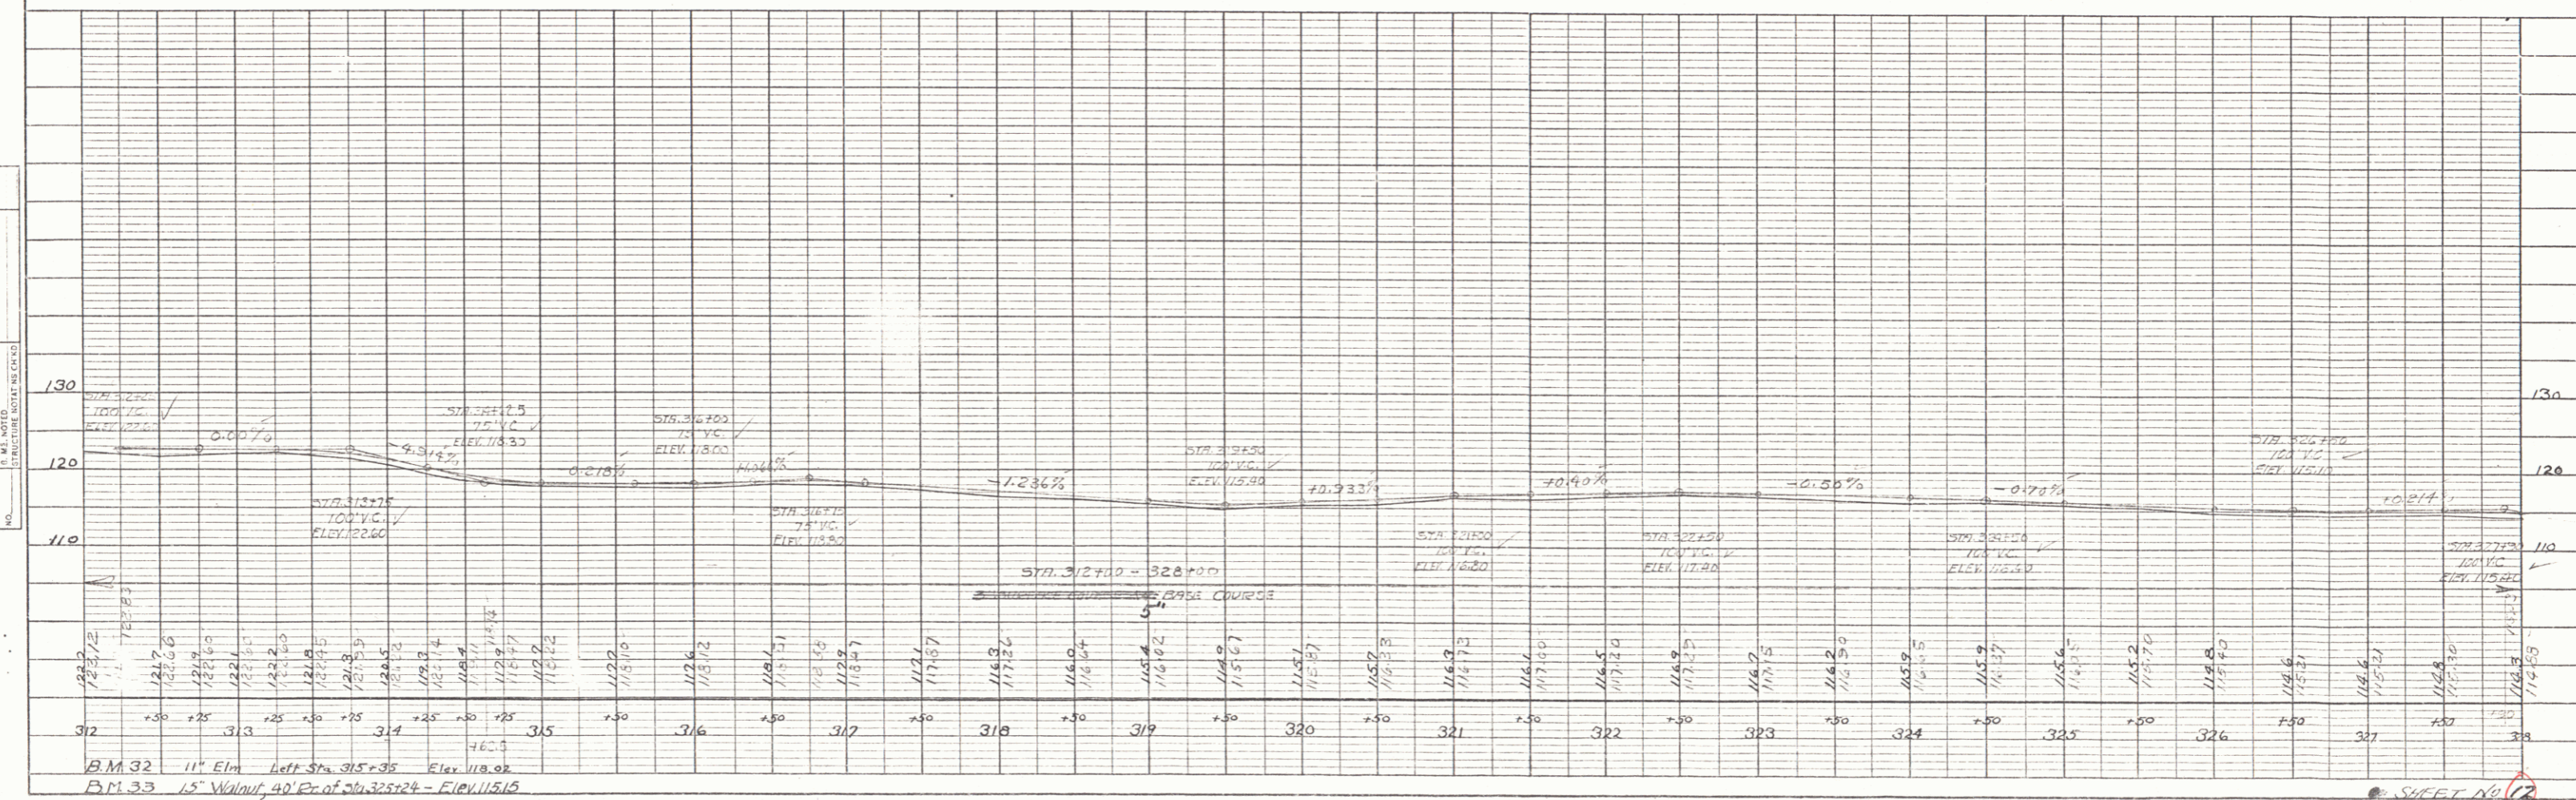
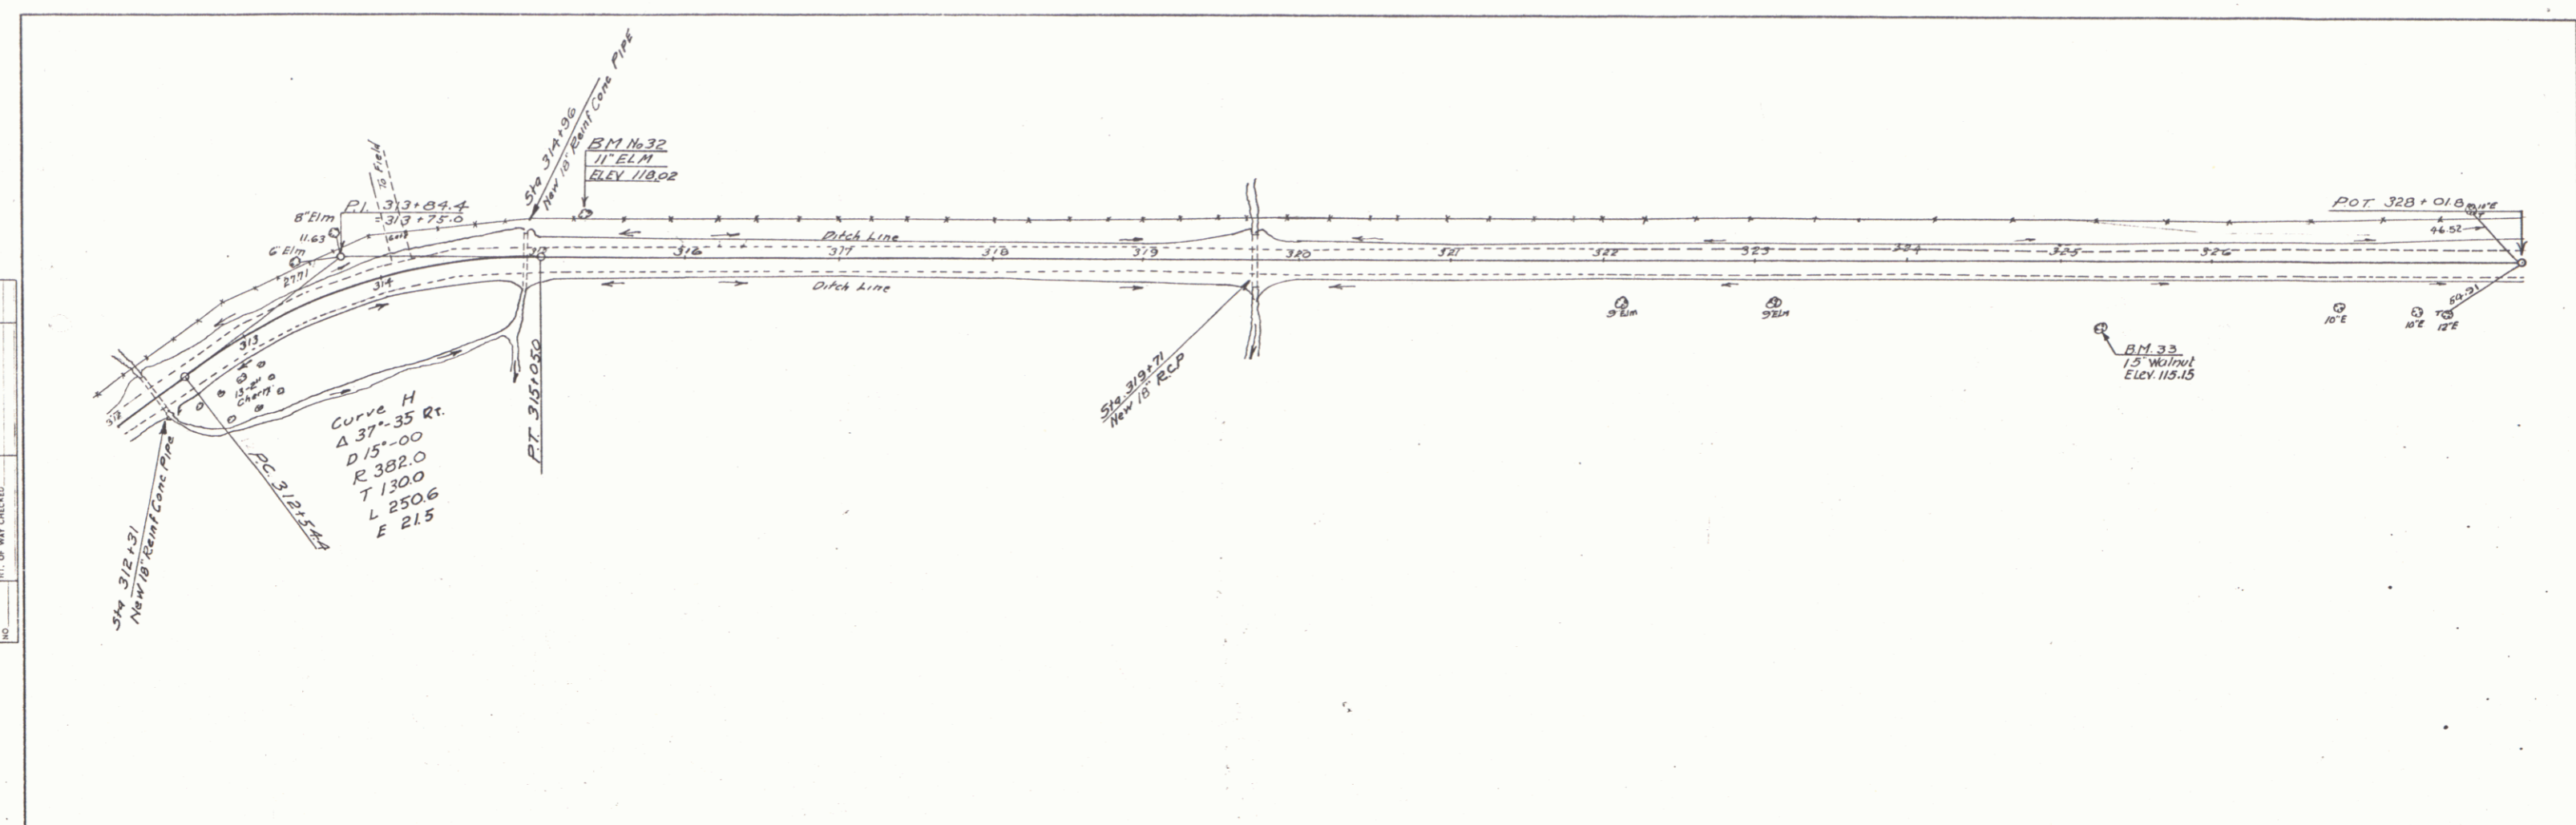


PLATE 1 - PLAN - PROFILE OF P.A.R. & ST. 154945
 REUTEL & ESSER CO. NEW YORK

ADOLPH - CHIMNEY POINT ROAD
 SHEET No. 12