


PLAN  
 DRAWN BY S.E. FLORENZ  
 CHECKED BY S.E. FLORENZ  
 DATE 1/1/1930

PROFILE  
 DRAWN BY S.E. FLORENZ  
 CHECKED BY S.E. FLORENZ  
 DATE 1/1/1930




TOWN OF ADDISON  
 Project MM 0320-0604  
 Pin # 00R522  
 Route VT 17  
 Date 1/1/1930

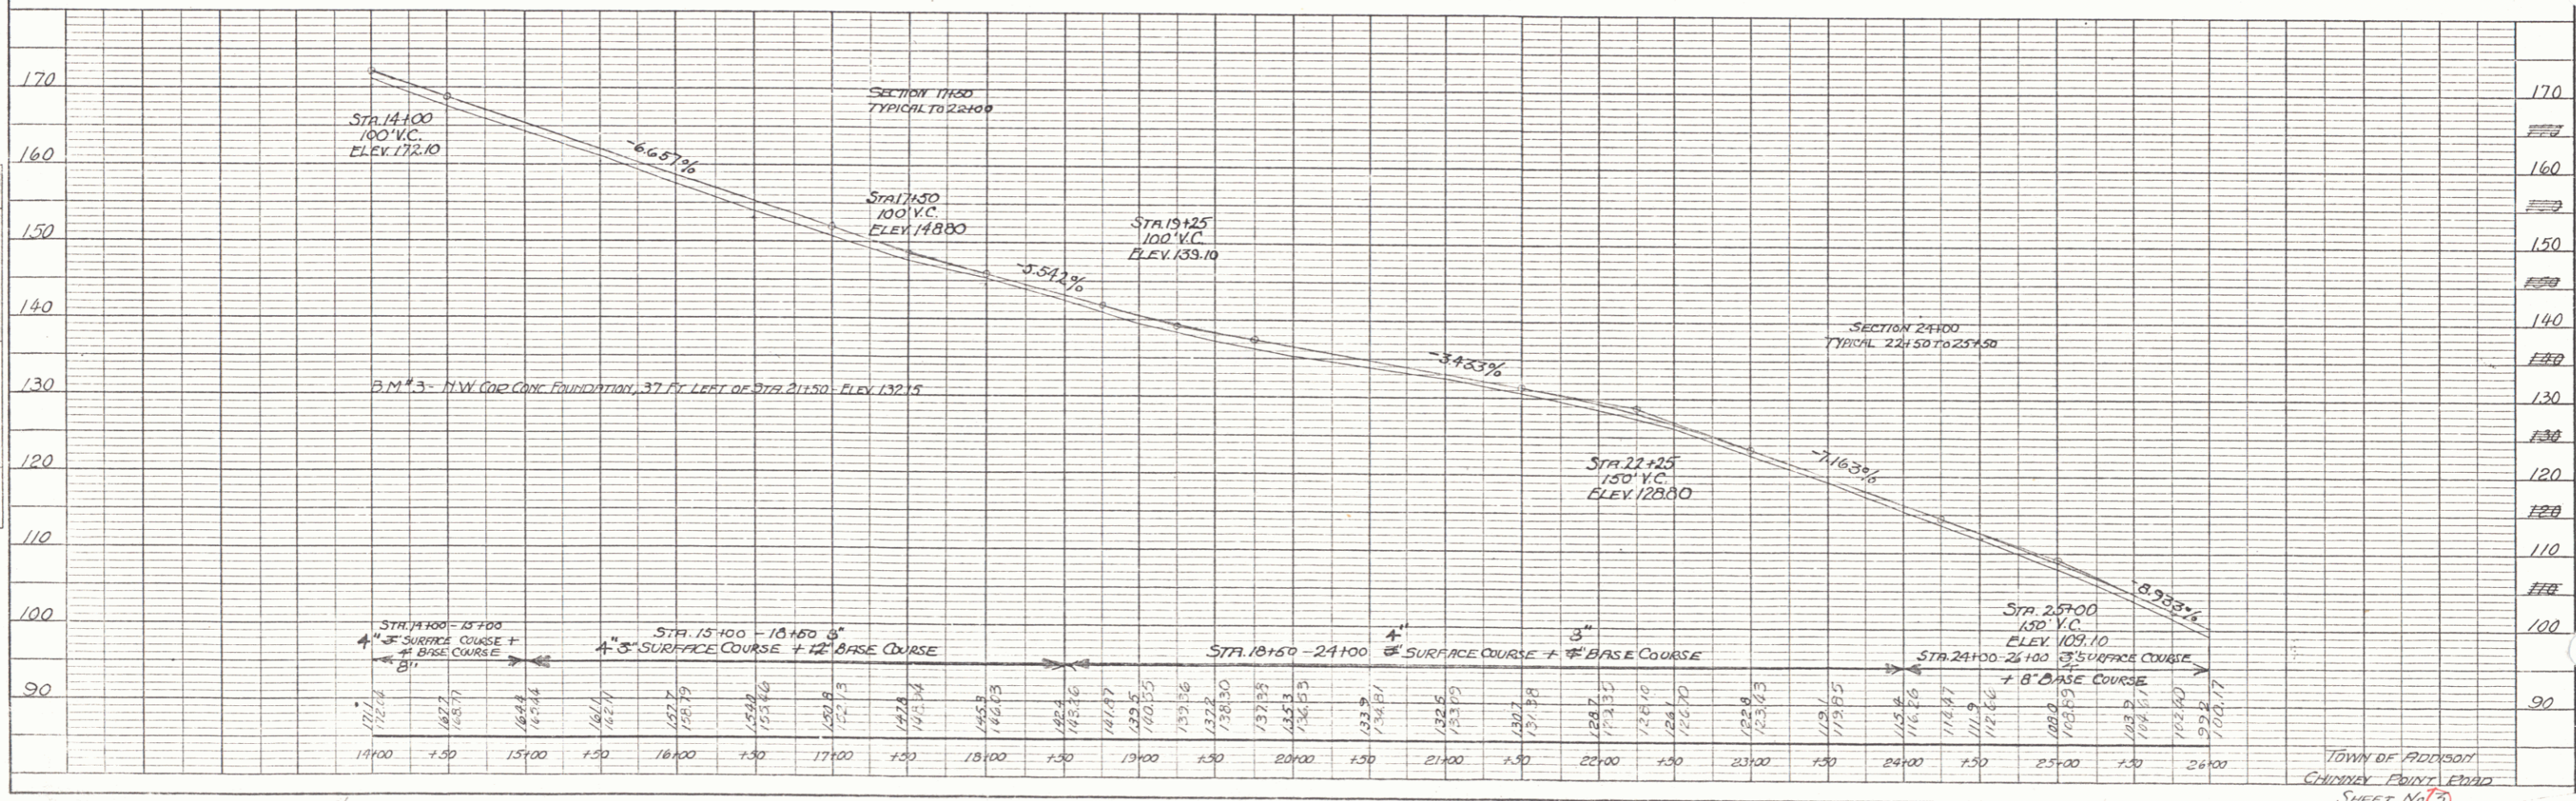



PLAN  
 DATE: 1/23/24  
 DRAWN BY: [Signature]  
 CHECKED BY: [Signature]  
 PROJECT: [Project Name]  
 SHEET NO. 3

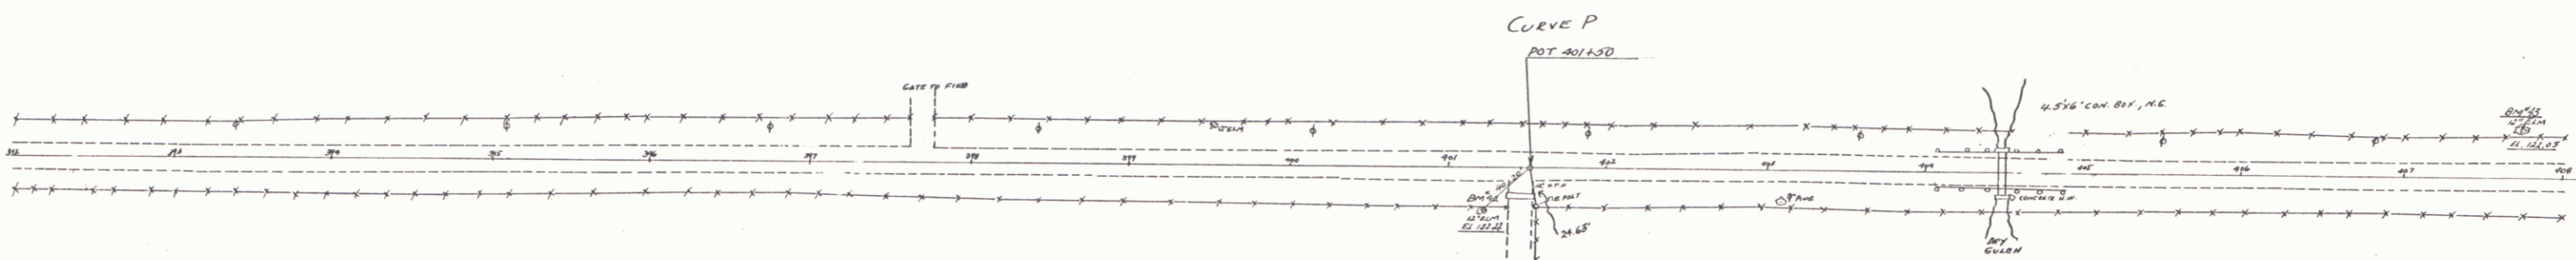

PROFILE  
 DATE: 1/23/24  
 DRAWN BY: [Signature]  
 CHECKED BY: [Signature]  
 PROJECT: [Project Name]  
 SHEET NO. 3

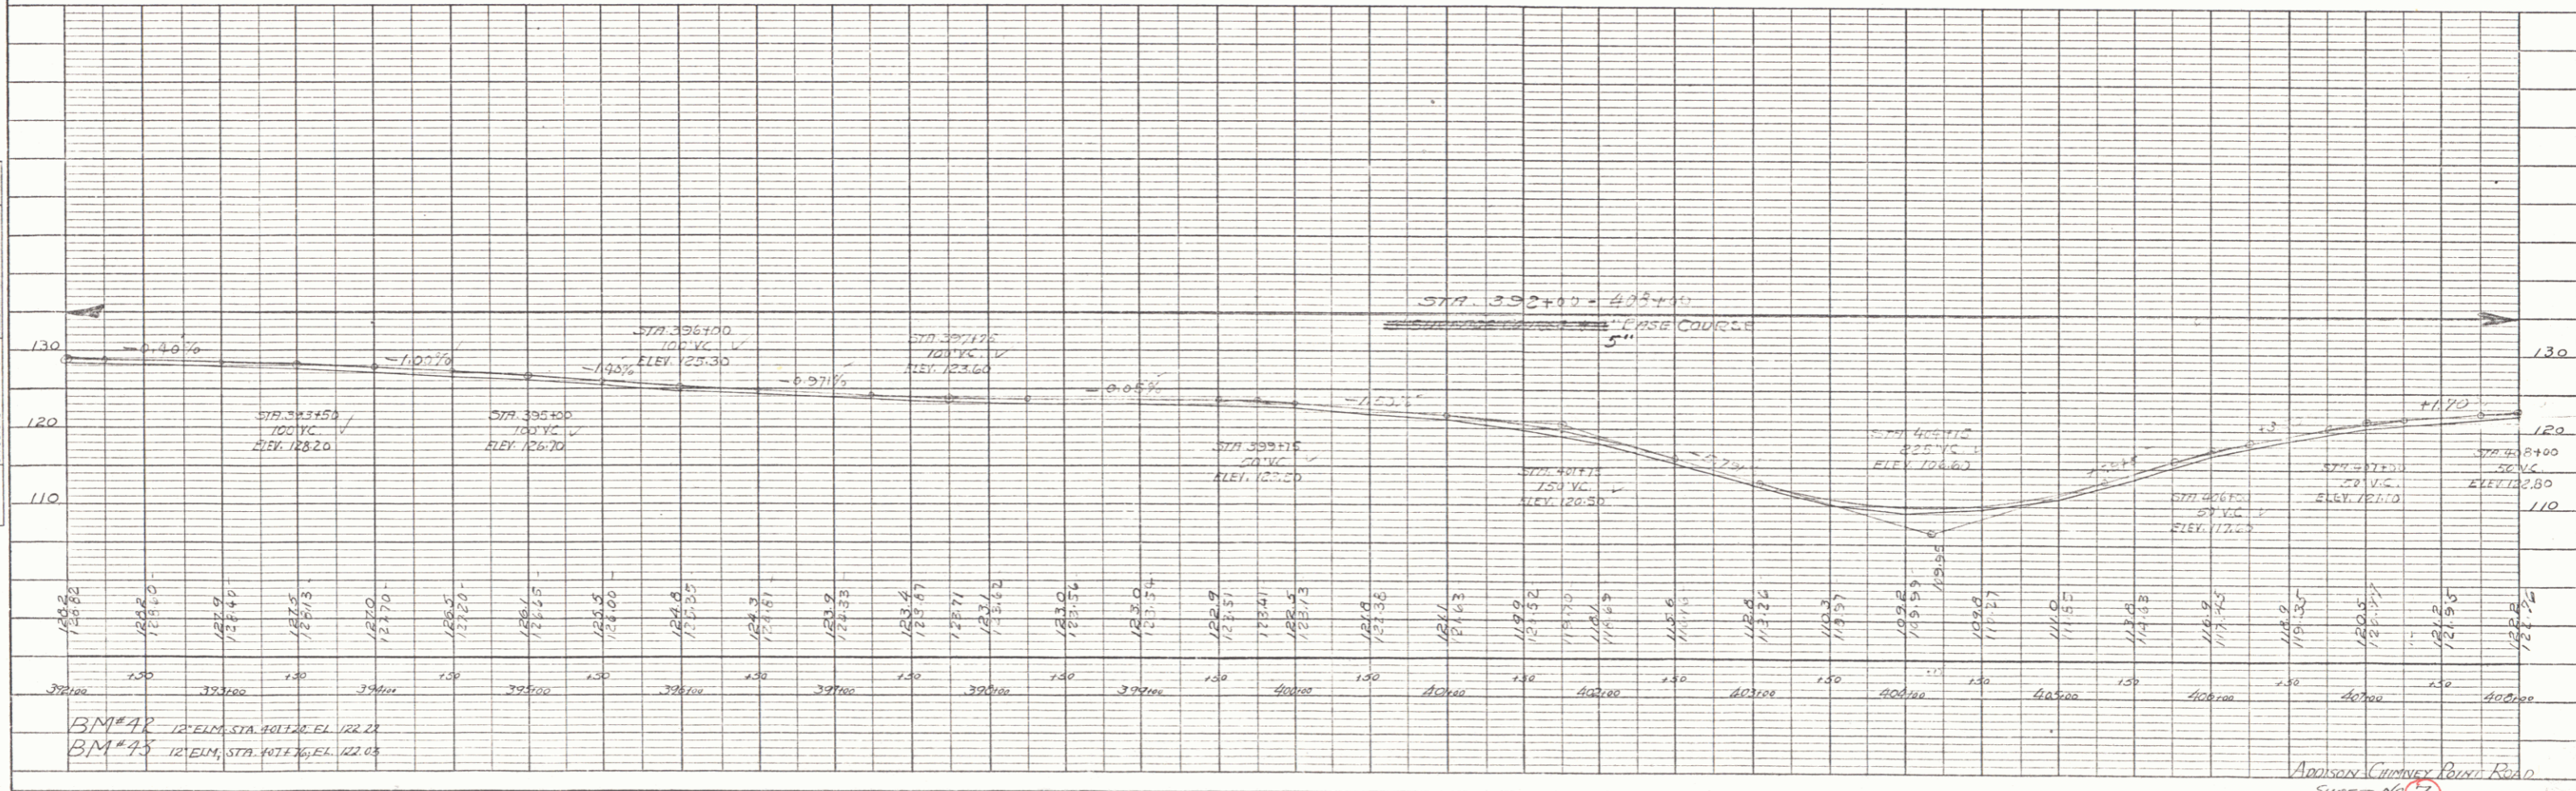


PLATE 1 - PLAN - PROFILE OF P. & R. STANDARDS  
 KELP & CO. INC. NEW YORK

ADDISON CHIMNEY POINT ROAD  
 SHEET NO. 3

DATE: 12/22/22  
 PLAN  
 DRAWN: J. ALBERT  
 CHECKED: J. ALBERT  
 IN CHARGE: J. ALBERT  
 NO. 10

DATE: 12/22/22  
 PROFILE  
 DRAWN: J. ALBERT  
 CHECKED: J. ALBERT  
 IN CHARGE: J. ALBERT  
 NO. 10



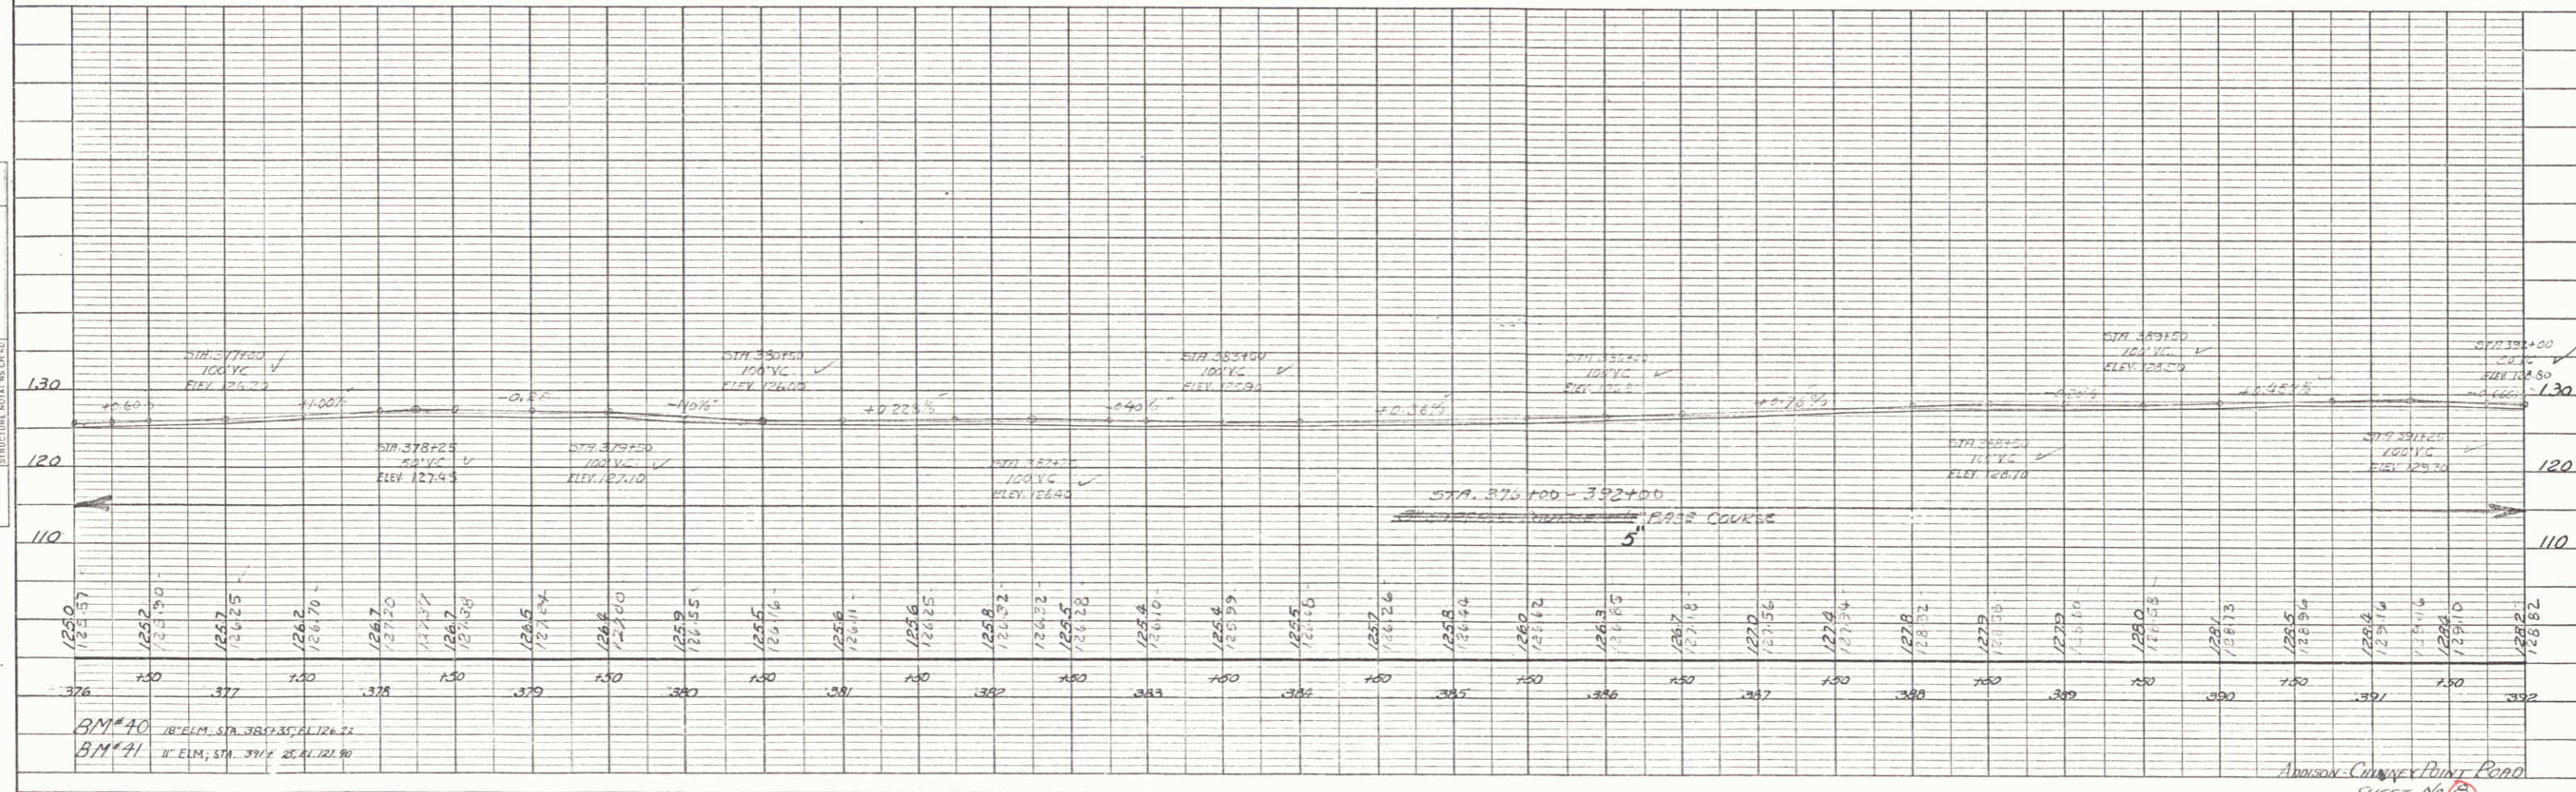


PLATE 1 - PLAN - PROFILE - P & A & E STANDARD  
 KUFFEL & LUDWIG CO. NEW YORK


ANDREWS COMPANY POINT  
 SHEET NO. 4

DATE: 1/27/48  
 BY: C.E. PLATT  
 CHECKED: A. J. REICHERT  
 PLAN  
 DRAWING NO. 3152  
 SHEET NO. 5  
 PROJECT: ADOLPH CHIMNEY POINT ROAD  
 LOCATION: CHIMNEY POINT, N.Y.  
 SCALE: AS SHOWN  
 DATE OF SURVEY: 1/27/48  
 DATE OF PLOTTING: 1/27/48  
 CHECKED BY: A. J. REICHERT  
 DATE OF CHECK: 1/27/48  
 NO. OF SHEETS: 5  
 SHEET NO.: 5

CURVE N  
 PI. 355+41.6  
 Δ = 97.33°

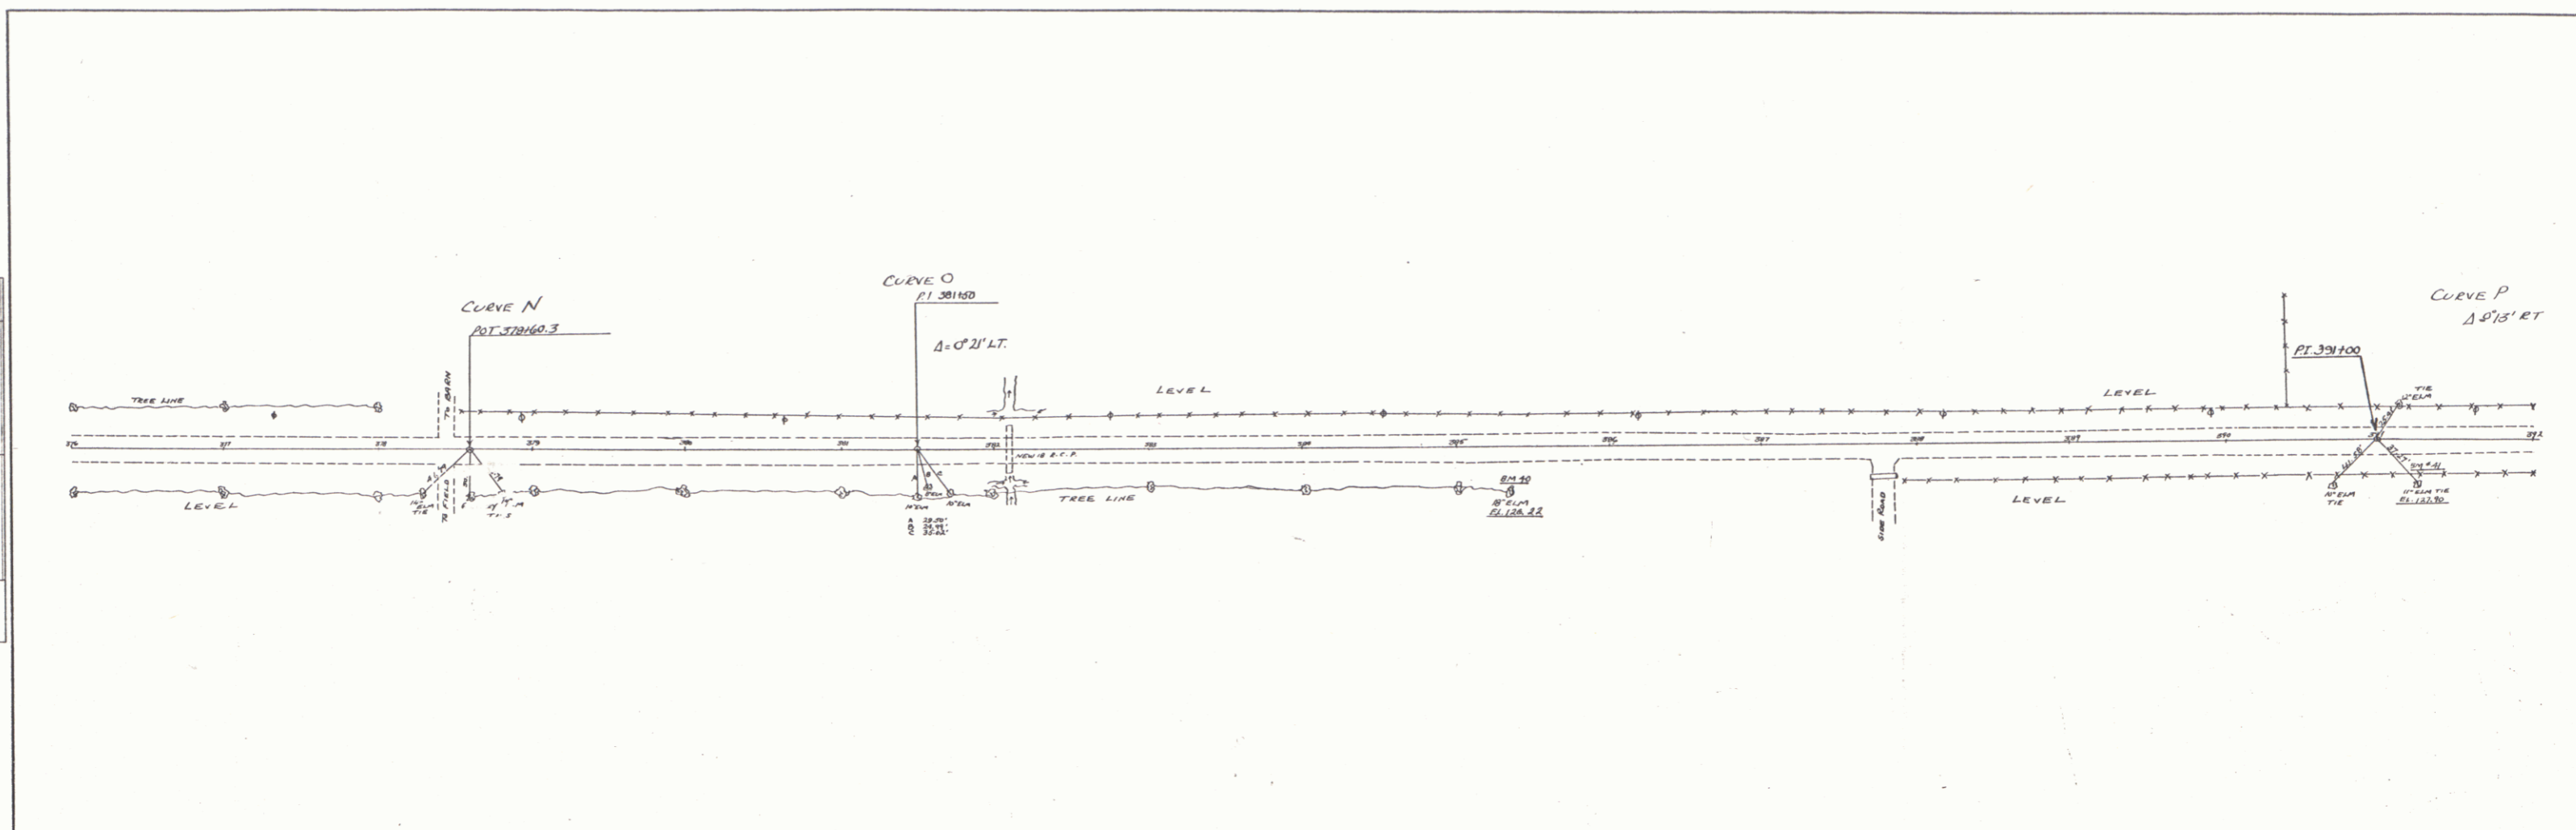
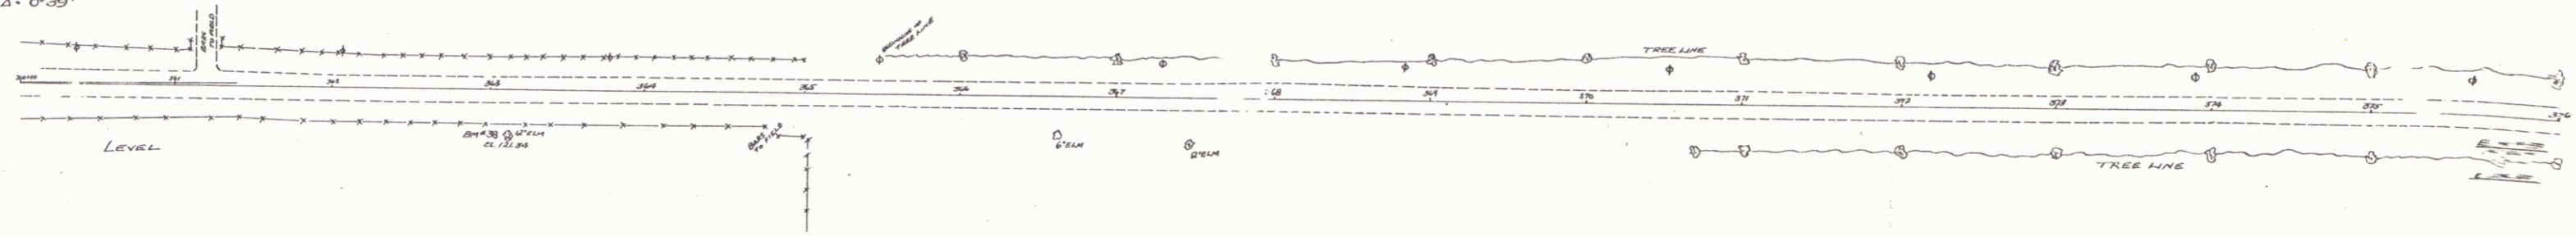


DATE: 1/27/48  
 BY: C.E. PLATT  
 CHECKED: A. J. REICHERT  
 PROFILE  
 DRAWING NO. 3152  
 SHEET NO. 5  
 PROJECT: ADOLPH CHIMNEY POINT ROAD  
 LOCATION: CHIMNEY POINT, N.Y.  
 SCALE: AS SHOWN  
 DATE OF SURVEY: 1/27/48  
 DATE OF PLOTTING: 1/27/48  
 CHECKED BY: A. J. REICHERT  
 DATE OF CHECK: 1/27/48  
 NO. OF SHEETS: 5  
 SHEET NO.: 5

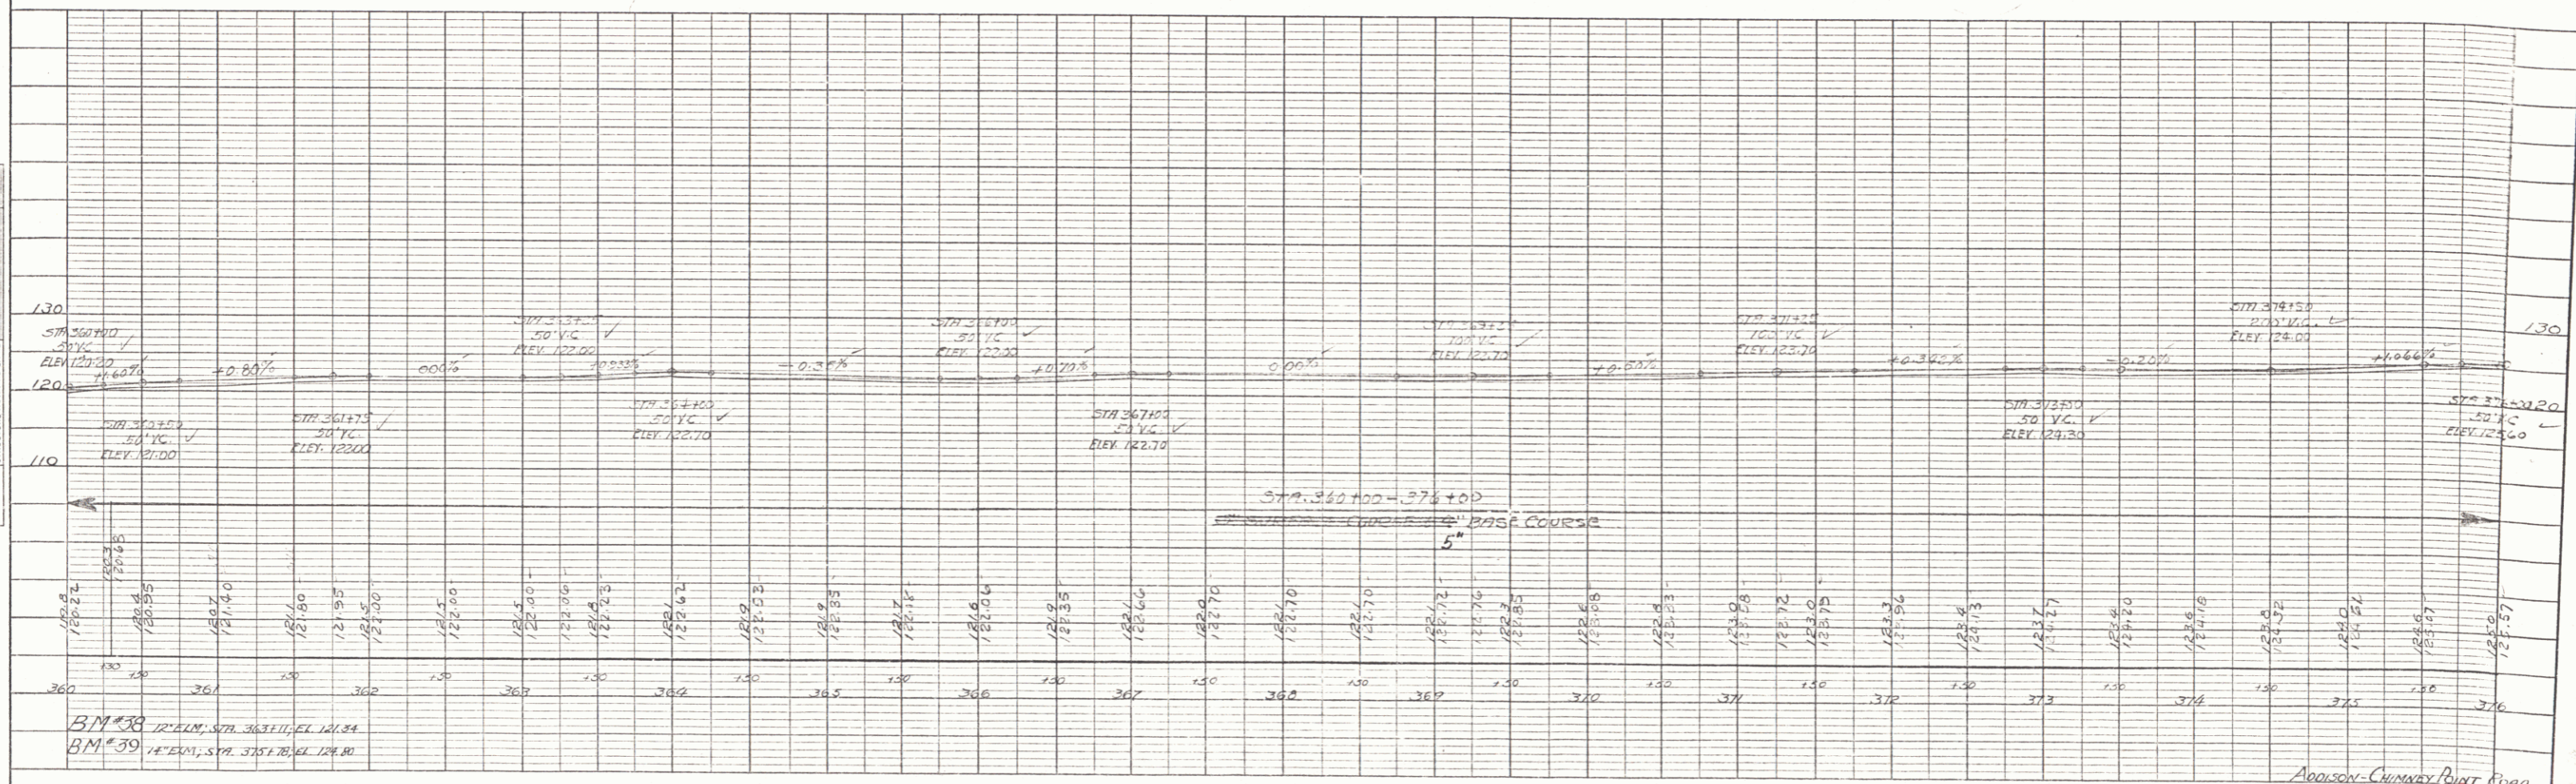

PLAN  
 DRAWN BY: [Signature]  
 CHECKED BY: [Signature]  
 DATE: 10/22/09  
 PROJECT: [Project Name]  
 SHEET NO.: 10

PROFILE  
 DRAWN BY: [Signature]  
 CHECKED BY: [Signature]  
 DATE: 10/22/09  
 PROJECT: [Project Name]  
 SHEET NO.: 10

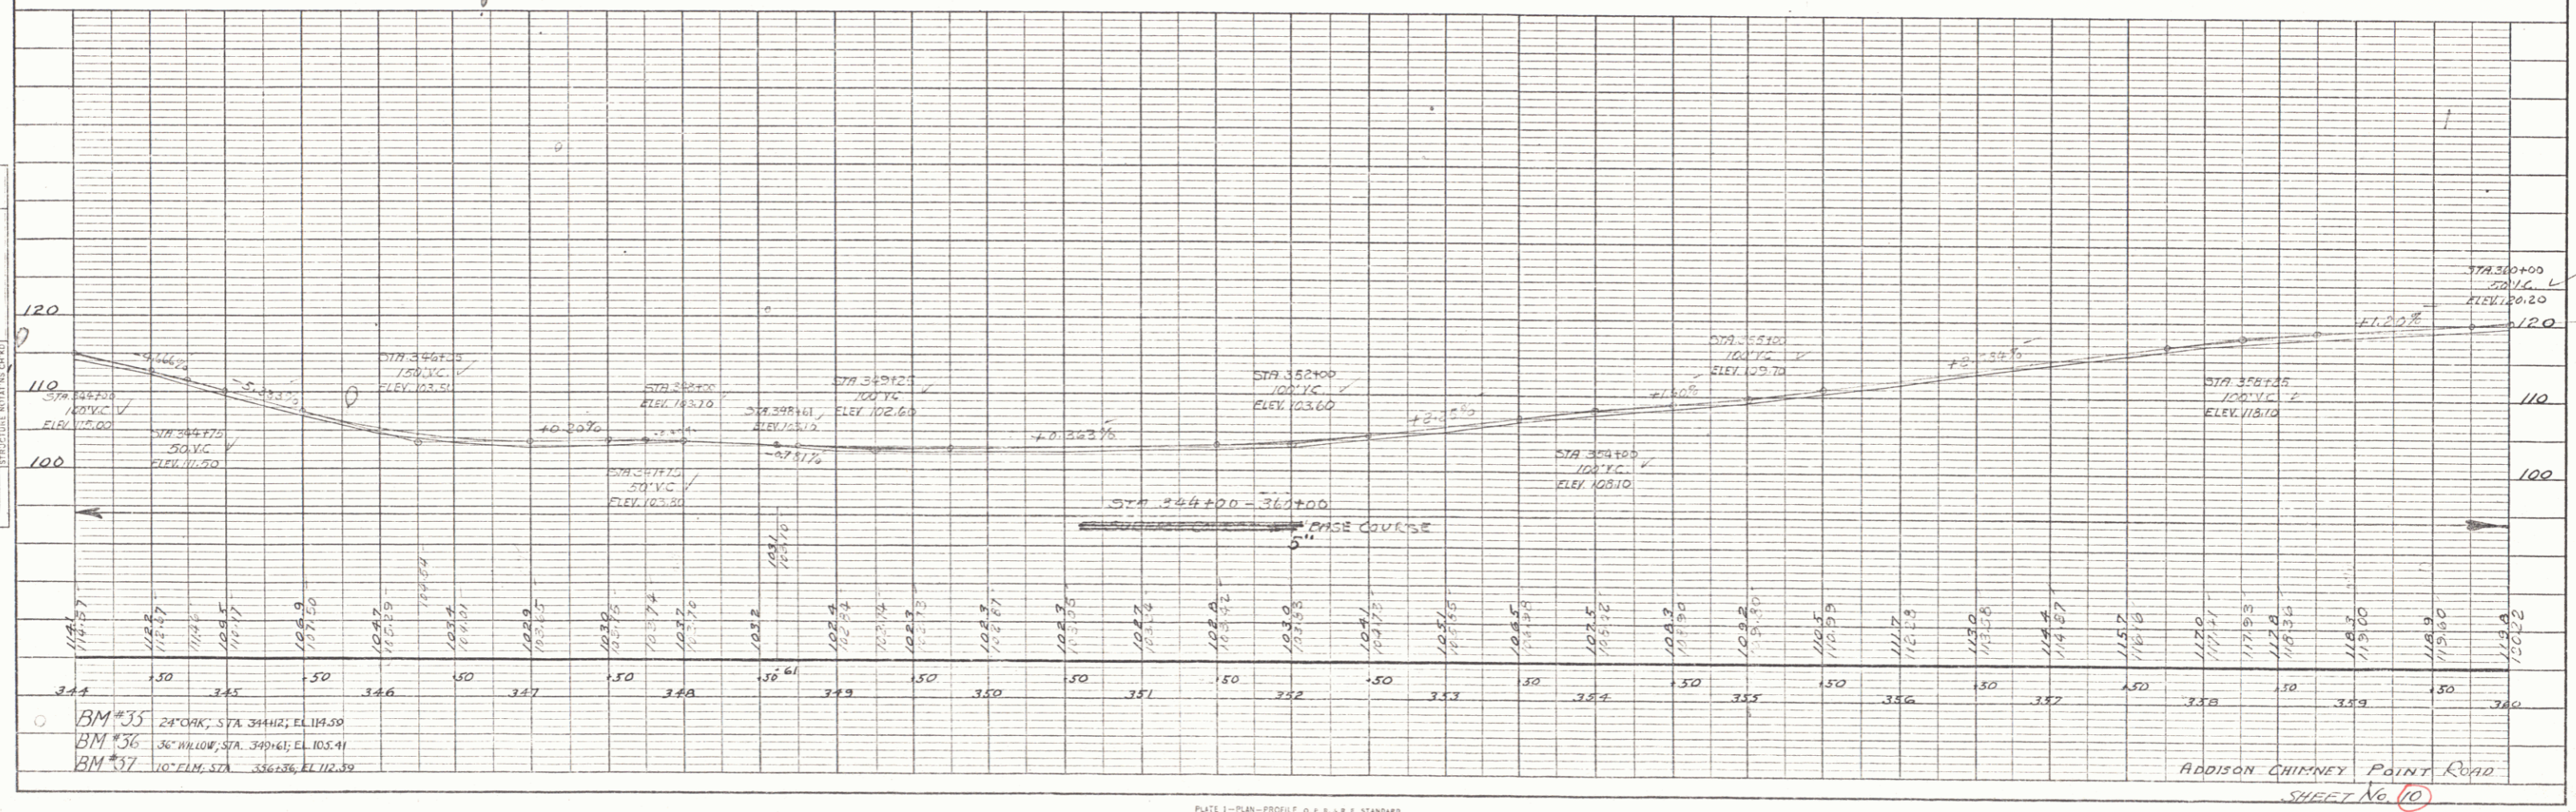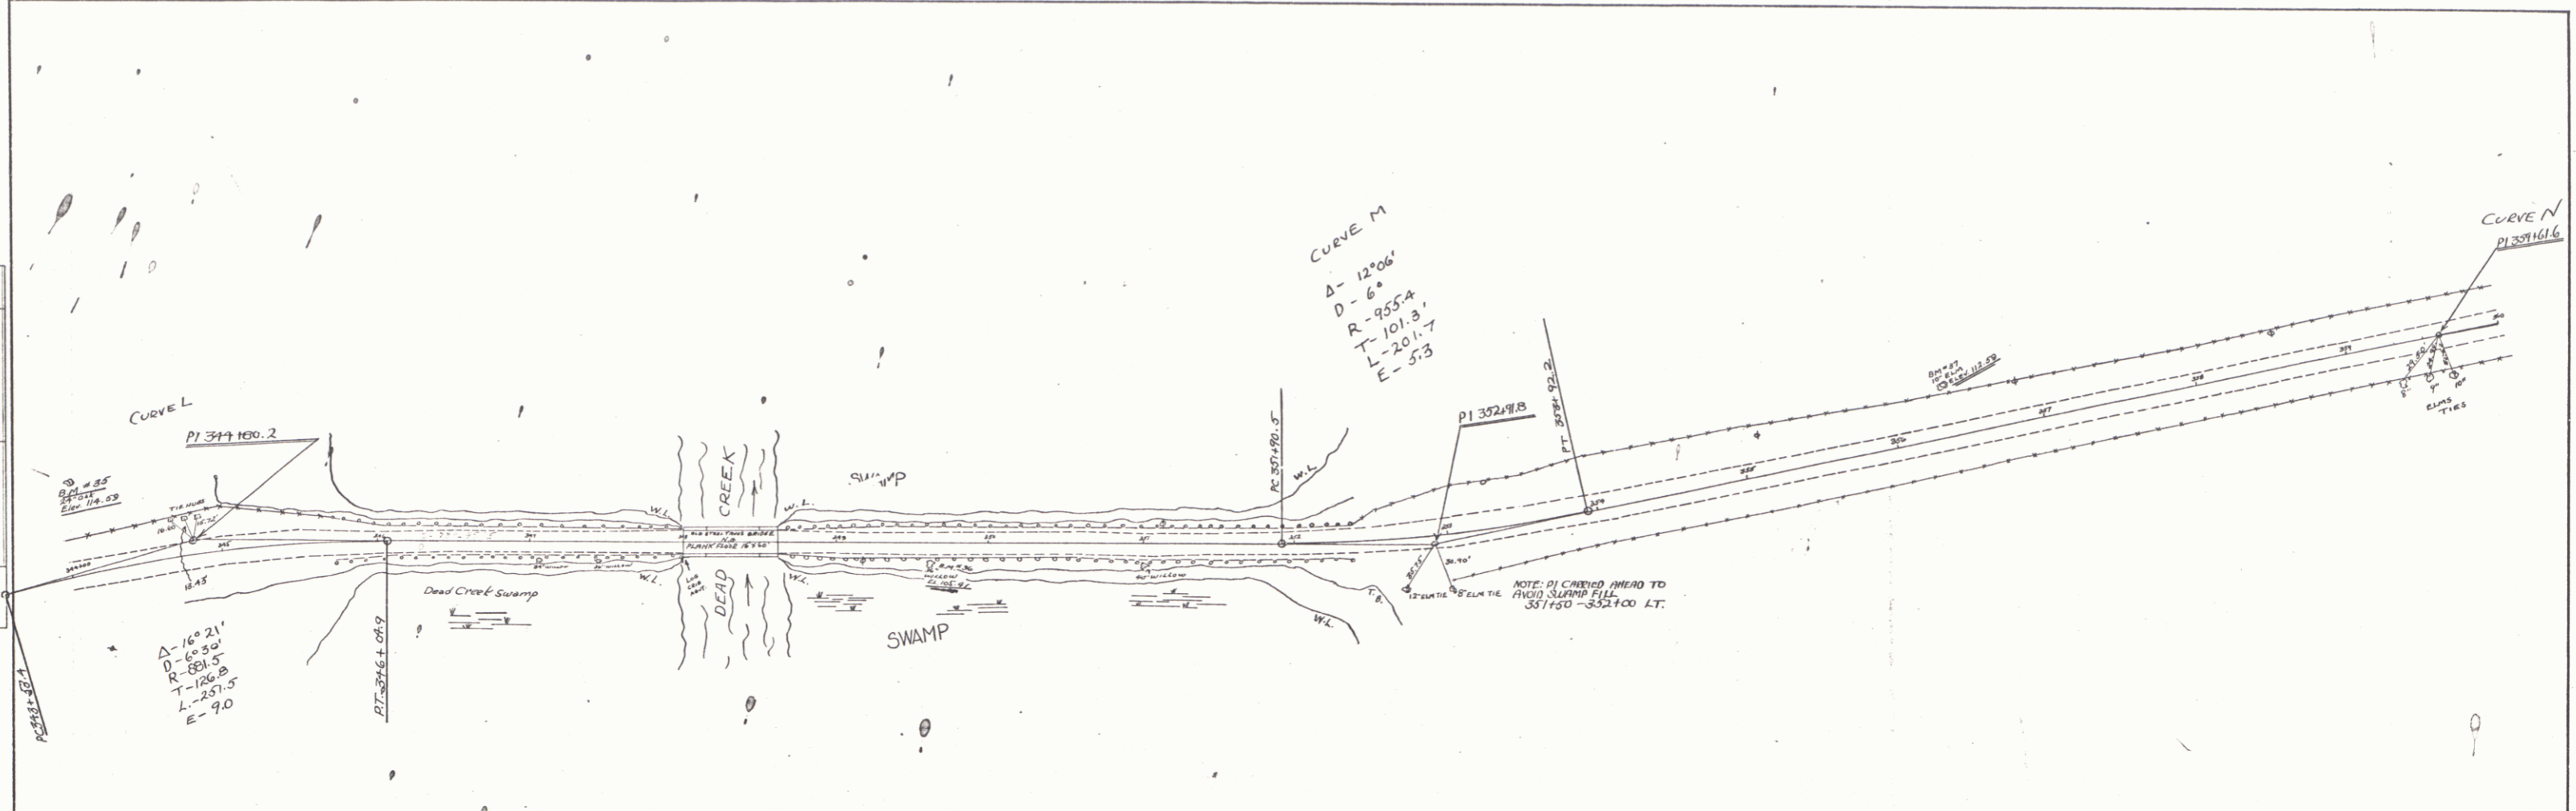



PLAN  
 DRAWN BY: [ ]  
 CHECKED BY: [ ]  
 DATE: [ ]

PROFILE  
 DRAWN BY: [ ]  
 CHECKED BY: [ ]  
 DATE: [ ]




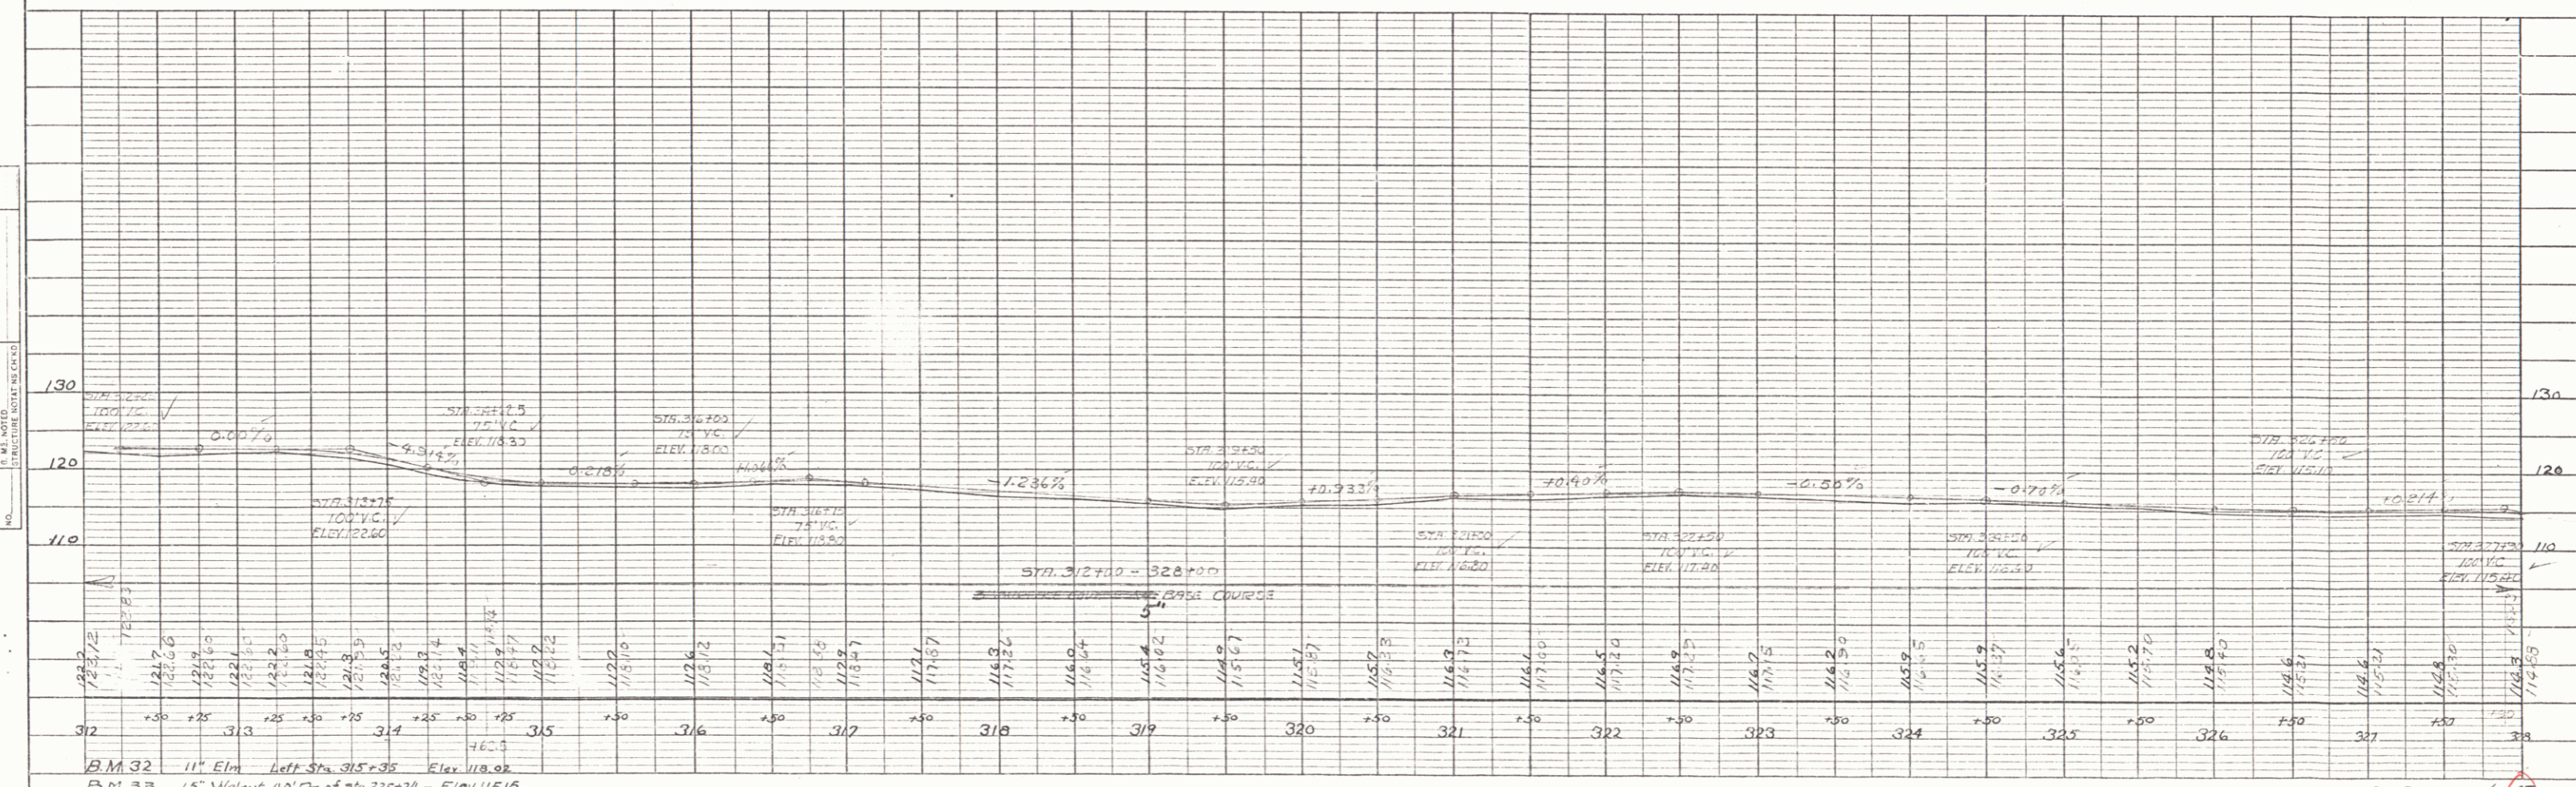


PLATE 1 - PLAN - PROFILE OF P.A.R. & ST. 154940  
 REUTEL & ESSER CO. NEW YORK

SHEET No. 12  
 ADAMS - CHURCHY BUNK ROAD

PLAN  
 DRAWN BY  
 C. E. FARRINGTON  
 E. FARRINGTON  
 DATE  
 MAY 1929  
 CHECKED BY  
 E. FARRINGTON  
 NO. OF WAY CHECKED

PROFILE  
 DRAWN BY  
 C. E. FARRINGTON  
 E. FARRINGTON  
 DATE  
 MAY 1929  
 CHECKED BY  
 E. FARRINGTON  
 NO. OF WAY CHECKED

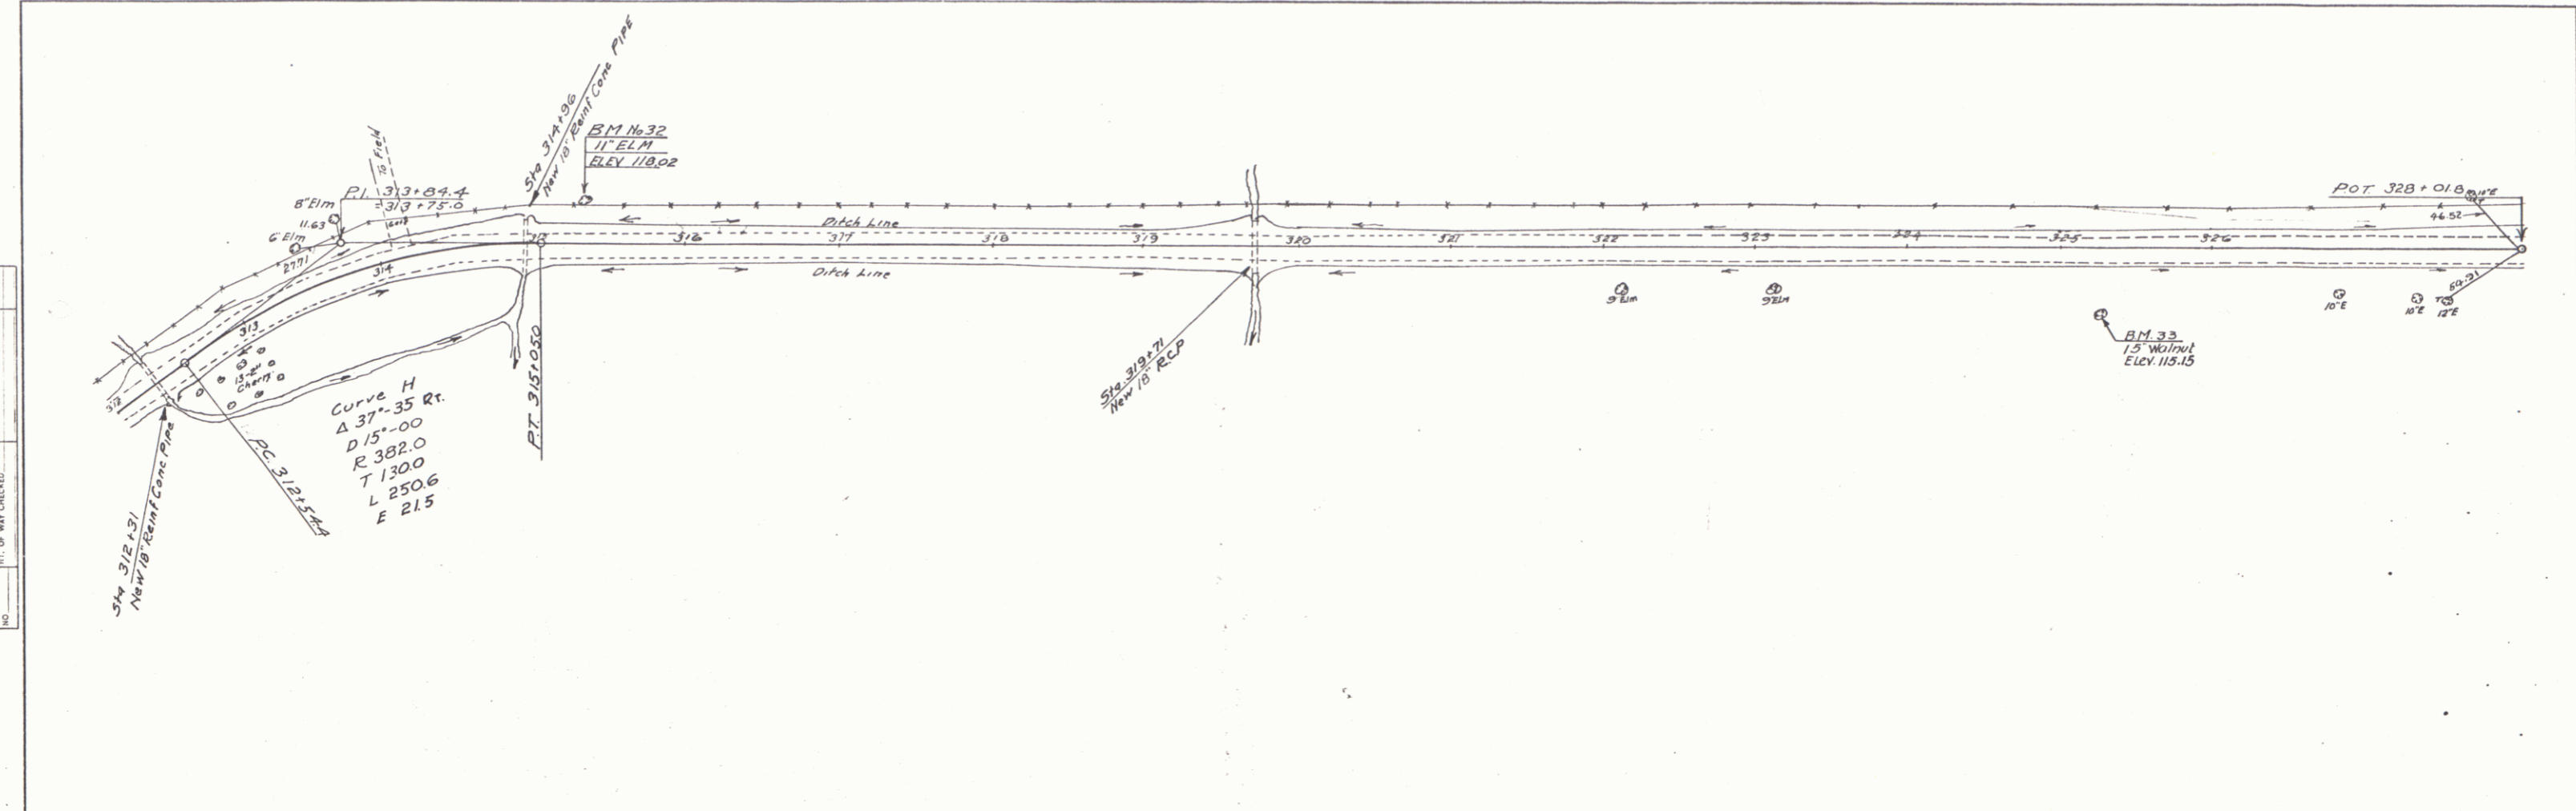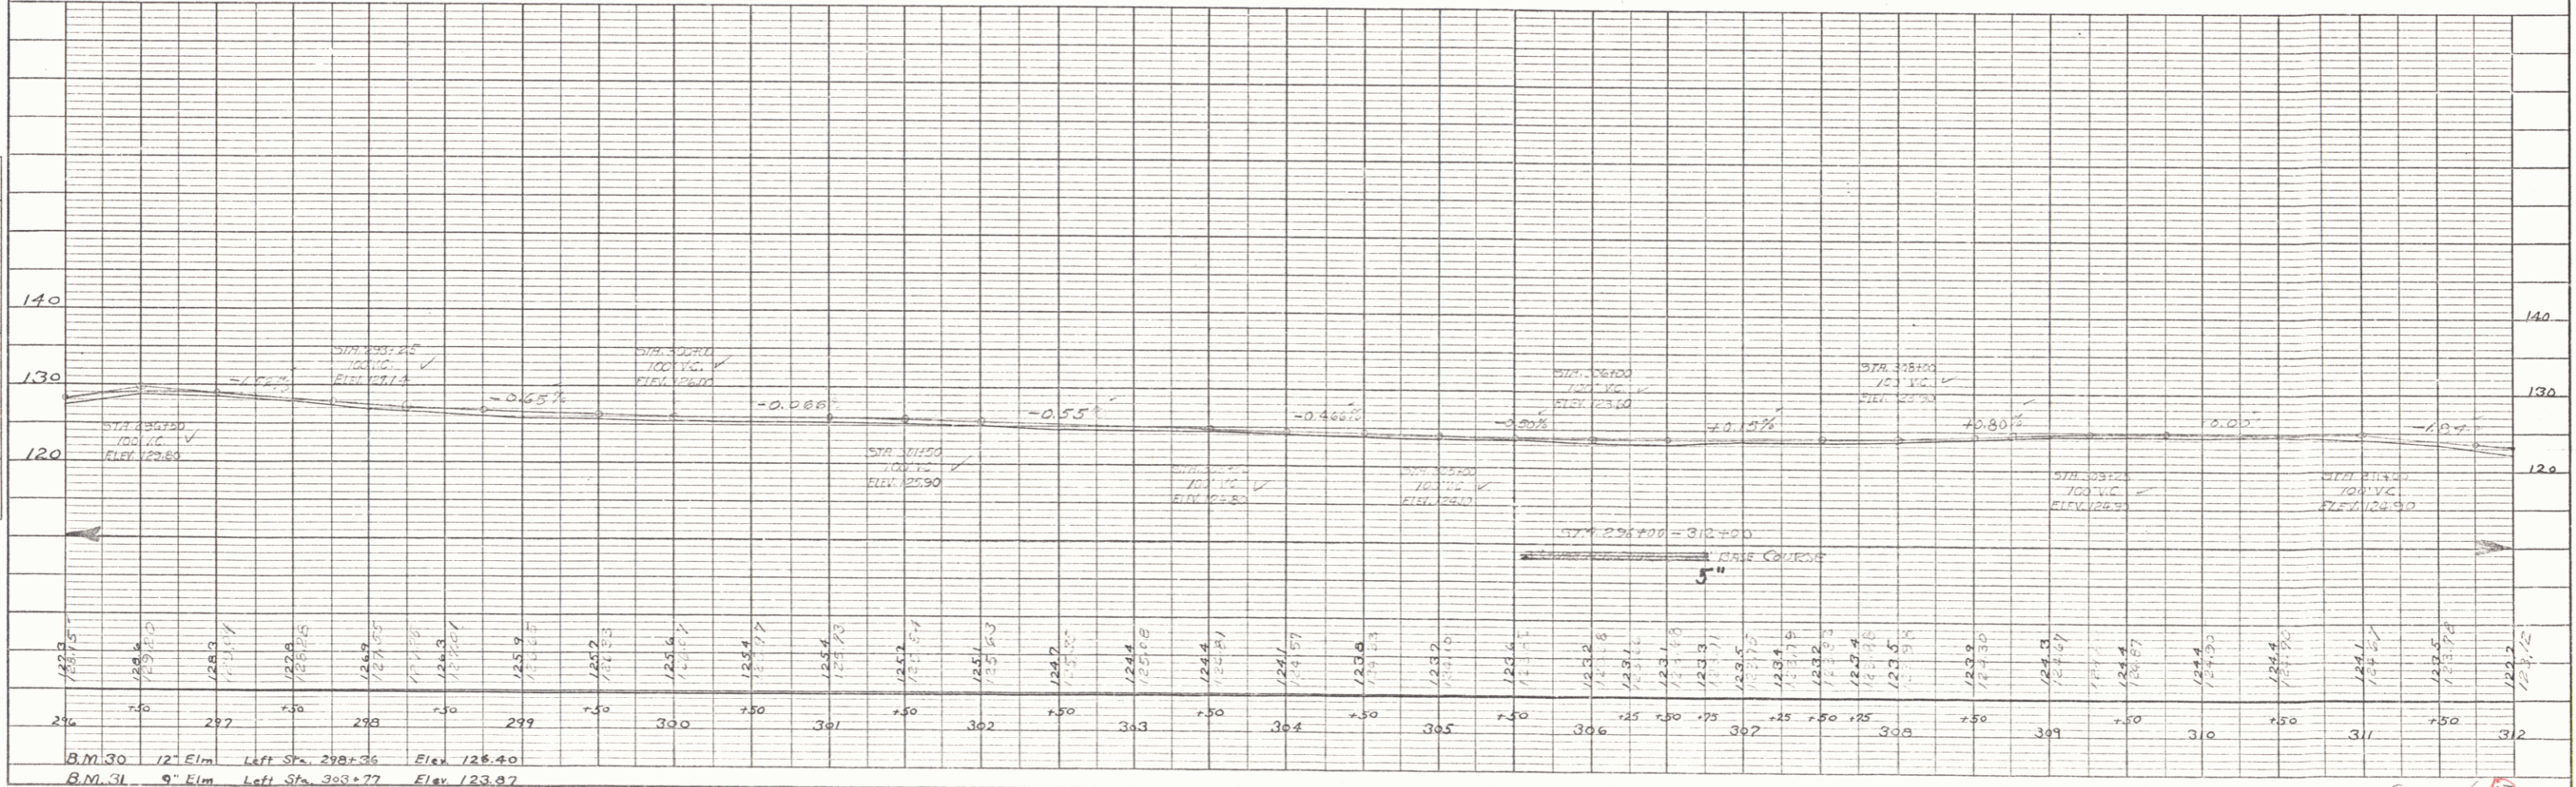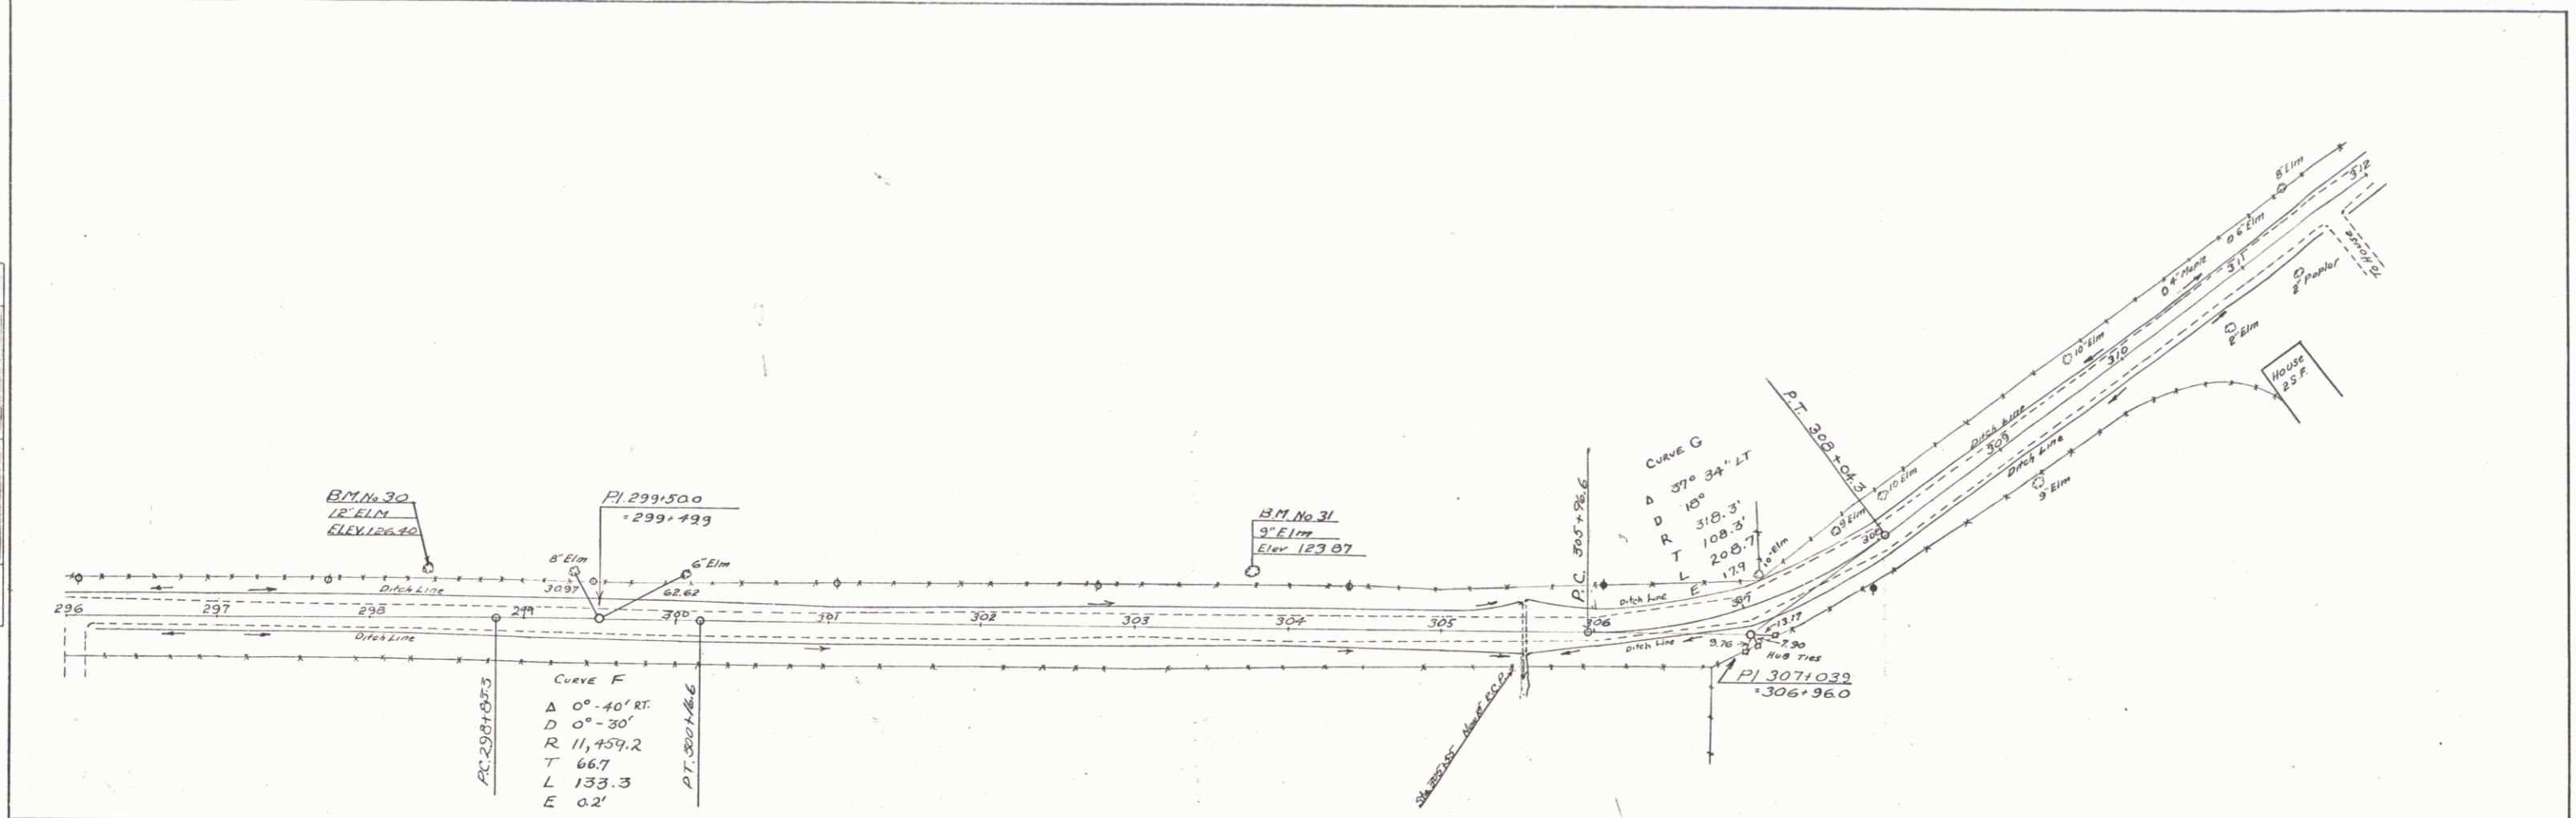

|   |  |     |     |     |     |     |     |     |     |     |     |     |     |     |     |     |
|---|--|-----|-----|-----|-----|-----|-----|-----|-----|-----|-----|-----|-----|-----|-----|-----|
| 296   | 297  | 298 | 299 | 300 | 301 | 302 | 303 | 304 | 305 | 306 | 307 | 308 | 309 | 310 | 311 | 312 |
| B.M. 30<br>12' Elm<br>Left Sp. 298+36<br>Elev. 126.40 |  |     |     |     |     |     |     |     |     |     |     |     |     |     |     |     |
|   | B.M. 31<br>9' Elm<br>Left Sp. 303+77<br>Elev. 123.97 |     |     |     |     |     |     |     |     |     |     |     |     |     |     |     |

PLATE 1 - PLAN - PROFILE OF P. & E. STANDARD  
 ROADWAY & ELEV. CO. NEW YORK

SHEET NO. 13  
 ADAMS - CURTIS PRINTERS  
 9

PLAN  
 DRAWN BY: *E. F. H. H. H.*  
 CHECKED BY: *E. F. H. H. H.*  
 DATE: *10/24/29*  
 PROJECT: *12" Elm*  
 SHEET NO.: *10*  
 TOTAL SHEETS: *10*  
 SCALE: *1" = 40'*  
 NOTE: *SEE PLAN FOR ALL DIMENSIONS*  
 BY: *E. F. H. H. H.*  
 CHECKED BY: *E. F. H. H. H.*  
 DATE: *10/24/29*  
 PROJECT: *12" Elm*  
 SHEET NO.: *10*  
 TOTAL SHEETS: *10*  
 SCALE: *1" = 40'*  
 NOTE: *SEE PLAN FOR ALL DIMENSIONS*

PROFILE  
 DRAWN BY: *E. F. H. H. H.*  
 CHECKED BY: *E. F. H. H. H.*  
 DATE: *10/24/29*  
 PROJECT: *12" Elm*  
 SHEET NO.: *10*  
 TOTAL SHEETS: *10*  
 SCALE: *1" = 40'*  
 NOTE: *SEE PLAN FOR ALL DIMENSIONS*  
 BY: *E. F. H. H. H.*  
 CHECKED BY: *E. F. H. H. H.*  
 DATE: *10/24/29*  
 PROJECT: *12" Elm*  
 SHEET NO.: *10*  
 TOTAL SHEETS: *10*  
 SCALE: *1" = 40'*  
 NOTE: *SEE PLAN FOR ALL DIMENSIONS*


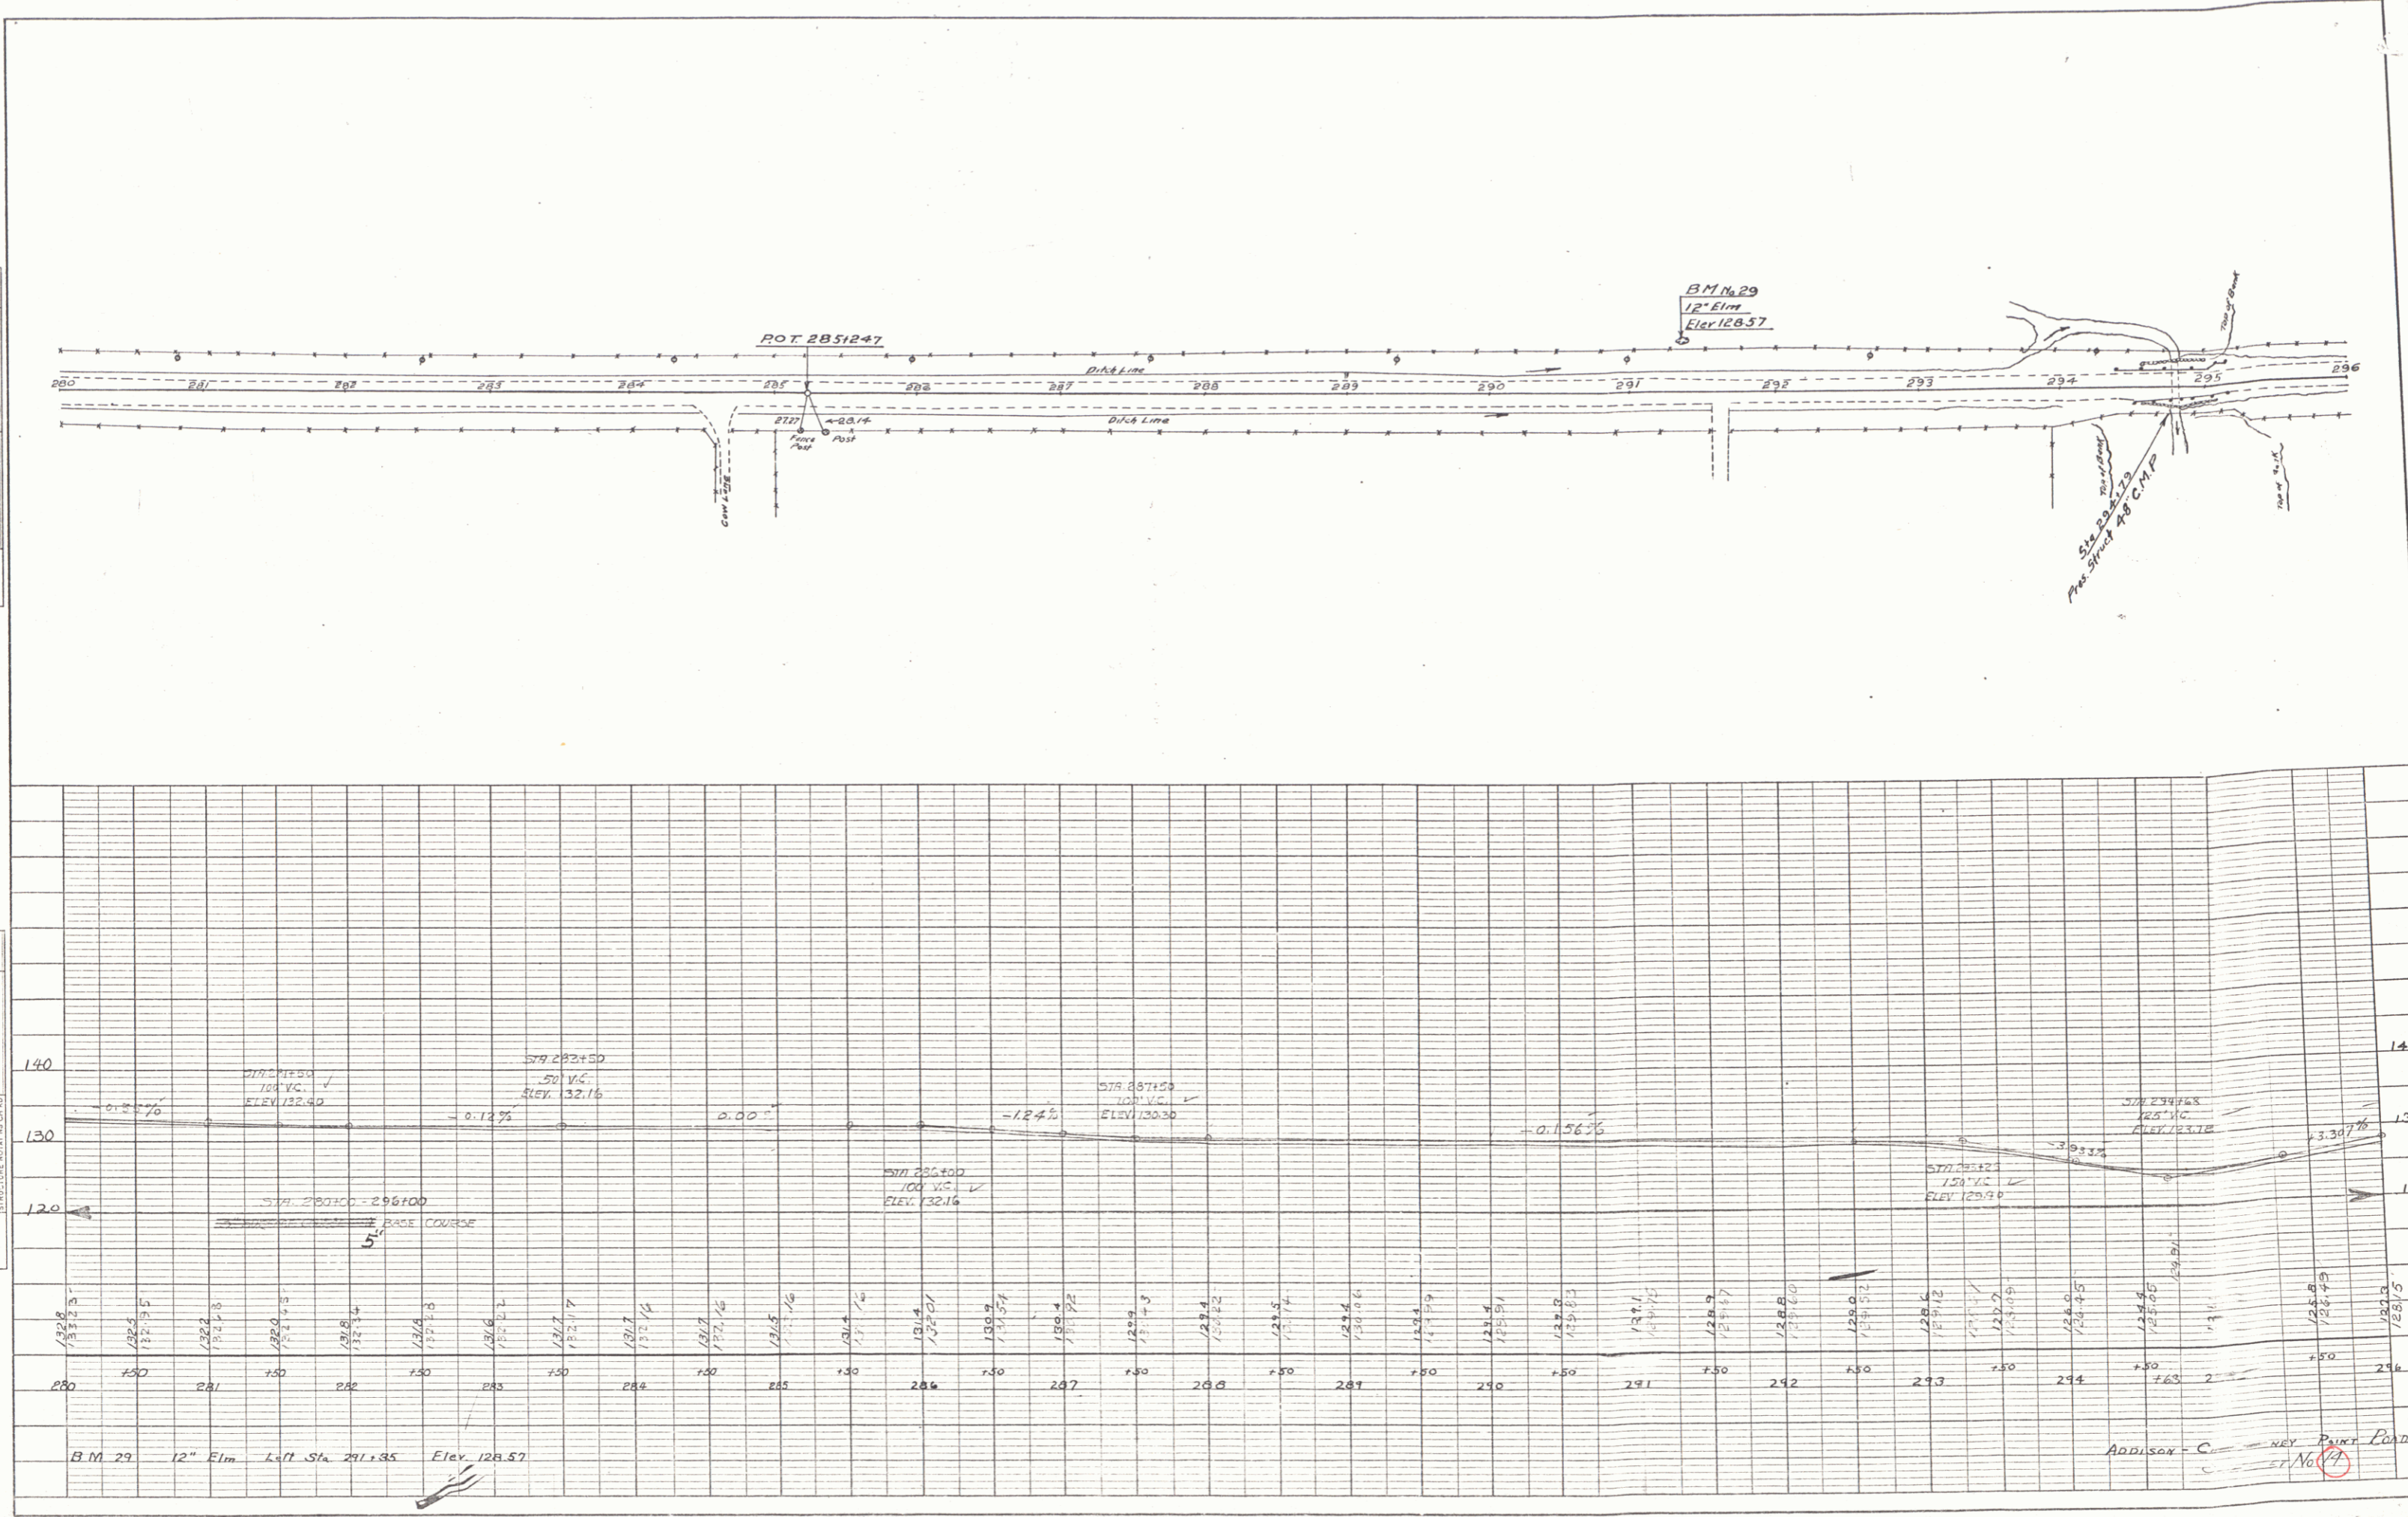


PLATE 1 - PLAN - PROFILE OF 12" & 6" B. BRICKS  
 KUPPEL & BROS. CO. NEW YORK

PLAN  
 SHEET NO. 4592  
 PROJECT NO. 2721339  
 DATE 12/20/11  
 DRAWN BY E. P. BARNETT  
 CHECKED BY [Signature]  
 IN CHARGE BY [Signature]

PROFILE  
 SHEET NO. 4593  
 PROJECT NO. 2721339  
 DATE 12/20/11  
 DRAWN BY E. P. BARNETT  
 CHECKED BY [Signature]  
 IN CHARGE BY [Signature]

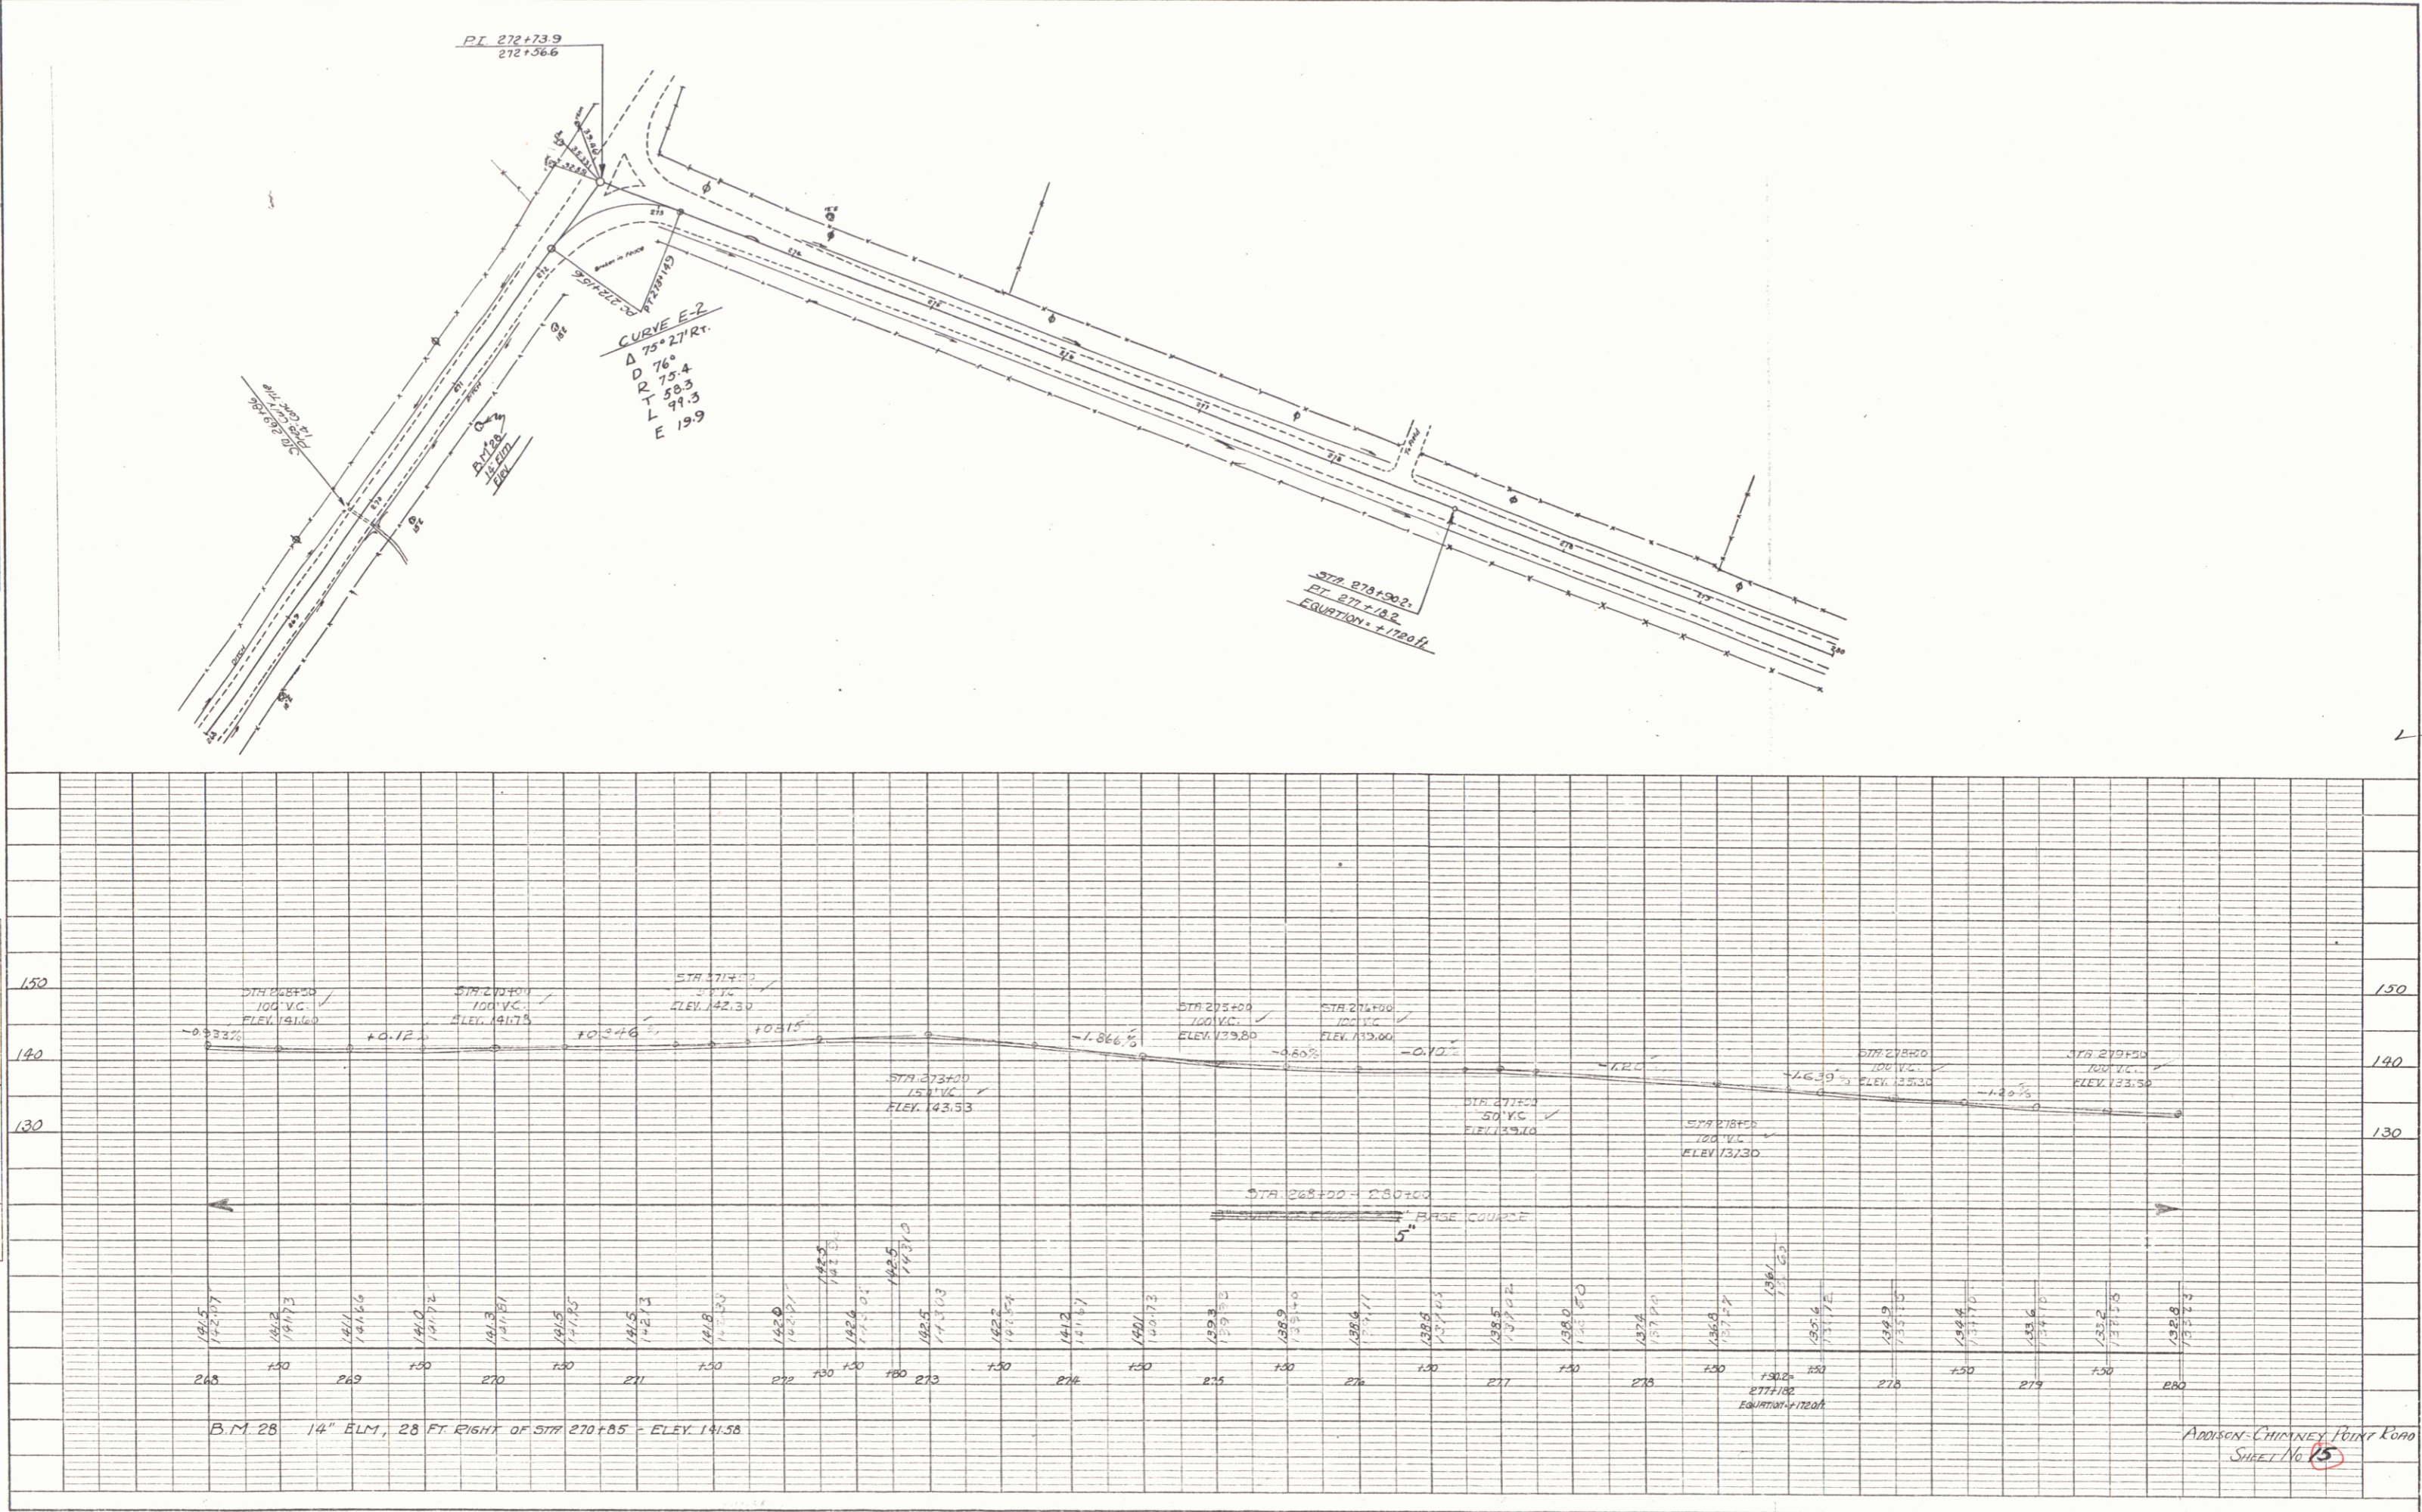

PLAN  
 DRAWN BY: W. J. ...  
 CHECKED BY: ...  
 DATE: ...  
 SHEET NO.: ...

PROFILE  
 DRAWN BY: W. J. ...  
 CHECKED BY: ...  
 DATE: ...  
 SHEET NO.: ...




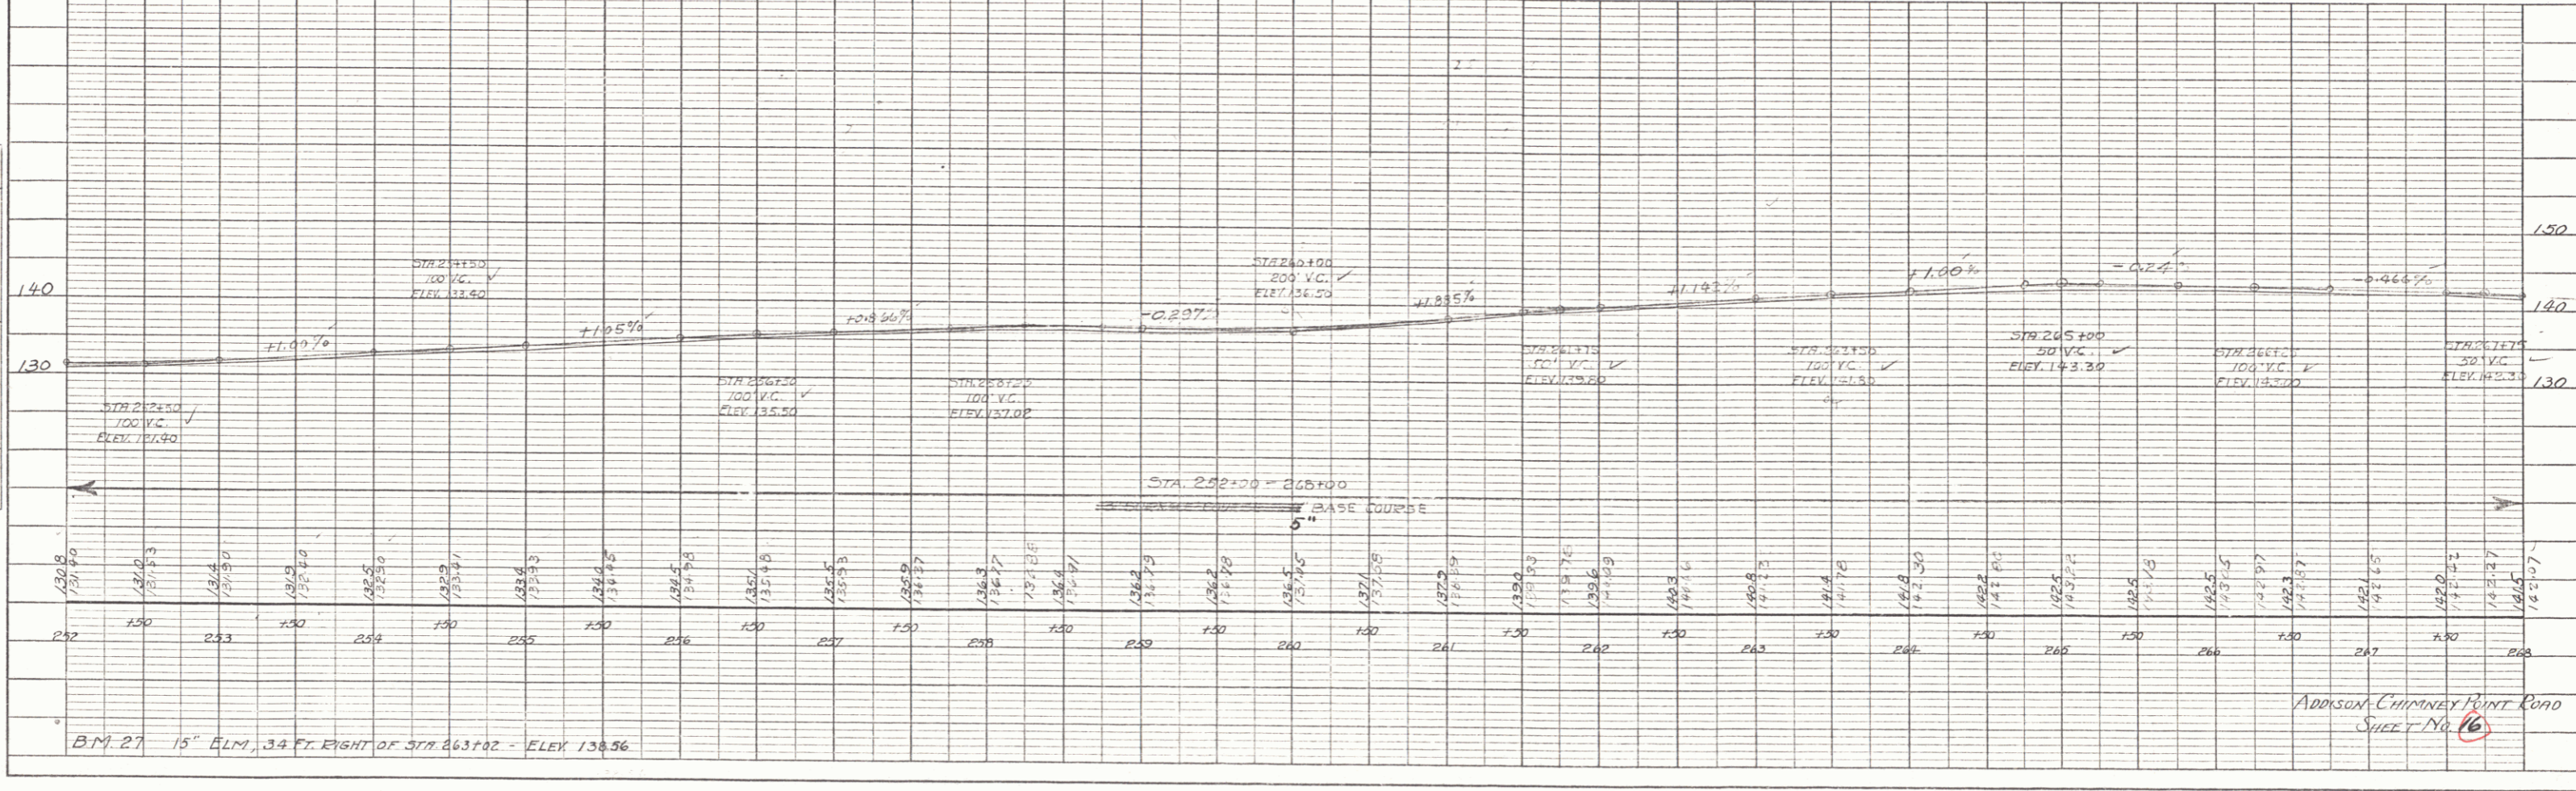


PLATE 1 - PLAN - PROFILE - P.A.S. & STANDARD  
 MAPS & BOOK CO. NEW YORK

PLAN  
 DRAWN BY: C.E. PATTERSON  
 CHECKED BY: E. ALMSTRÖM  
 DATE: 1942  
 NO. 1042  
 REVISIONS:  
 1. DATE: 1942  
 BY: C.E. PATTERSON  
 CHECKED BY: E. ALMSTRÖM  
 NO. 1042

PROFILE  
 DRAWN BY: C.E. PATTERSON  
 CHECKED BY: E. ALMSTRÖM  
 DATE: 1942  
 NO. 1042  
 REVISIONS:  
 1. DATE: 1942  
 BY: C.E. PATTERSON  
 CHECKED BY: E. ALMSTRÖM  
 NO. 1042

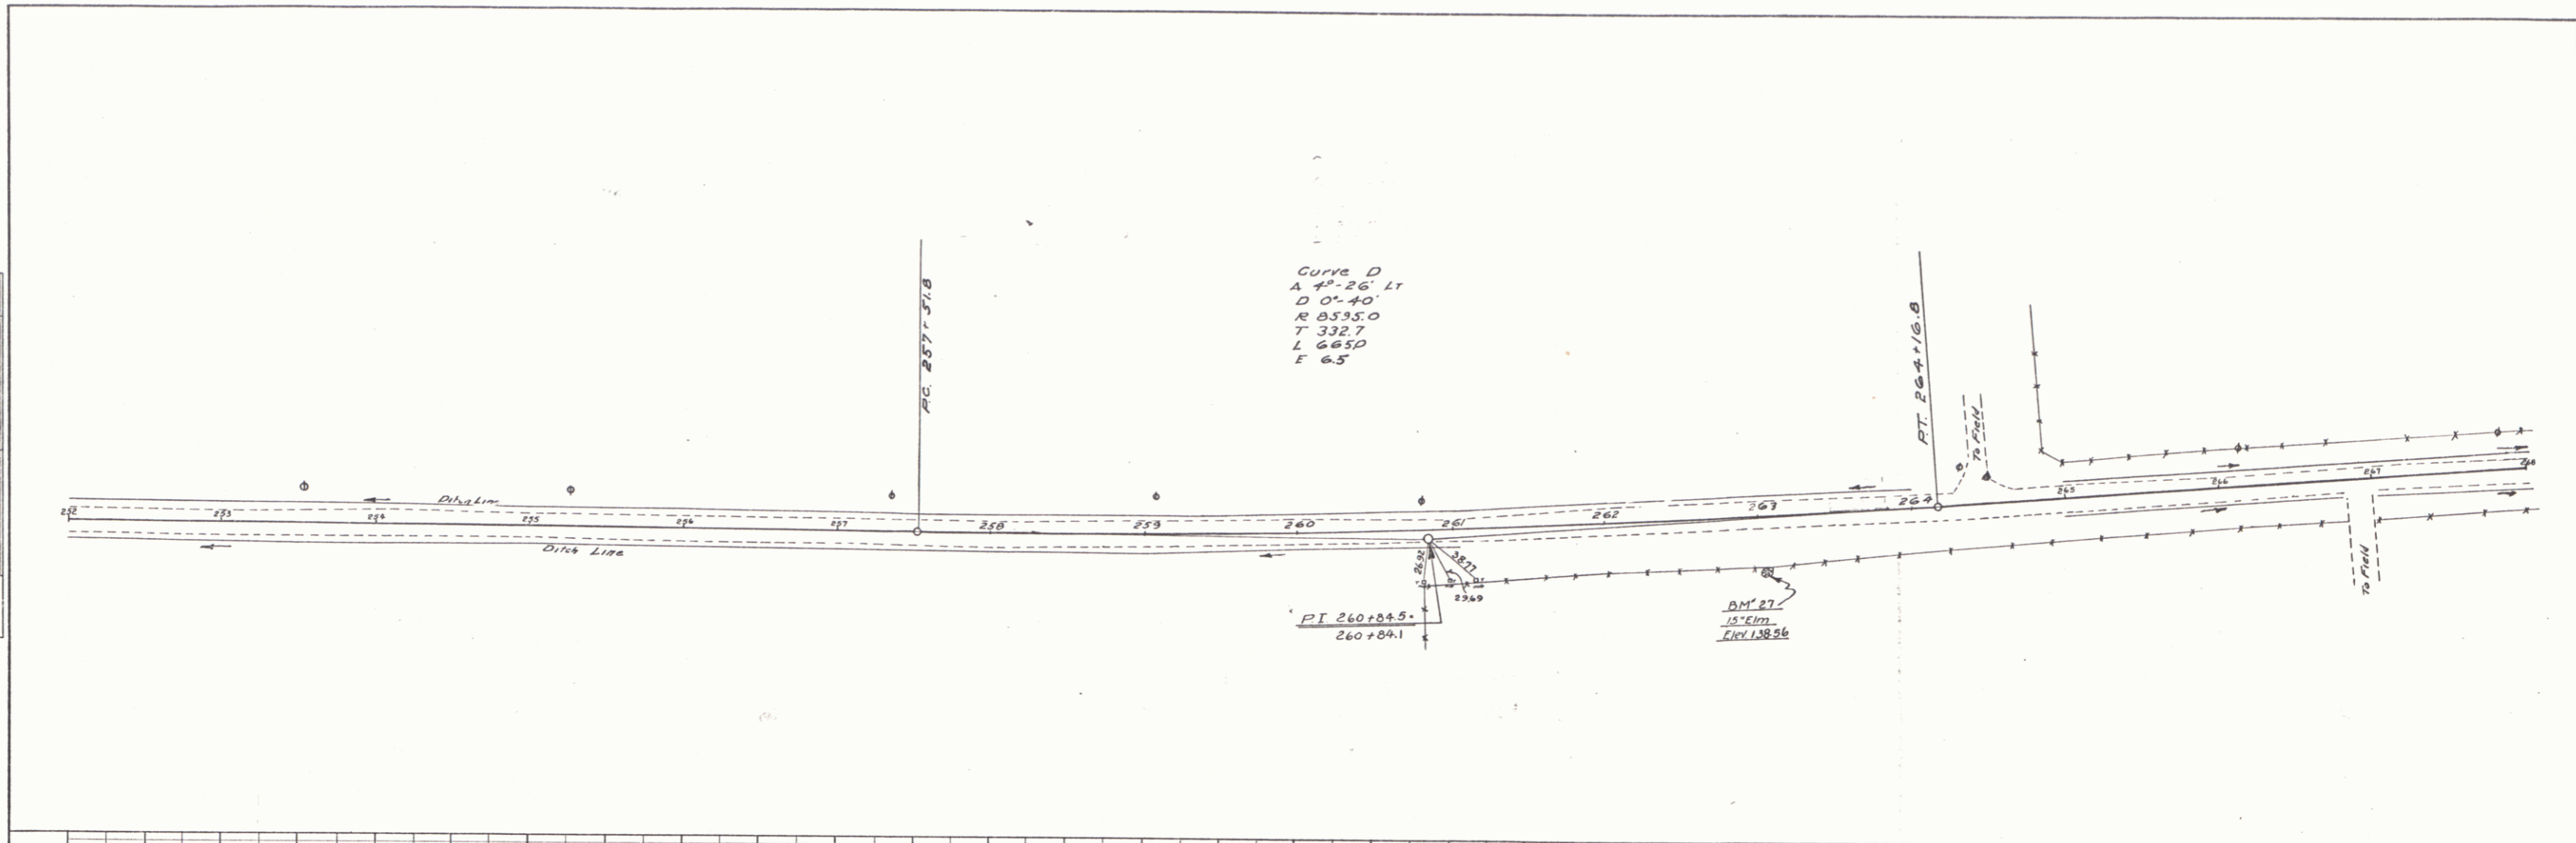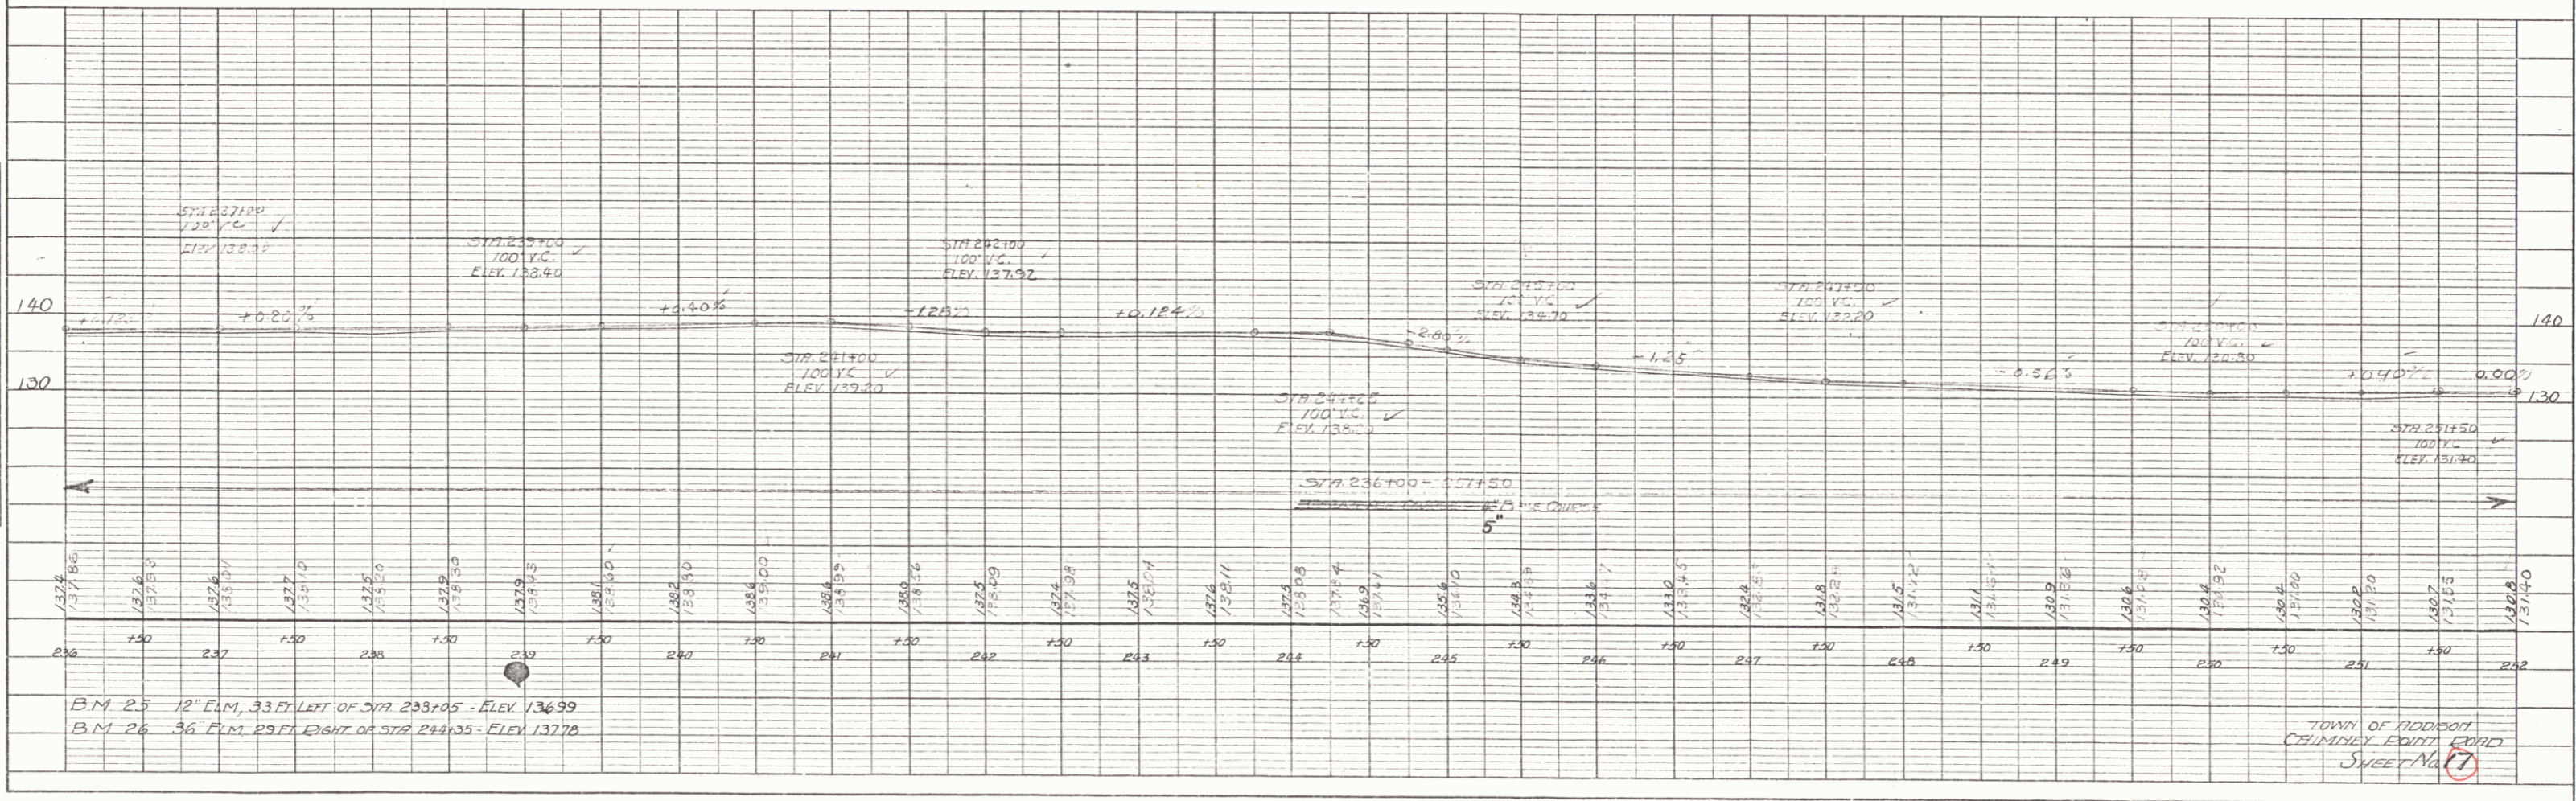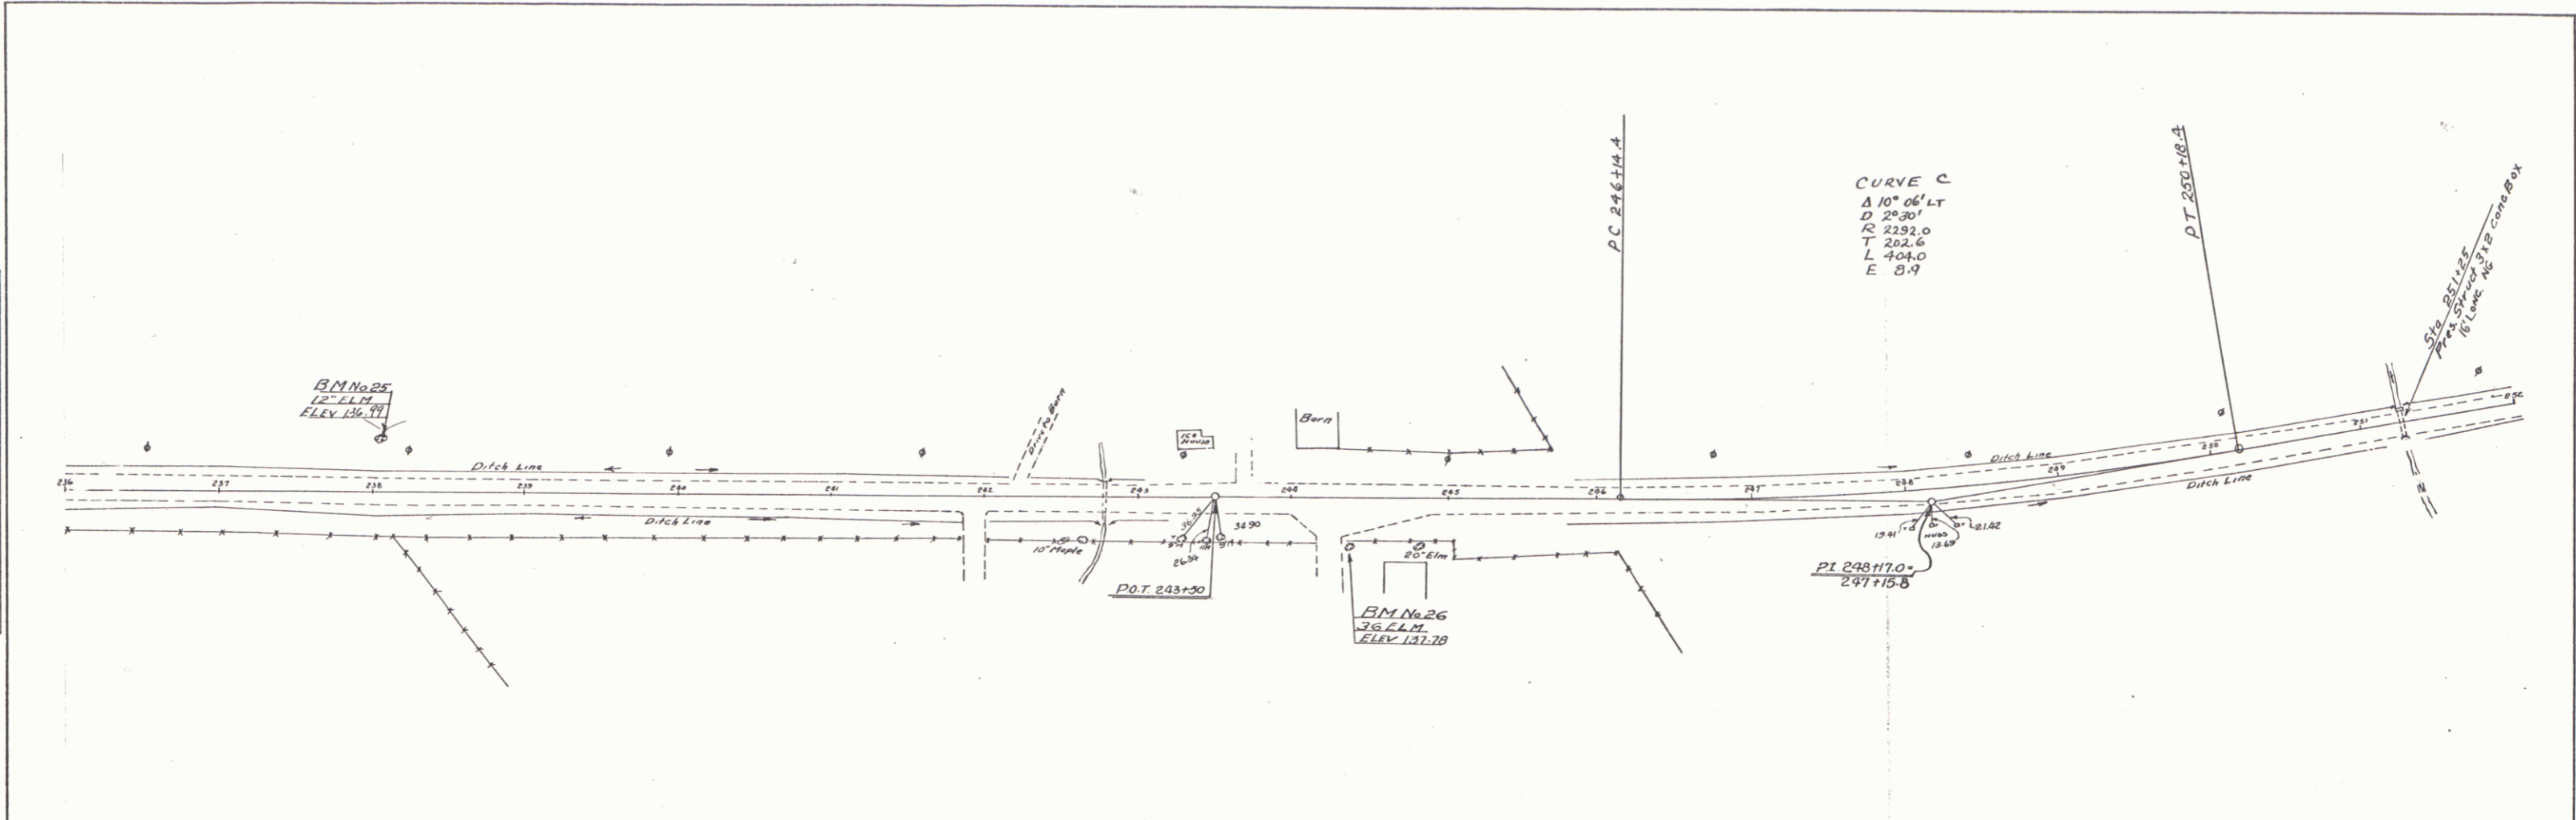


B.M. 25 12' E.L.M. 33 FT. LEFT OF STA. 233+95 - ELEV. 136.99  
 B.M. 26 36' E.L.M. 29 FT. RIGHT OF STA. 244+35 - ELEV. 137.78


TOWN OF RODDICK  
 COLUMBIAN POINT, IOWA  
 SHEET No. 17



PLAN  
 DATE: 10/1/10  
 DRAWN BY: C.E. FALNAM  
 CHECKED BY: A.L.P.  
 SCALE: AS SHOWN  
 NOTES:  
 1. ALL DIMENSIONS ARE IN FEET AND INCHES.  
 2. SEE SHEET 15 FOR CONTINUATION.

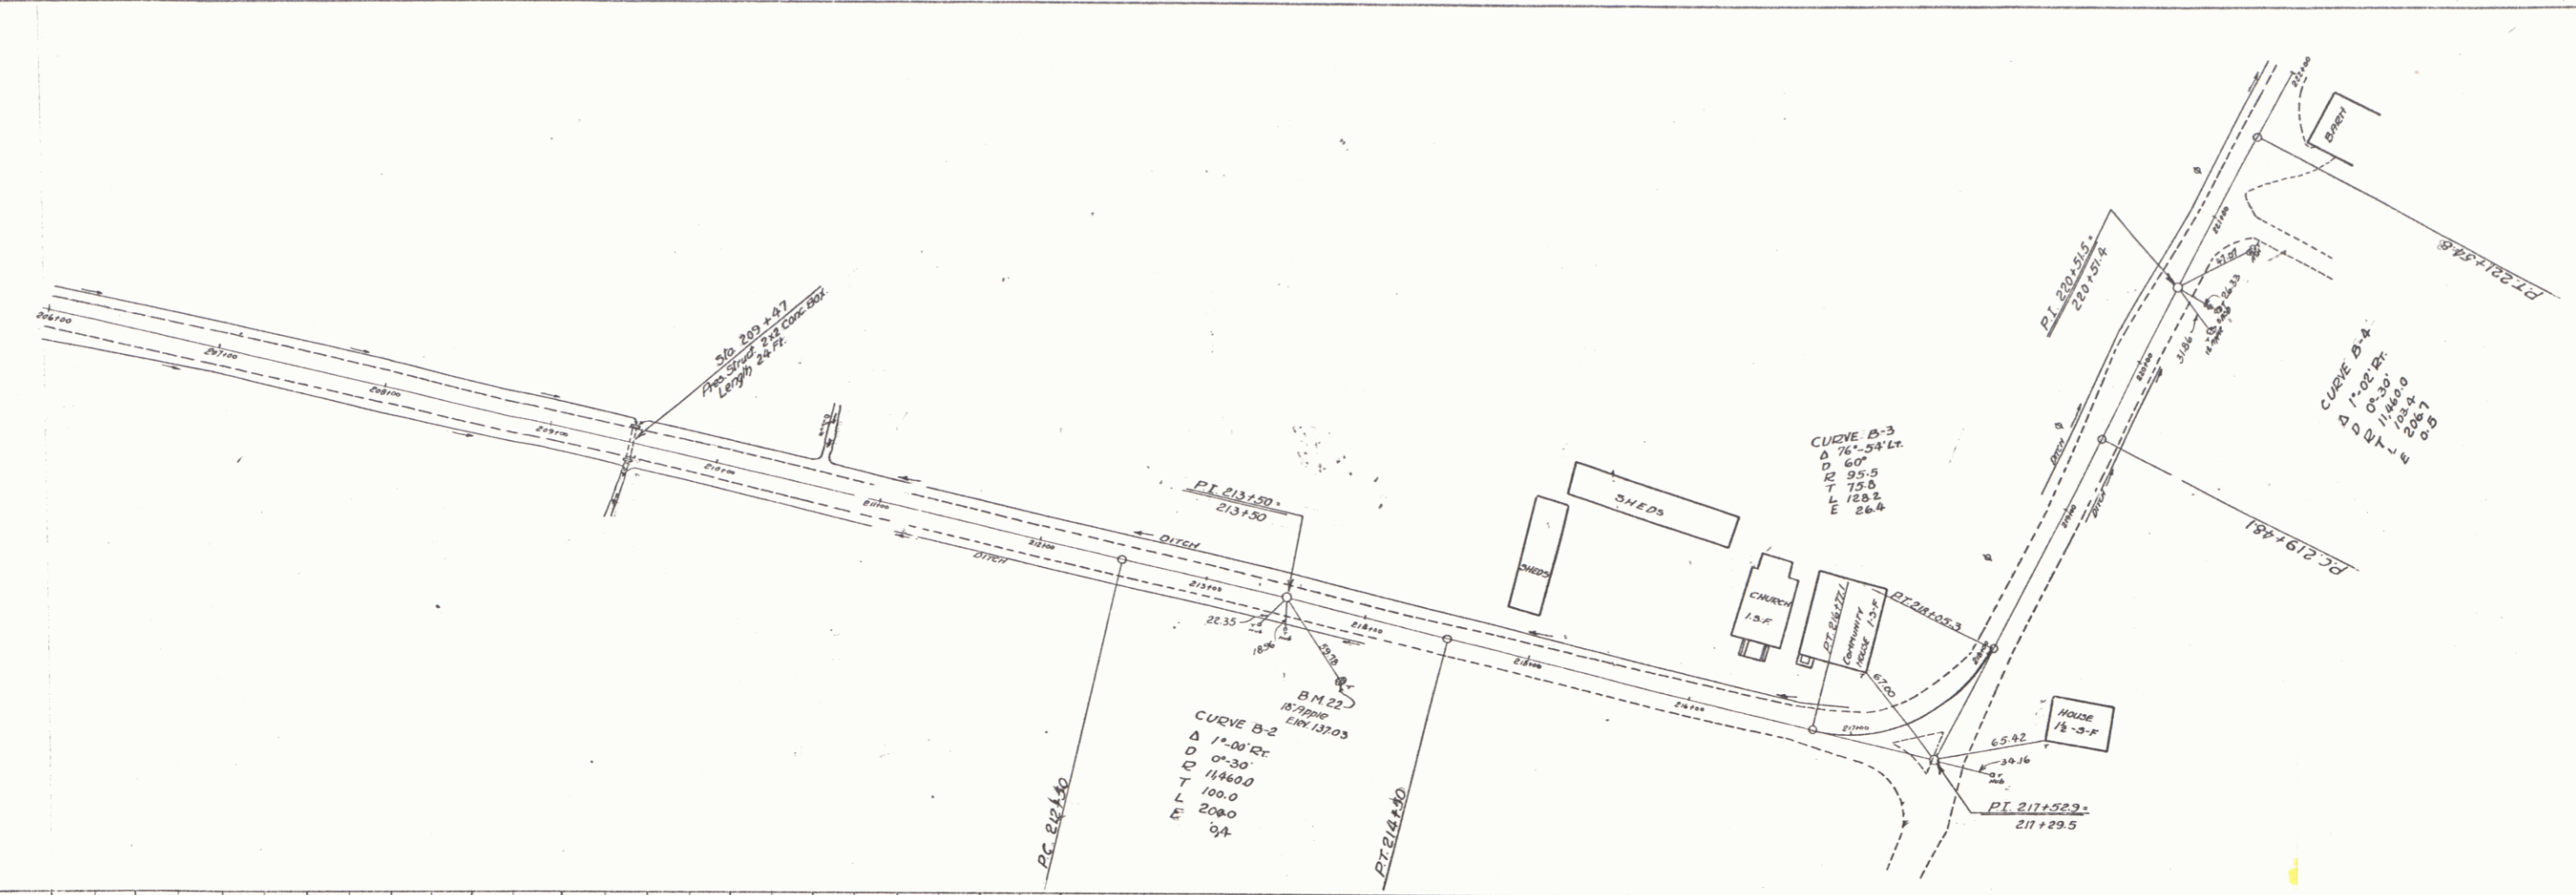

PROFILE  
 DATE: 10/1/10  
 DRAWN BY: C.E. FALNAM  
 CHECKED BY: A.L.P.  
 SCALE: AS SHOWN  
 NOTES:  
 1. ALL DIMENSIONS ARE IN FEET AND INCHES.  
 2. SEE SHEET 15 FOR CONTINUATION.

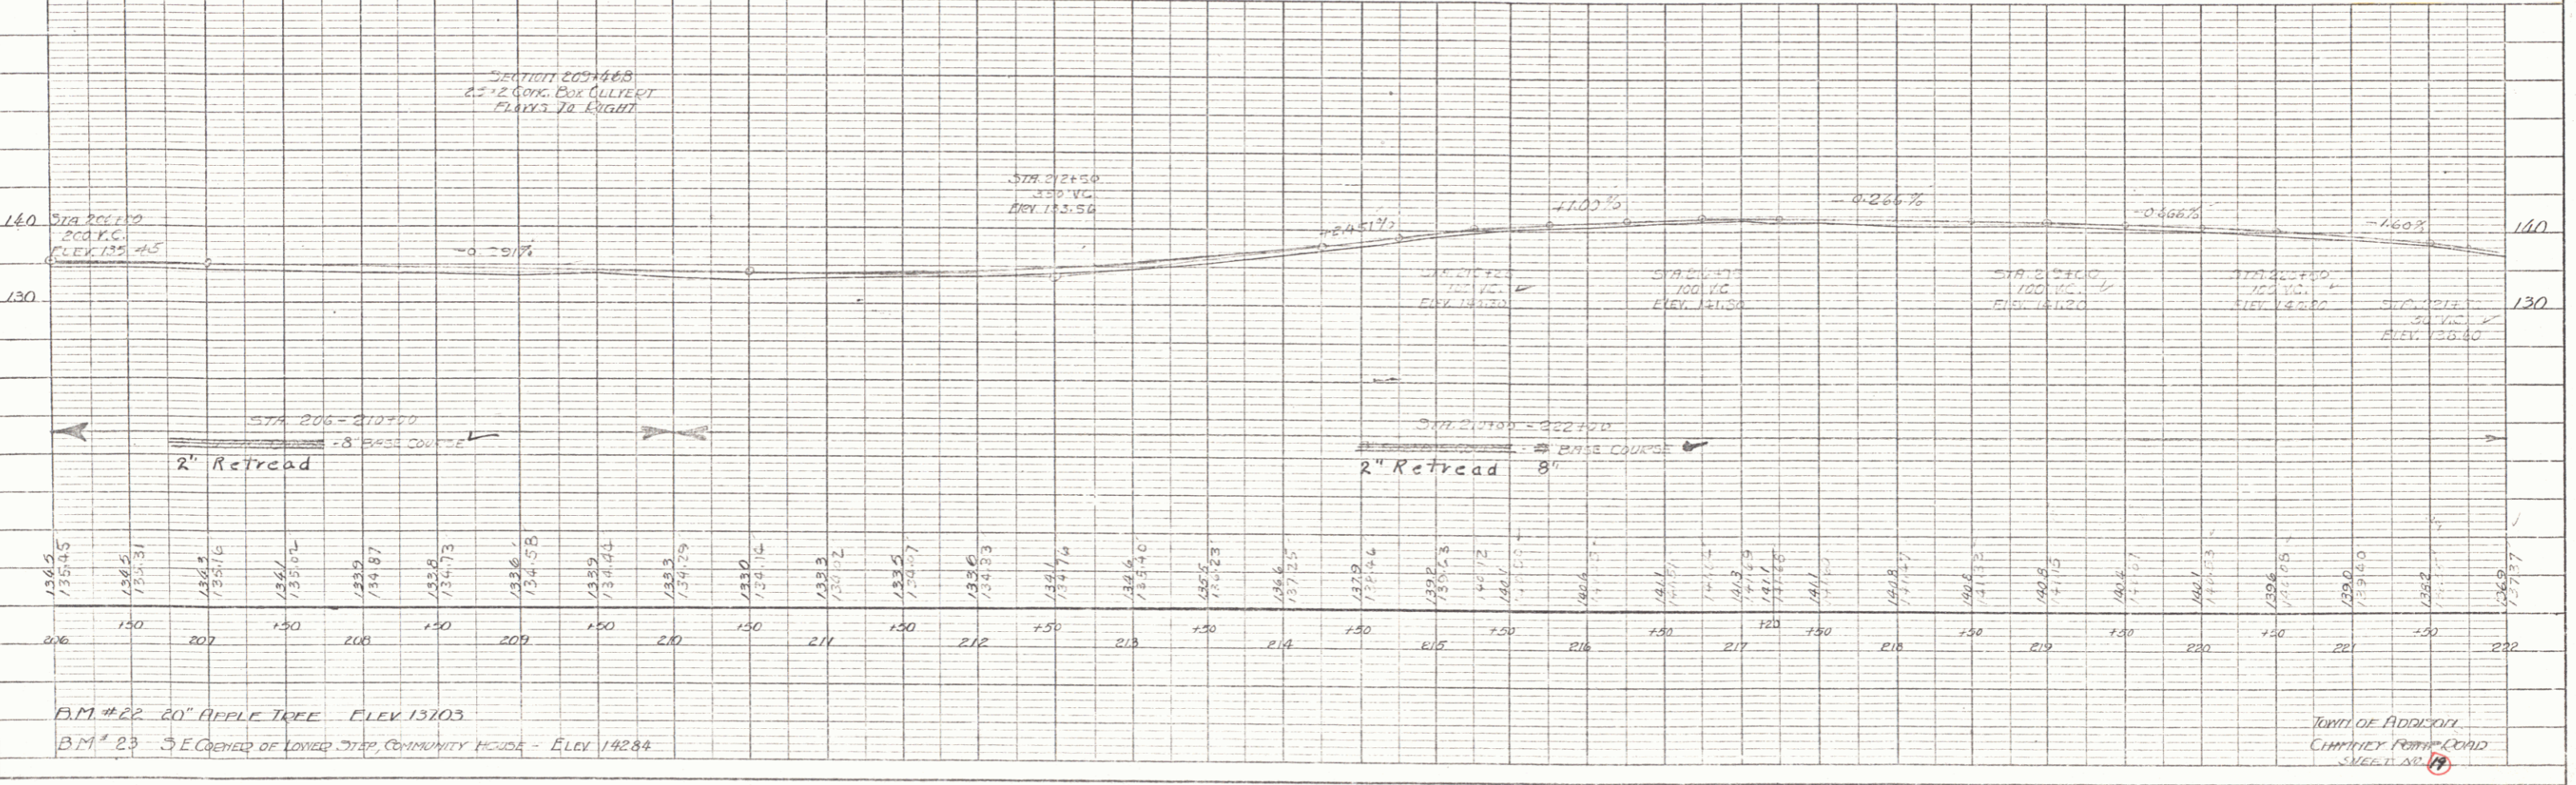

B.M. #22 20" APPLE TREE ELEV 137.03  
 B.M. #23 3/4" CENTER OF LOWER STEP, COMMUNITY HOUSE - ELEV 142.84

TOWN OF ADDISON  
 CHARLEY RAMP ROAD  
 SHEET 15 OF 15