


PLAN
 SUBMITTED BY
 DATE
 CHECKED BY
 NO. OF SHEETS

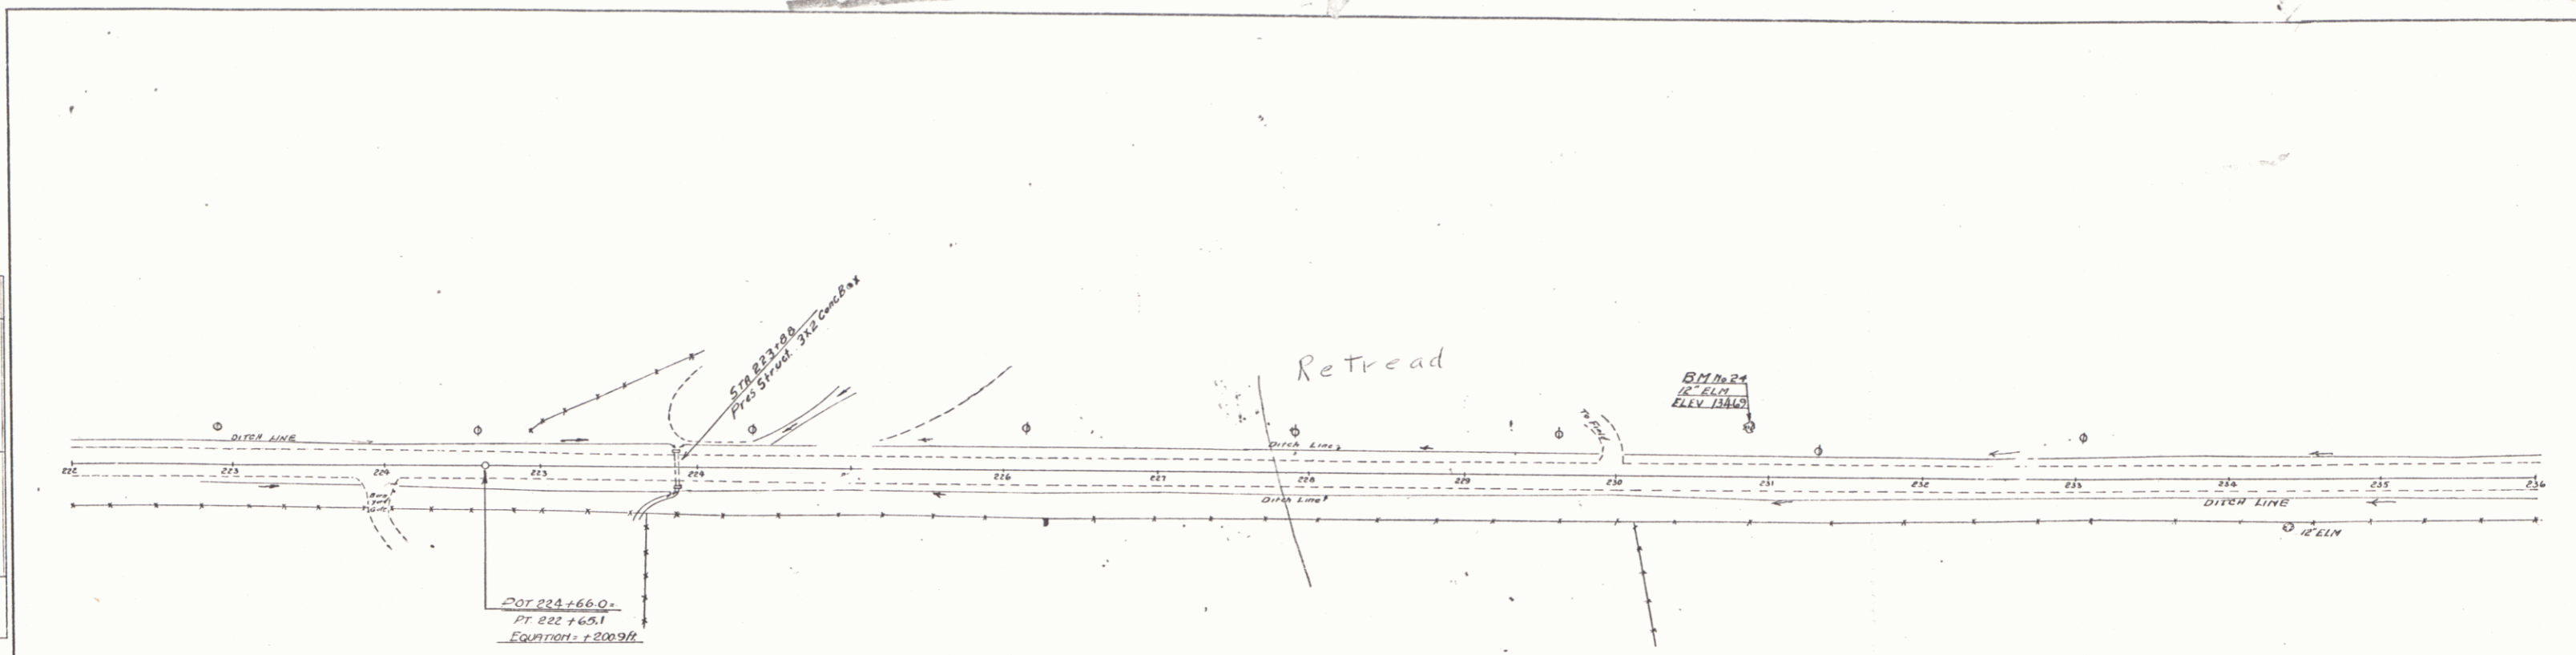

PROFILE
 SUBMITTED BY
 DATE
 CHECKED BY
 NO. OF SHEETS

