
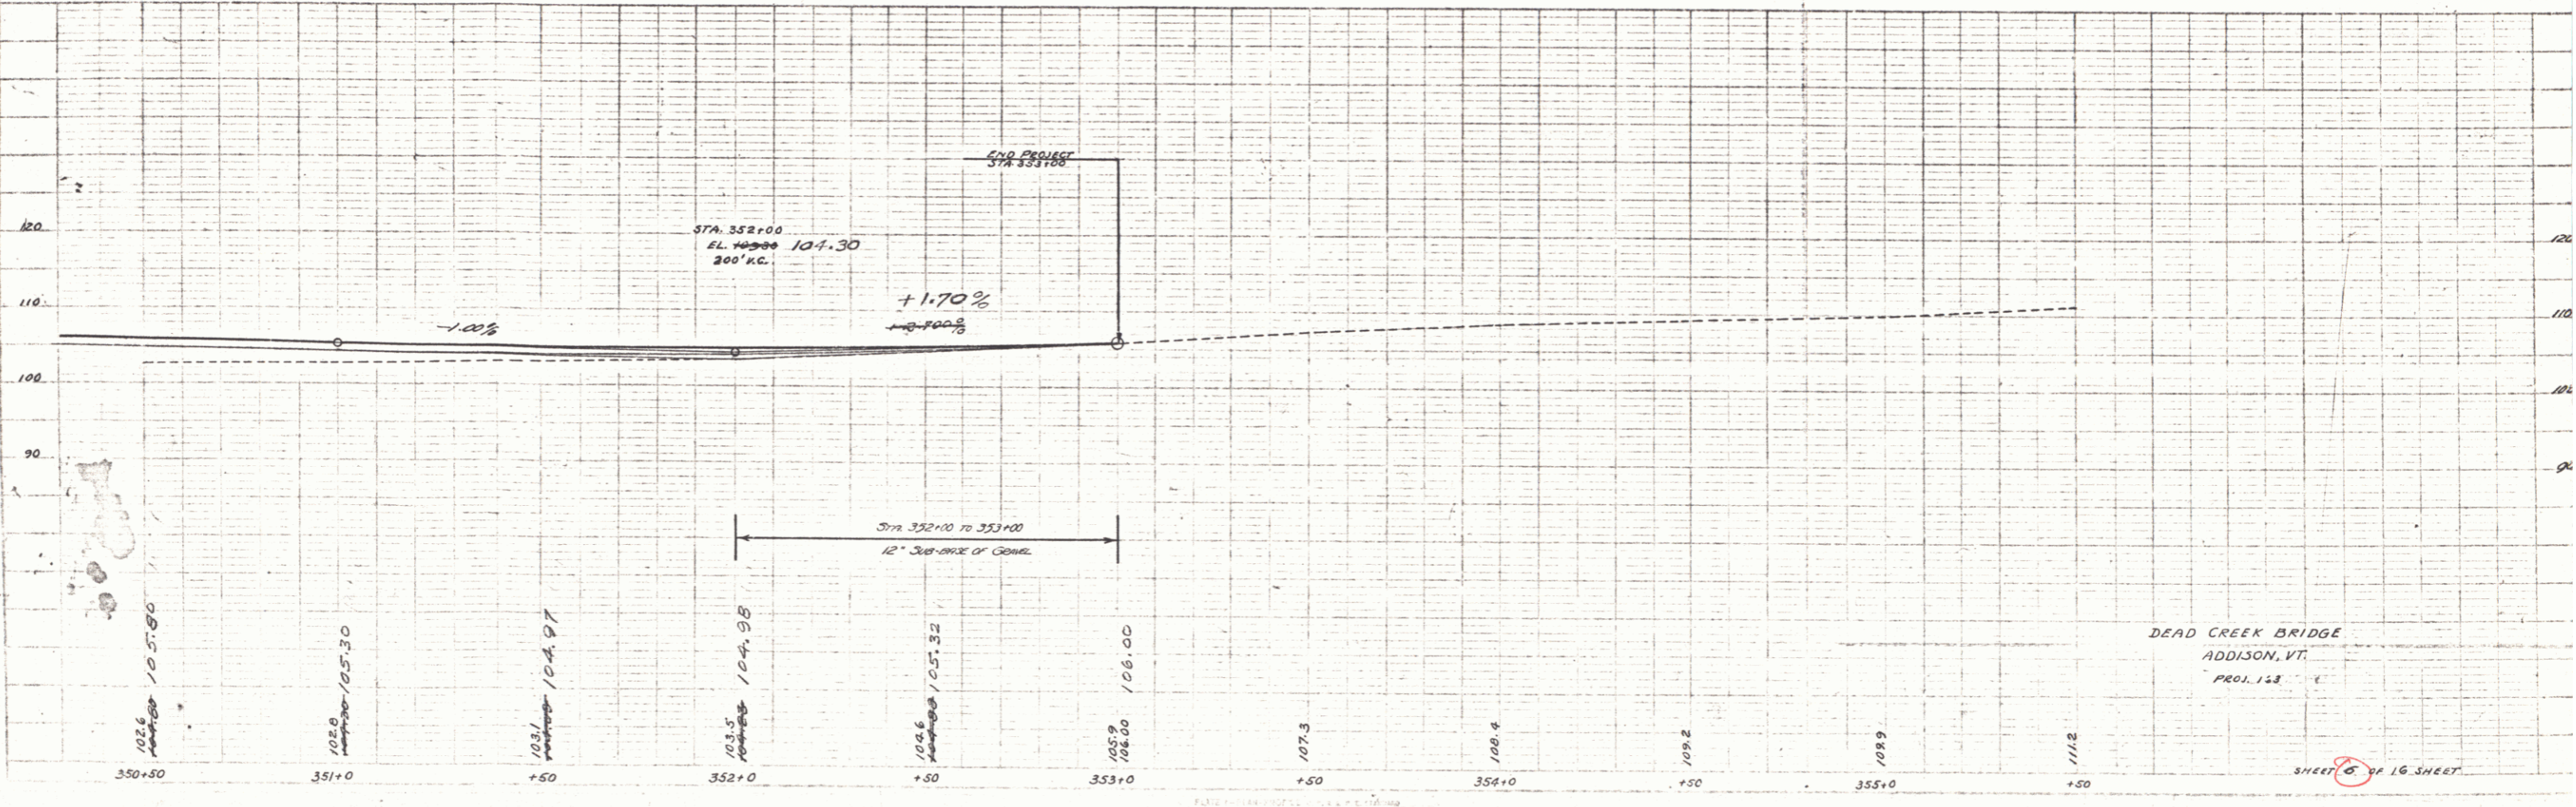


**CURVE No. 2**  
 $\Delta = 12^{\circ}-06' LR$   
 $D = 3^{\circ}$   
 $T = 202.6$   
 $L = 403.4$   
 $E = 10.6$   
 $R = 1910.1$

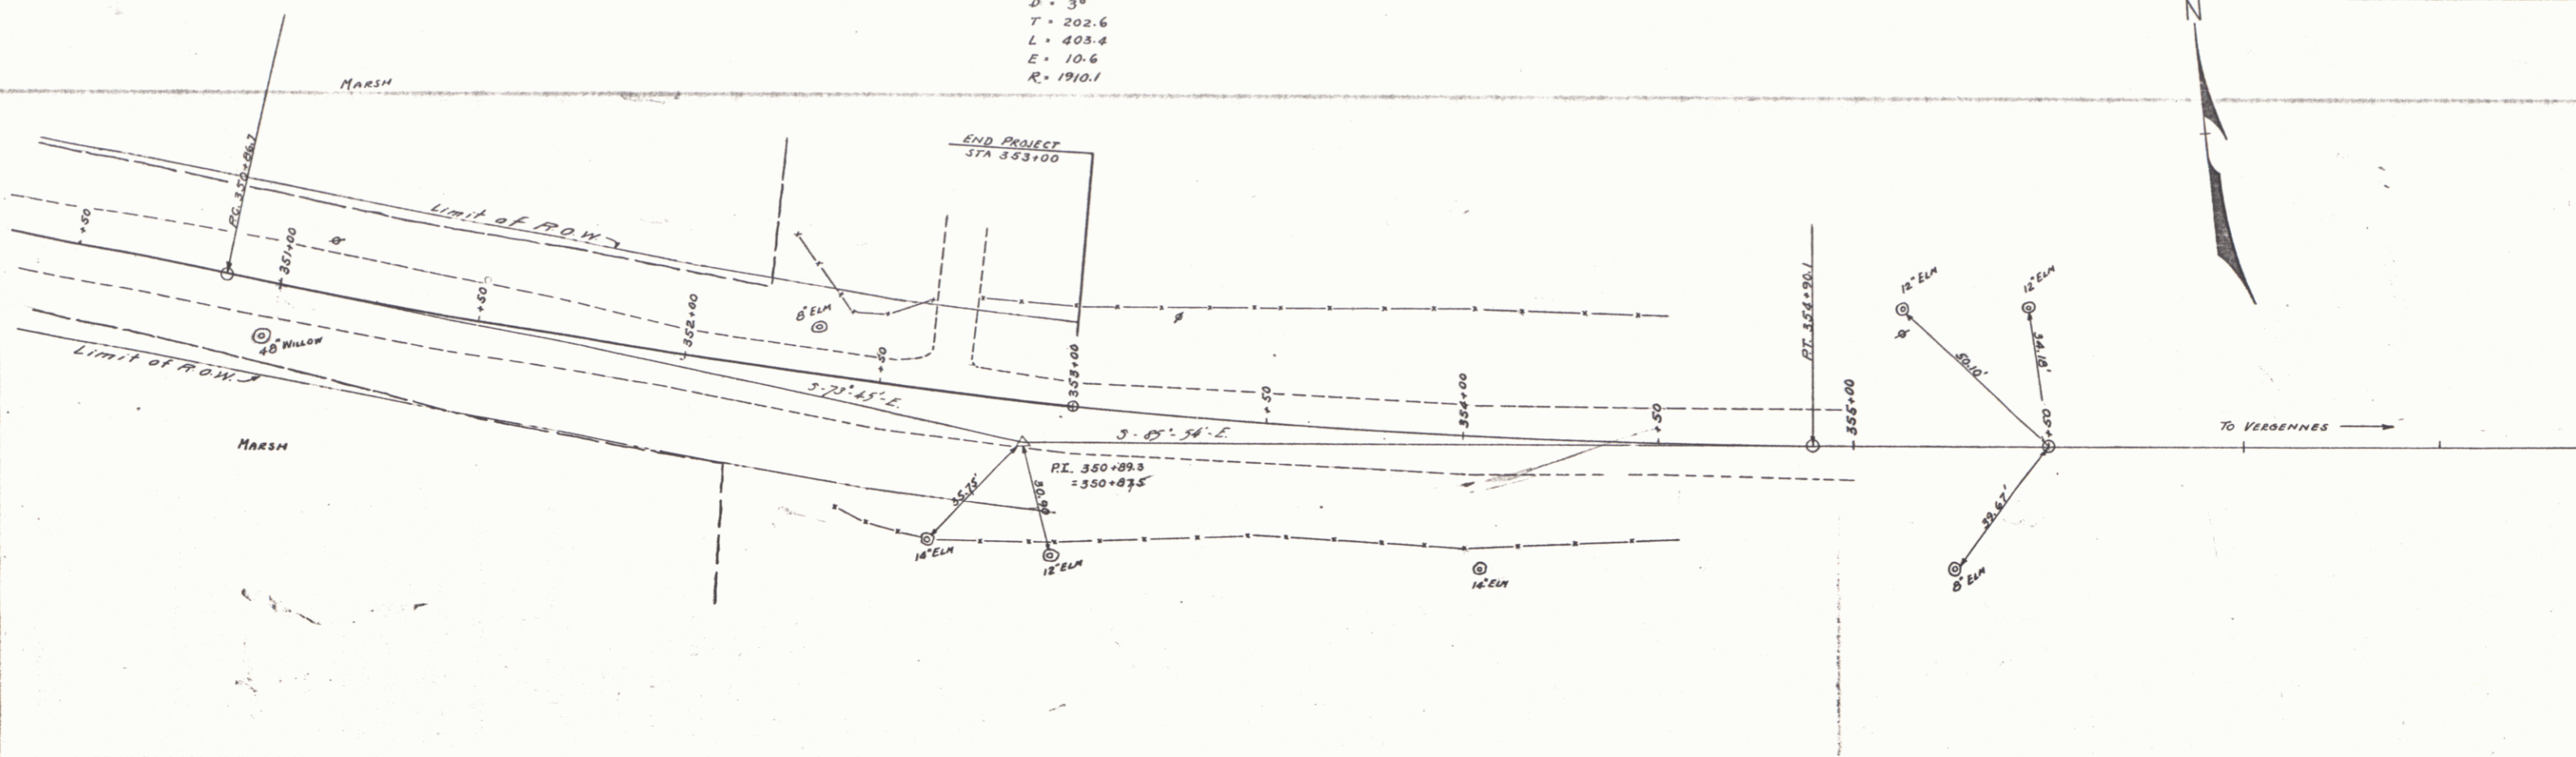

DEAD CREEK BRIDGE  
 ADDISON, VT.  
 PROJ. 128

SHEET 8 OF 16 SHEETS

4