


○ Removing Small Trees Item 20115
 21+06 Rt
 21+15 Rt
 21+72 Rt
 23+55 Rt
 24+04 Rt
 25+40 Rt
 16+43 Lt
 16+50 Rt
 16+53 Rt
 Marcel Dubois

Erosion Matting
 16+00 - 21+50 Rt
 16+00 - 25+50 Lt
 Excav and Removal of Rt Surf and Pave.
 17+70 - 20+85 Rt

Construct Drive
 17.45 Lt (Paved)
 20+00 Lt

Plank Guard Rail
 20+35 Rt (Barricade)

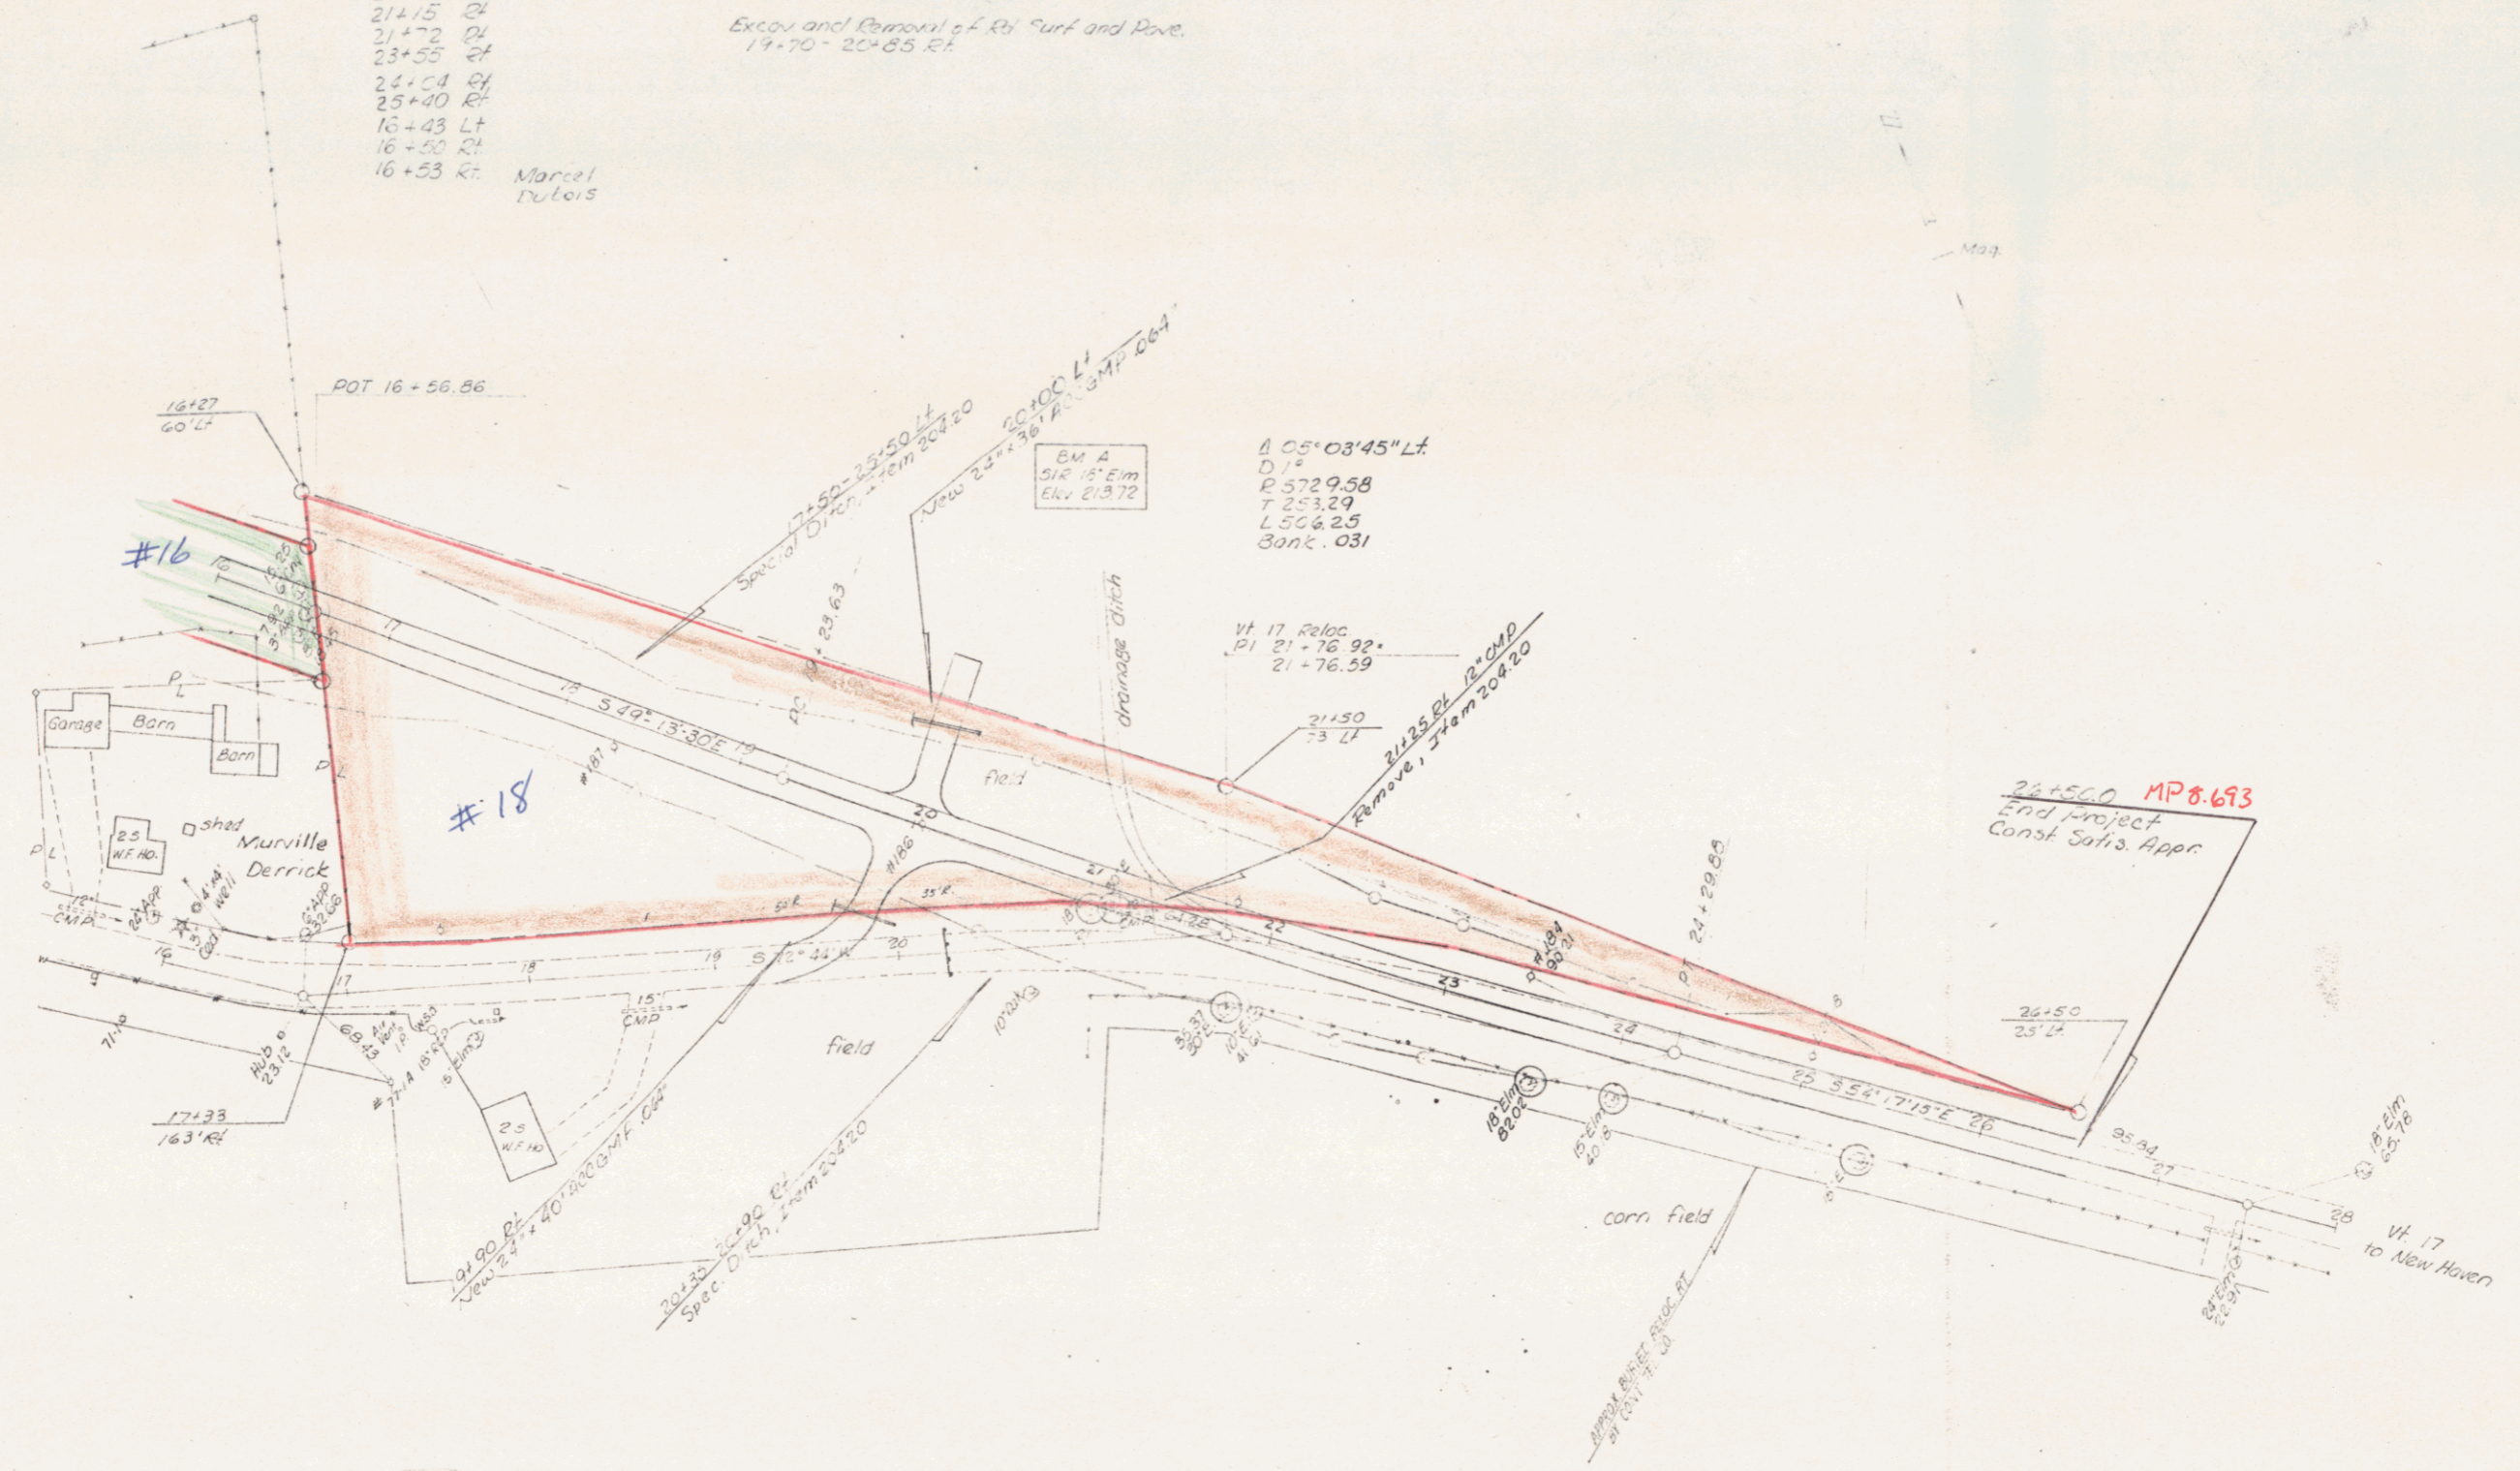

Δ 05° 03' 45" Lt
 D 5729.58
 T 253.29
 L 506.25
 Banc. 0.031

Vt 17 Reloc
 PI 21+76.92
 21+76.59

24+50 MP 8.693
 End Project
 Const Satisfy Appr

SURVEYED BY Fall DATE 9-71
 DRAWN BY Jorgensen DATE 8-72
 TRACED BY Jorgensen DATE 8-72
 ADDISON
 PROJ 3P NO. 0159-7302
 SHEET 6 OF 24
 0-7