
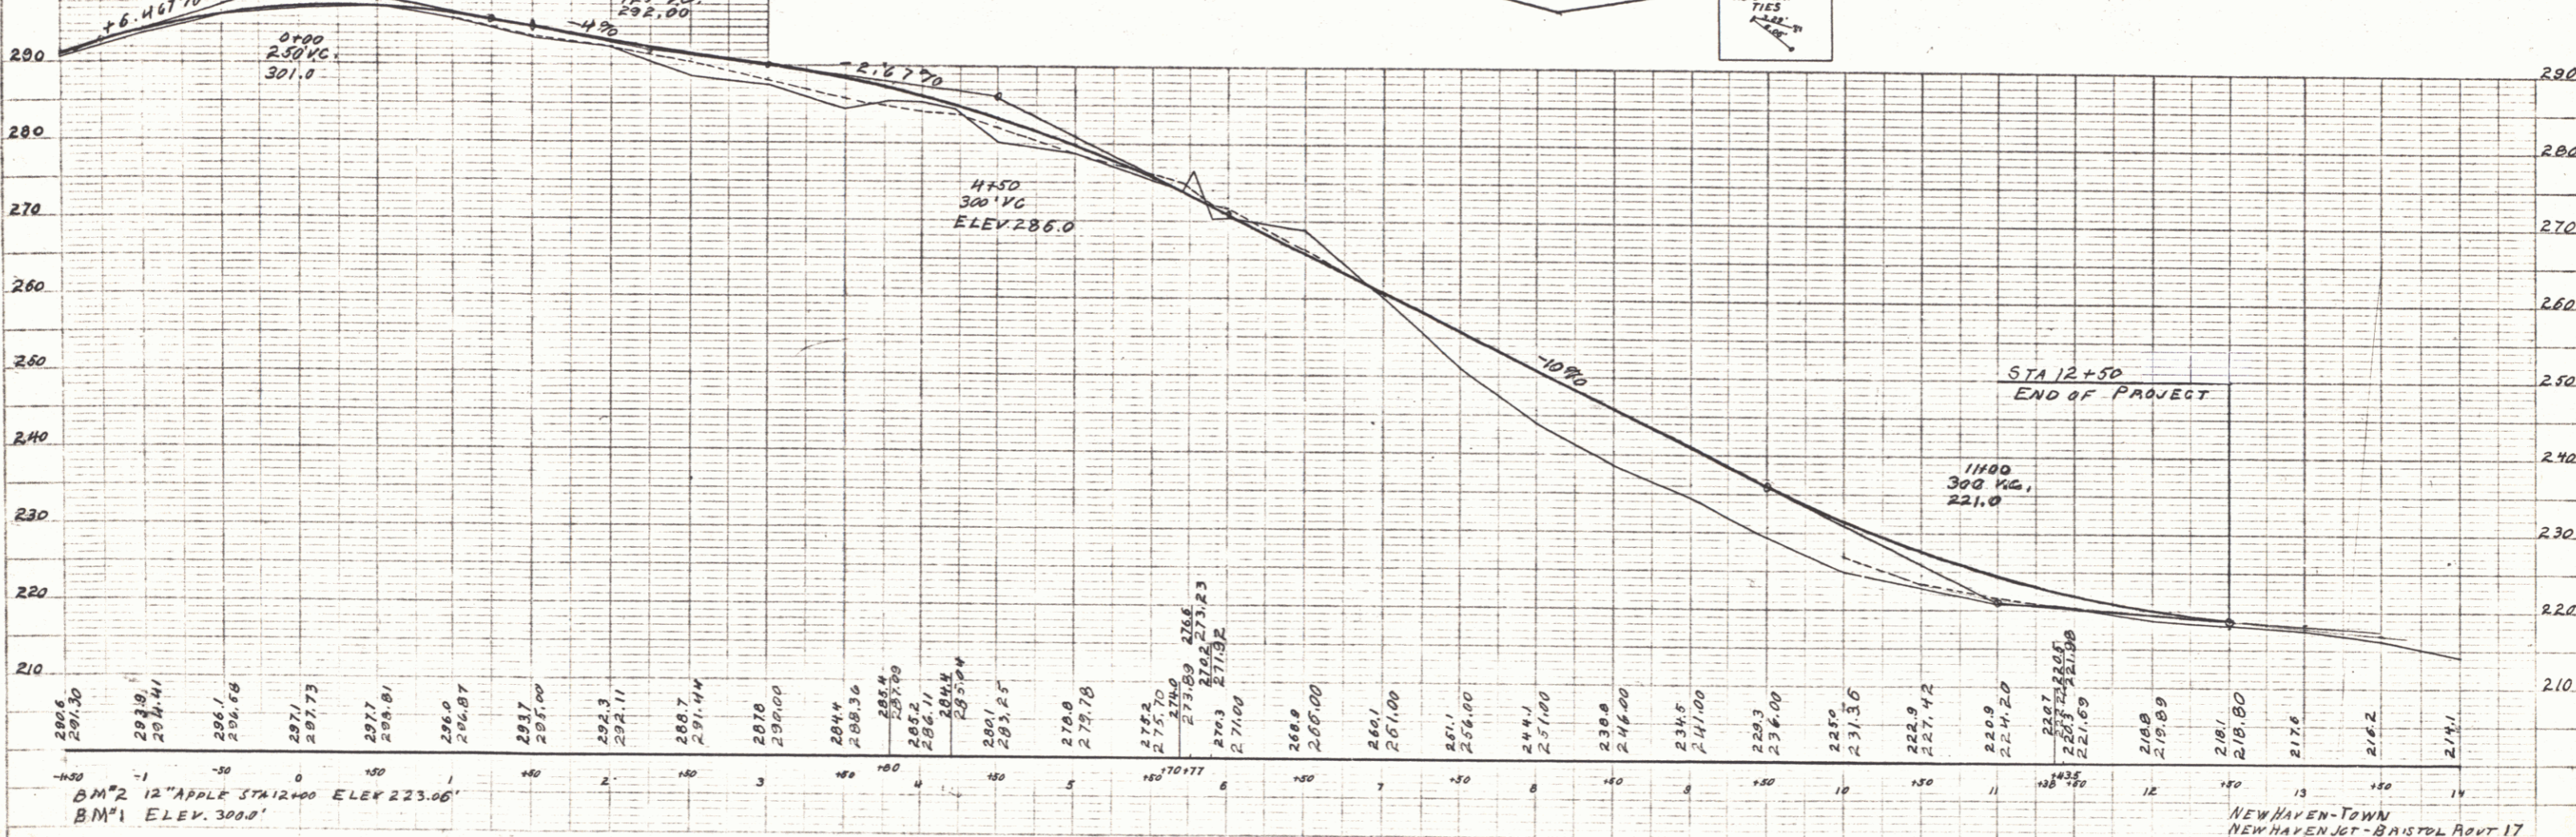


Route: VT 17
 TOWN: NEW HAVEN
 PROJECT: 1930
 DATE: 07/25/1930
 PIN: 100R52B

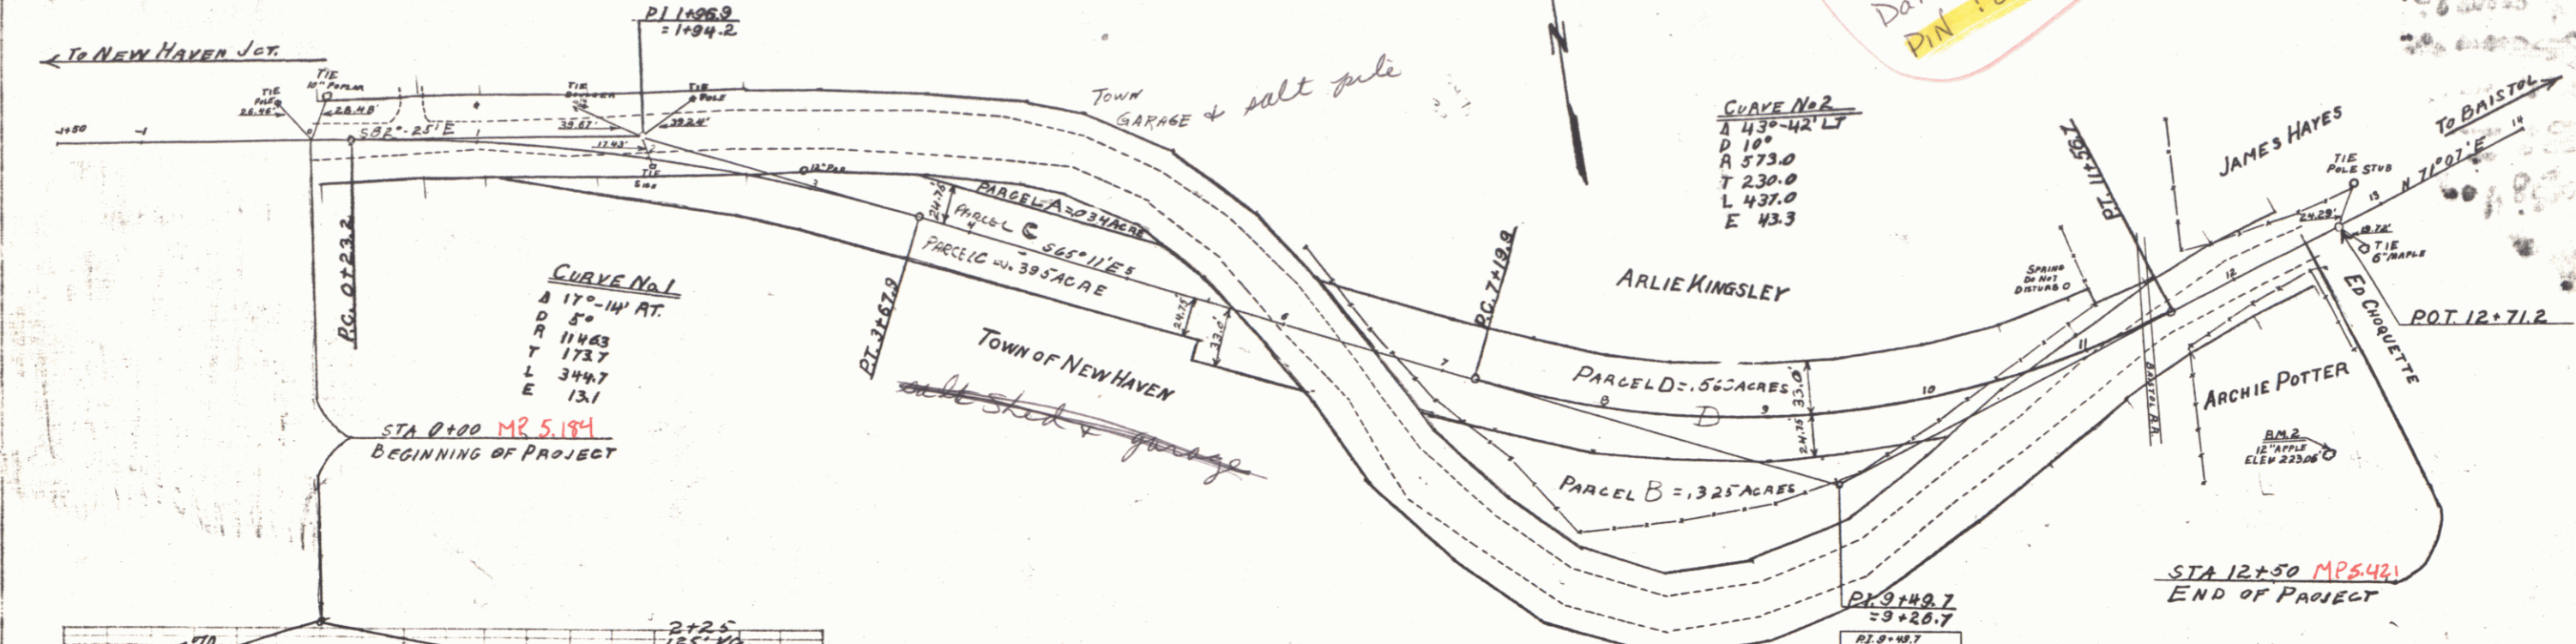

7-21-30
 D.E. HINMAN
 7-25-30

PROF. HINMAN
 7-25-30

PLATE 1 - PLAN PROFILE & P.A. & E. DIAGRAM
 100' & 50' V.S. = 1" = 100'

NEW HAVEN-TOWN
 NEW HAVEN JCT - BAISTOL ROVT 17
 SHEET 1