





Route: VT 17  
 TOWN: NEW HAVEN  
 PROJECT: 1930  
 DATE: 07/25/1930  
 PIN: 100R52B

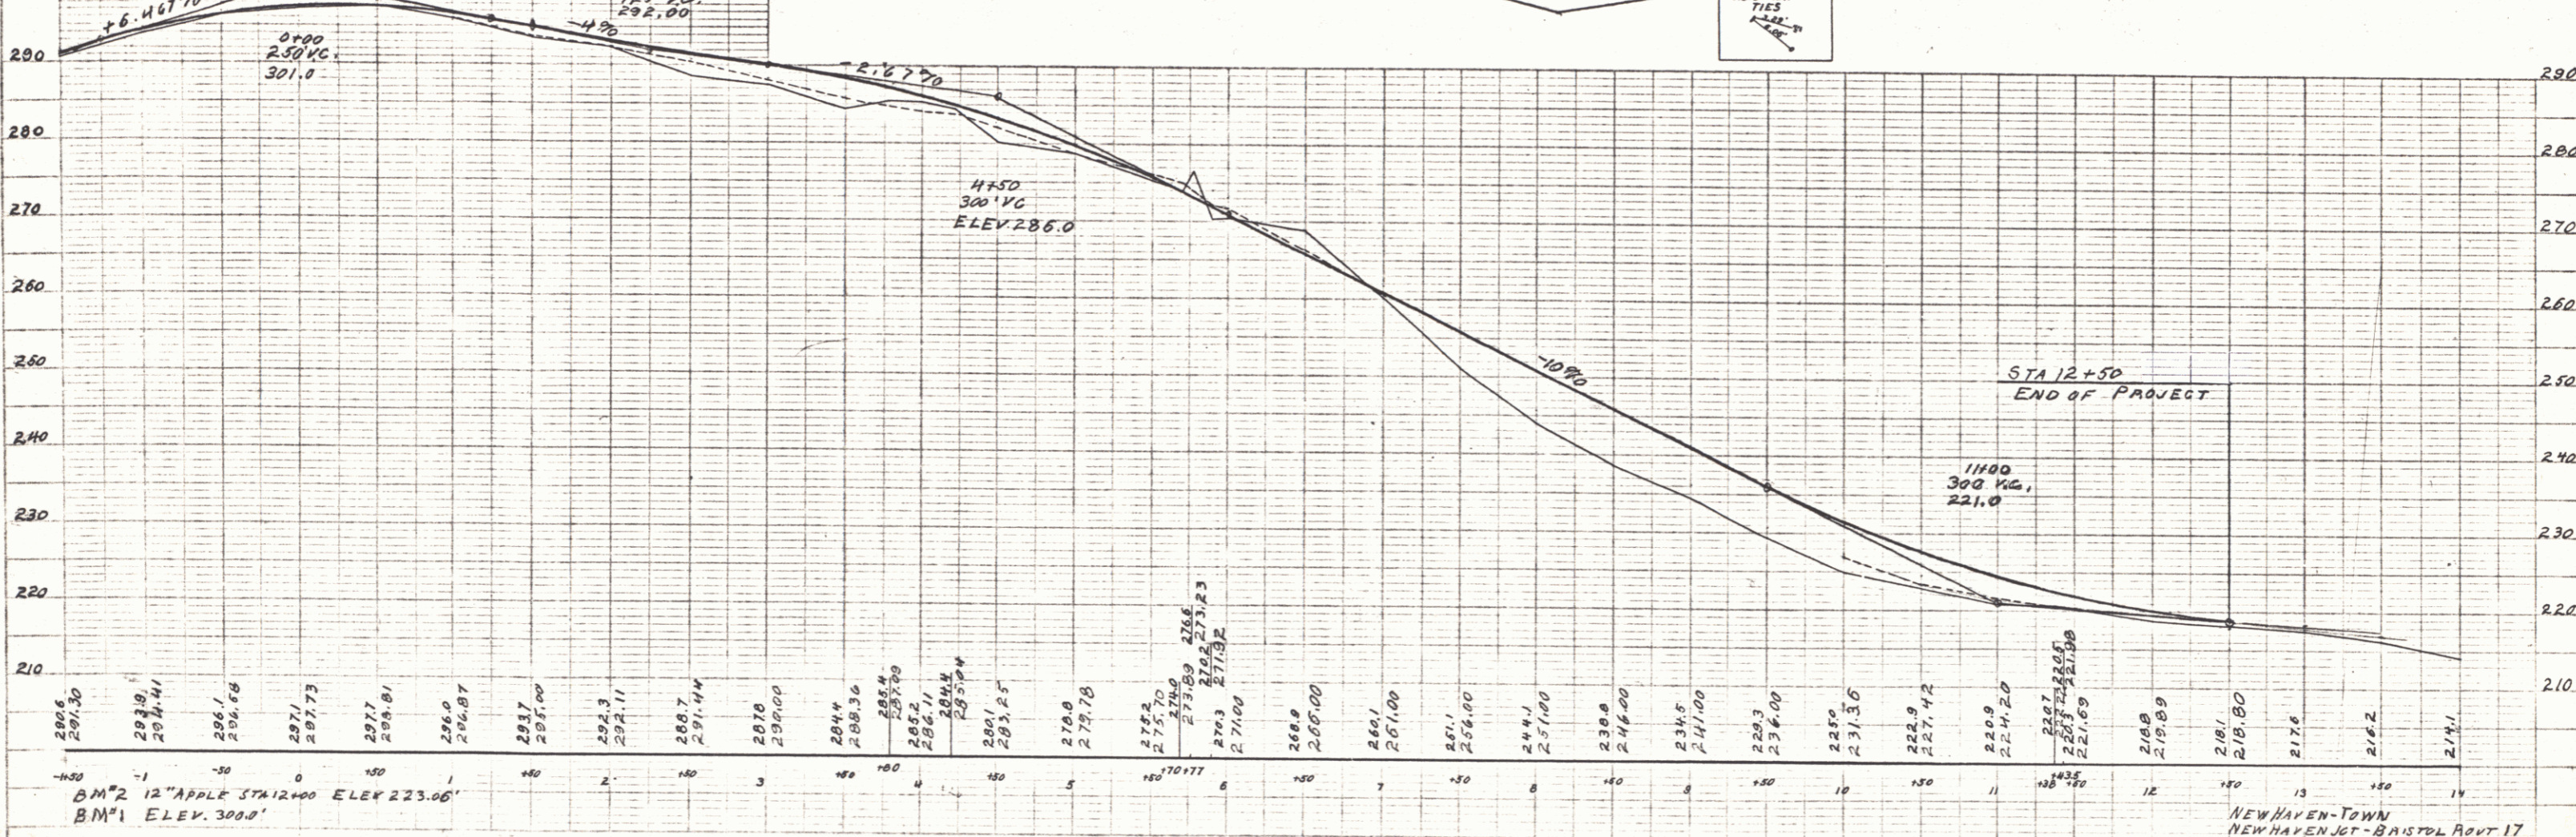

DATE: 7-25-30  
 DISE: HINMAN

DATE: 7-25-30  
 DISE: HINMAN

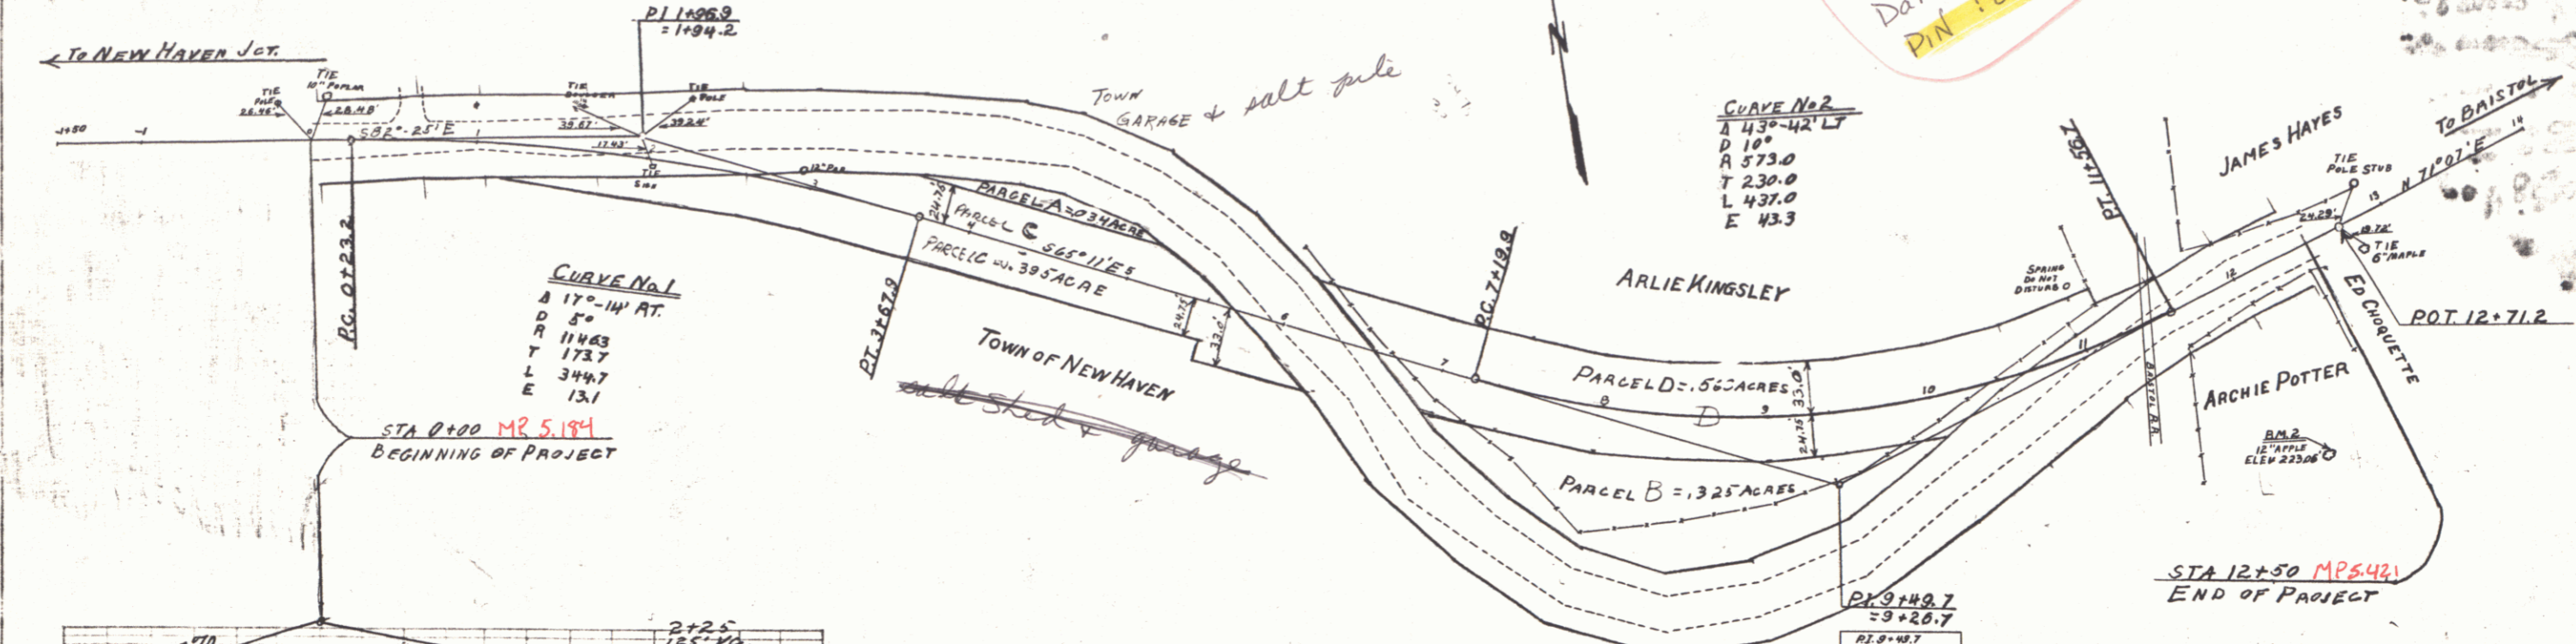

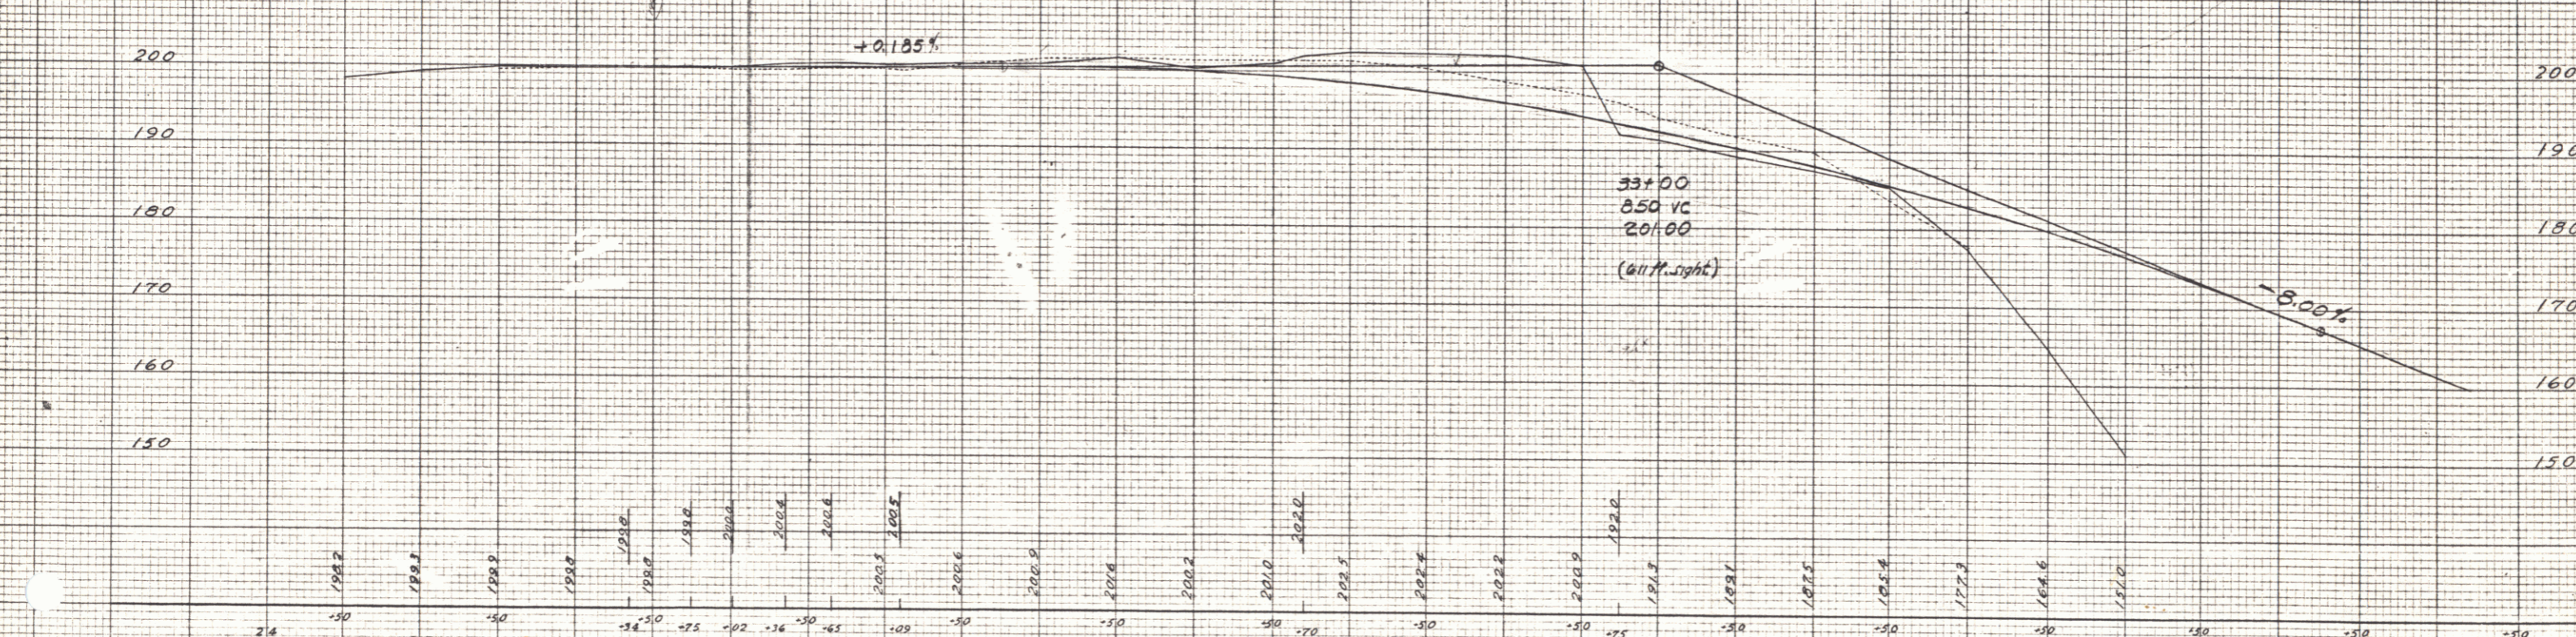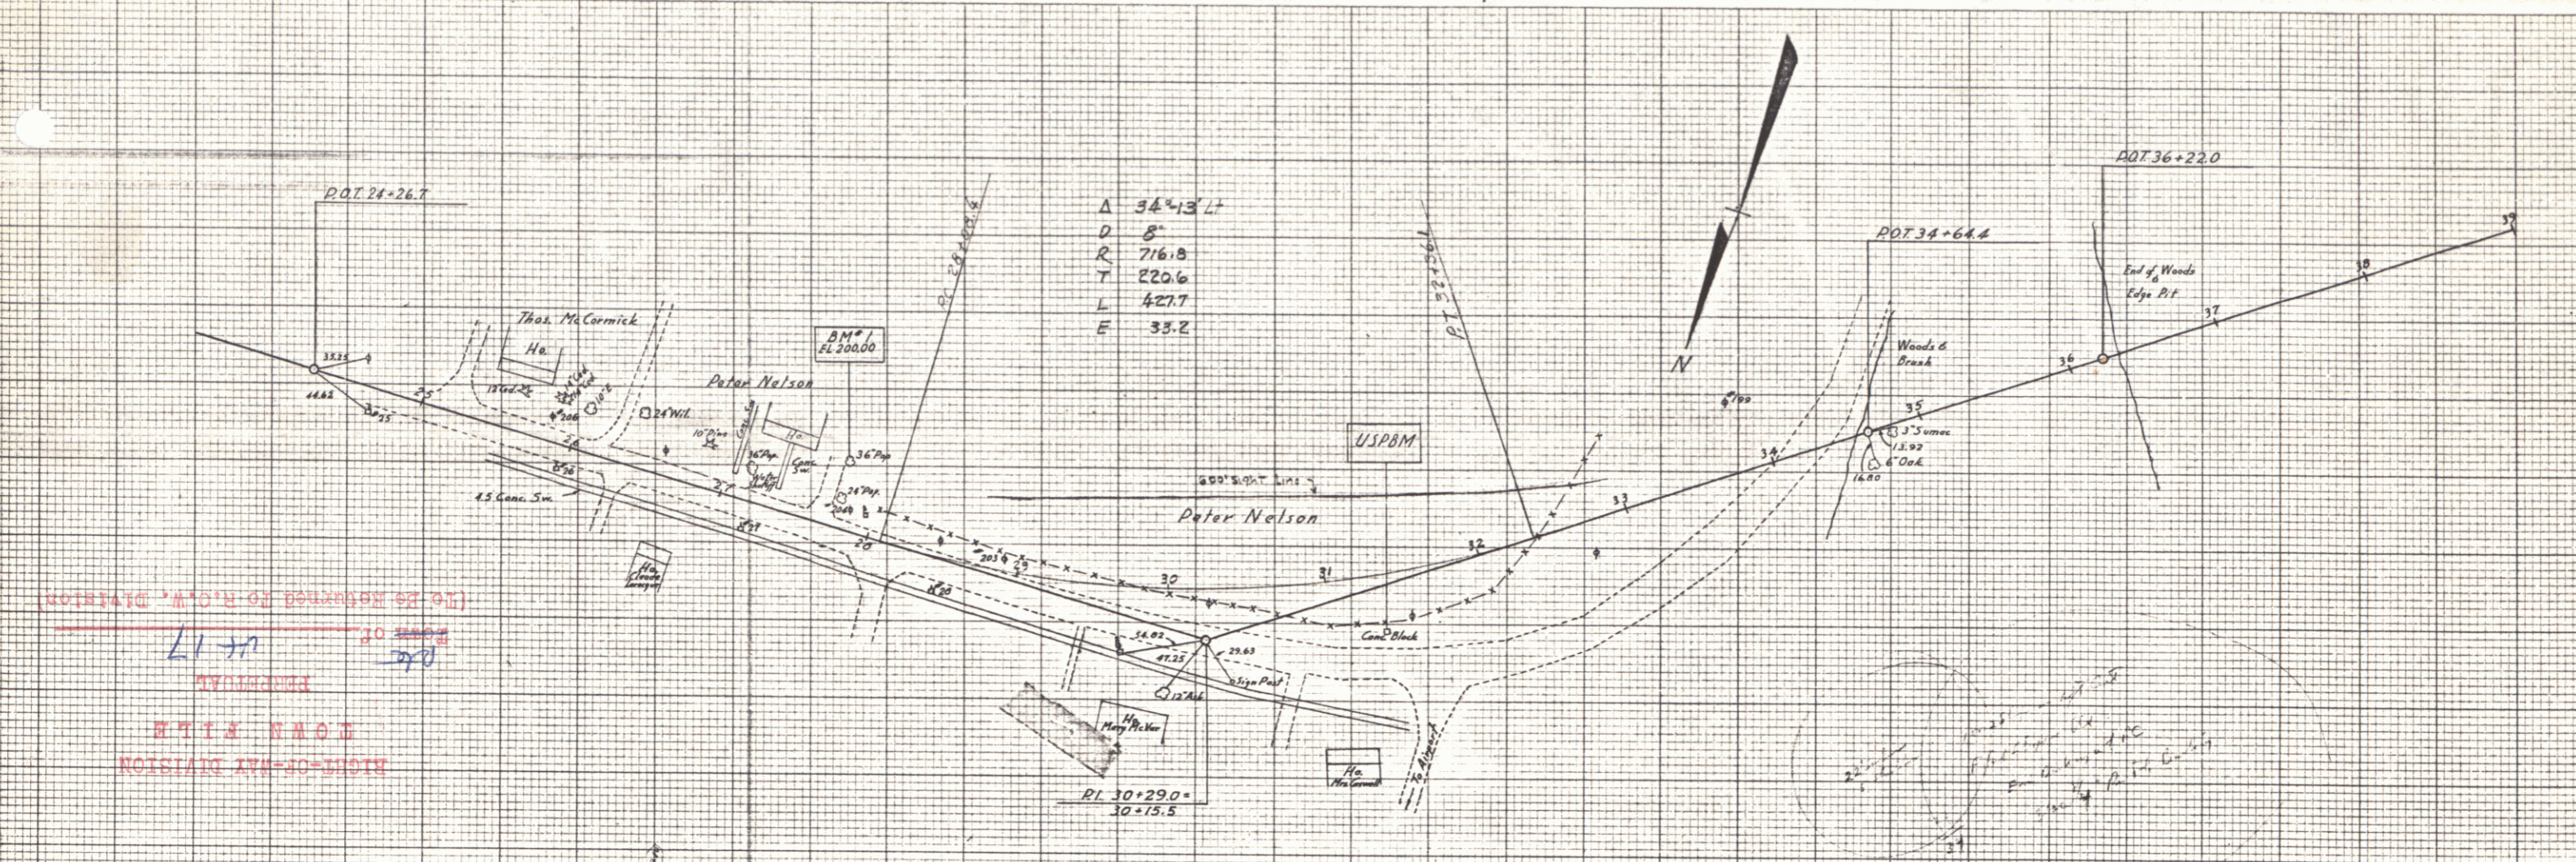

Rte 17 west end of Bristol Village.