



CONSTRUCT DRIVE
 Lt Rt
 162+62 160+50
 165+00 170+60
 171+75 175+00
 160+45
 161+50
 165+60
 166+18
 167+10
 168+00
 170+10

CONSTRUCT APPROACH
 Lt Rt
 175+40
 See Sheet 54 of 58

TWO CABLE GUARD RAIL
 Lt Rt
 173+96 - 175+00
 174+00 - 174+43
 175+71

UNCLASSIFIED CHANNEL EXCAVATION
 Lt Rt
 174+04 - 174+36
 174+12 - 174+19

PAVED DITCH
 Lt Rt
 173+00
 173+60

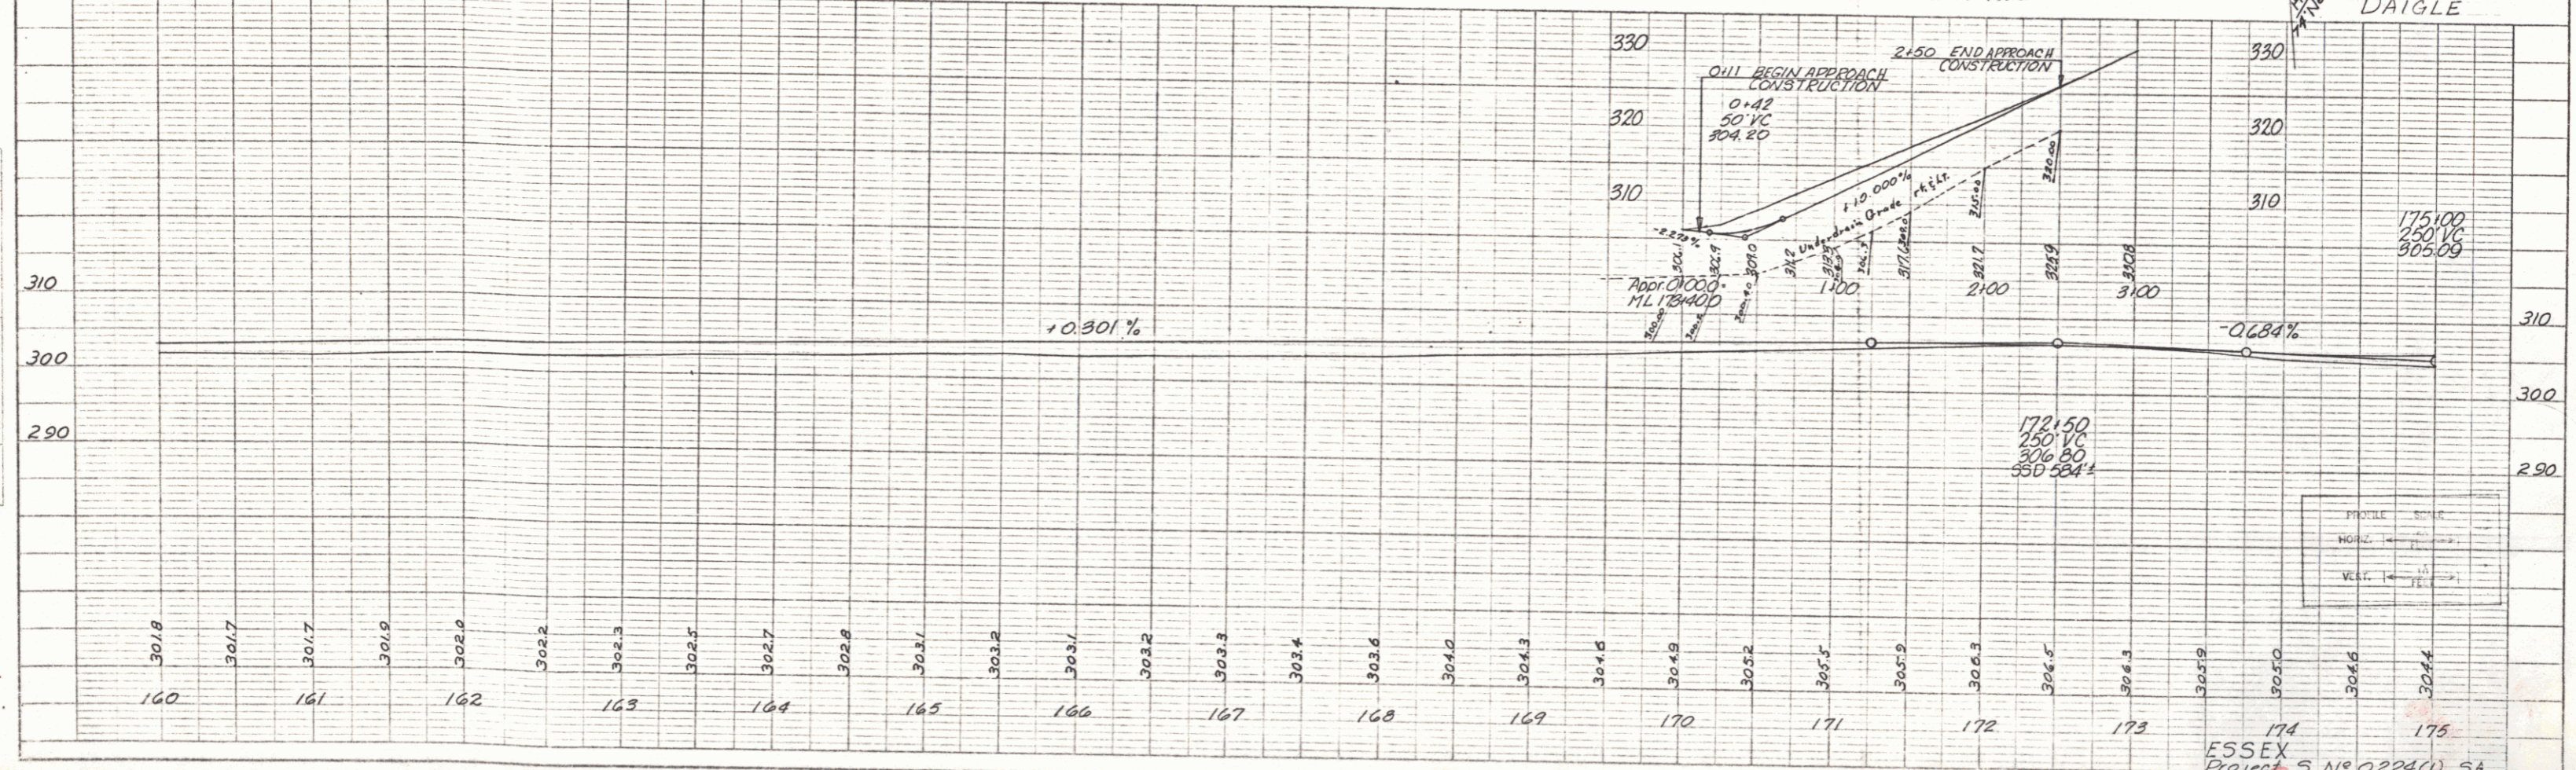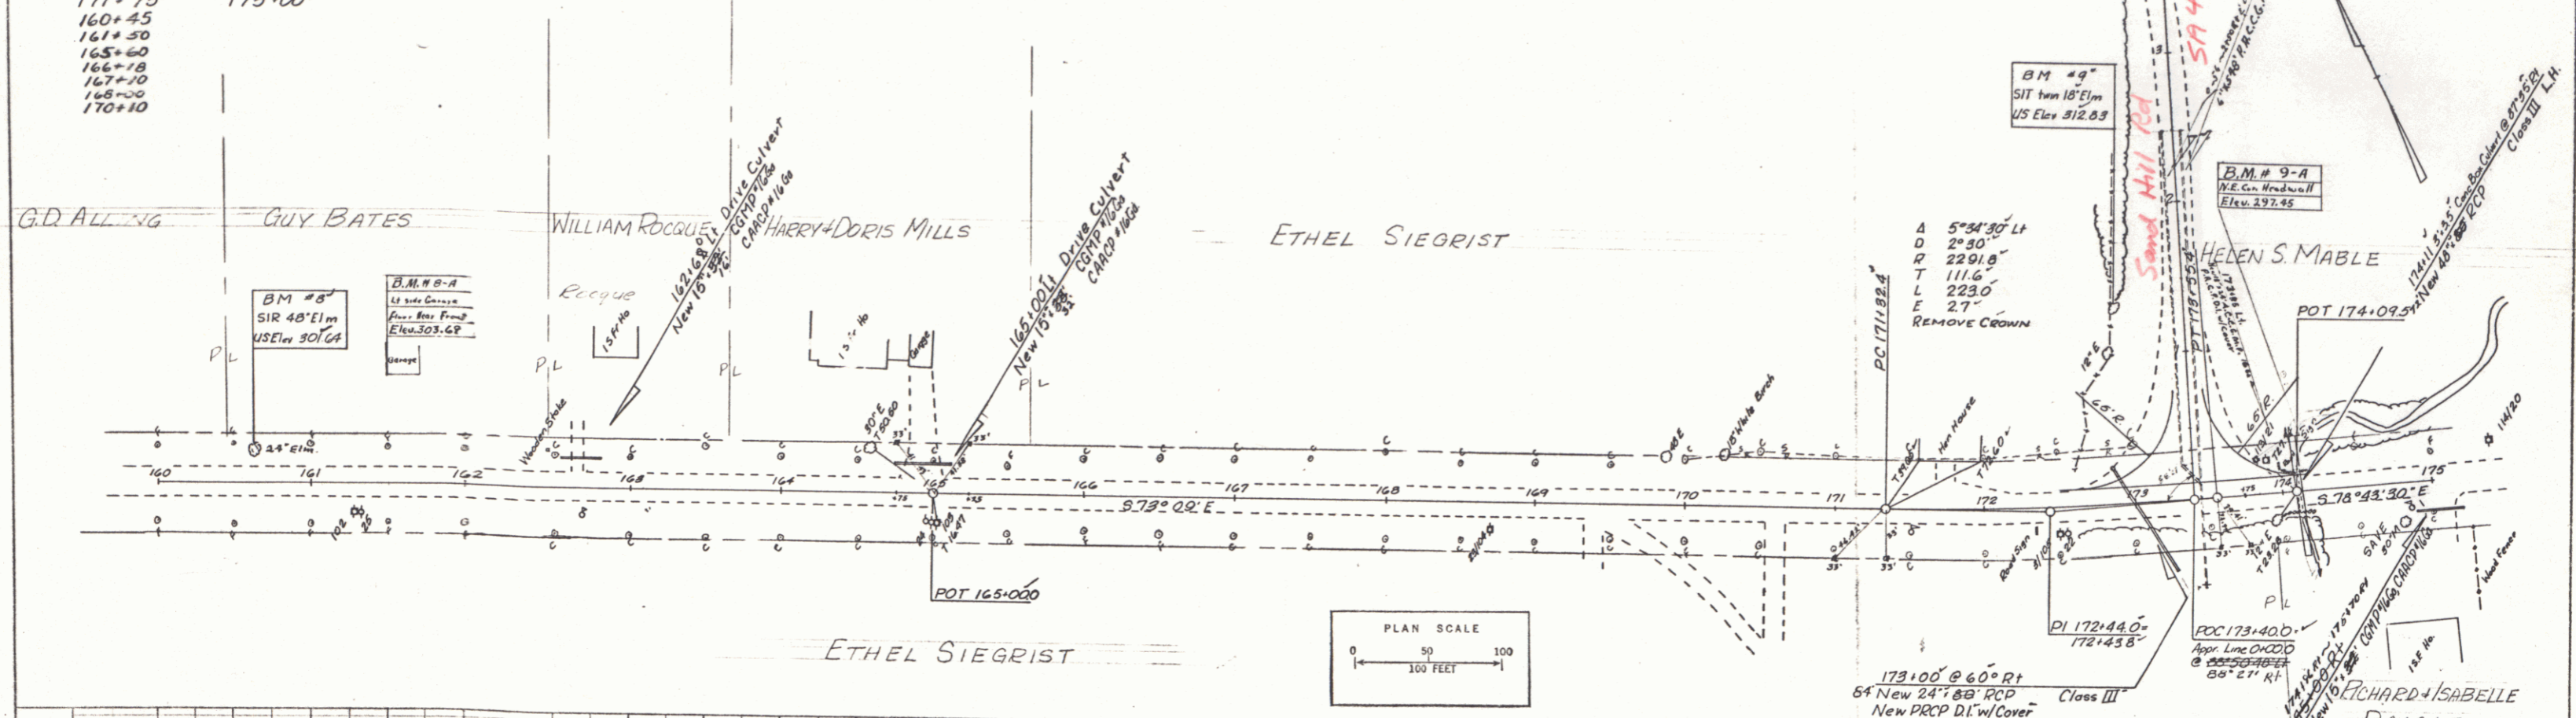

PLAN
 DATE: 5/22/20
 DRAWN BY: [Signature]
 CHECKED BY: [Signature]
 IN CHARGE: [Signature]
 NO. 1

PROFILE
 DATE: 5/22/20
 DRAWN BY: [Signature]
 CHECKED BY: [Signature]
 IN CHARGE: [Signature]
 NO. 1

FIGURE 1 PLAN PROFILE (L.R.R. & S.D. STANDARD)
 METRIC & IMPERIAL NEW YORK
 NEW YORK TO THE SEVENTH

ESSEX
 Project 5 N° 0224(1) SA
 Sheet 20 of 58 Sheets