


CURVE DATA
 Δ 8° 30'
 D 5° LT
 R 1145.92
 T 80.6
 L 161.0
 E 2.81

CURVE DATA
 Δ 18° 07' 30"
 D 6° 15' LT
 R 916.73
 T 146.2
 L 290.0
 E 11.59

CURVE DATA
 Δ 19° 22' 30"
 D 7° 45' LT
 R 739.30
 T 126.2
 L 250.0
 E 10.7

CURVE DATA
 Δ 6° 0"
 D 12° 11'
 R 17.47
 T 25.7
 L 50.0
 E 0.65

CURVE DATA
 Δ 13° 14' 20"
 D 9° 15' LT
 R 619.41
 T 71.9
 L 143.1
 E 4.2

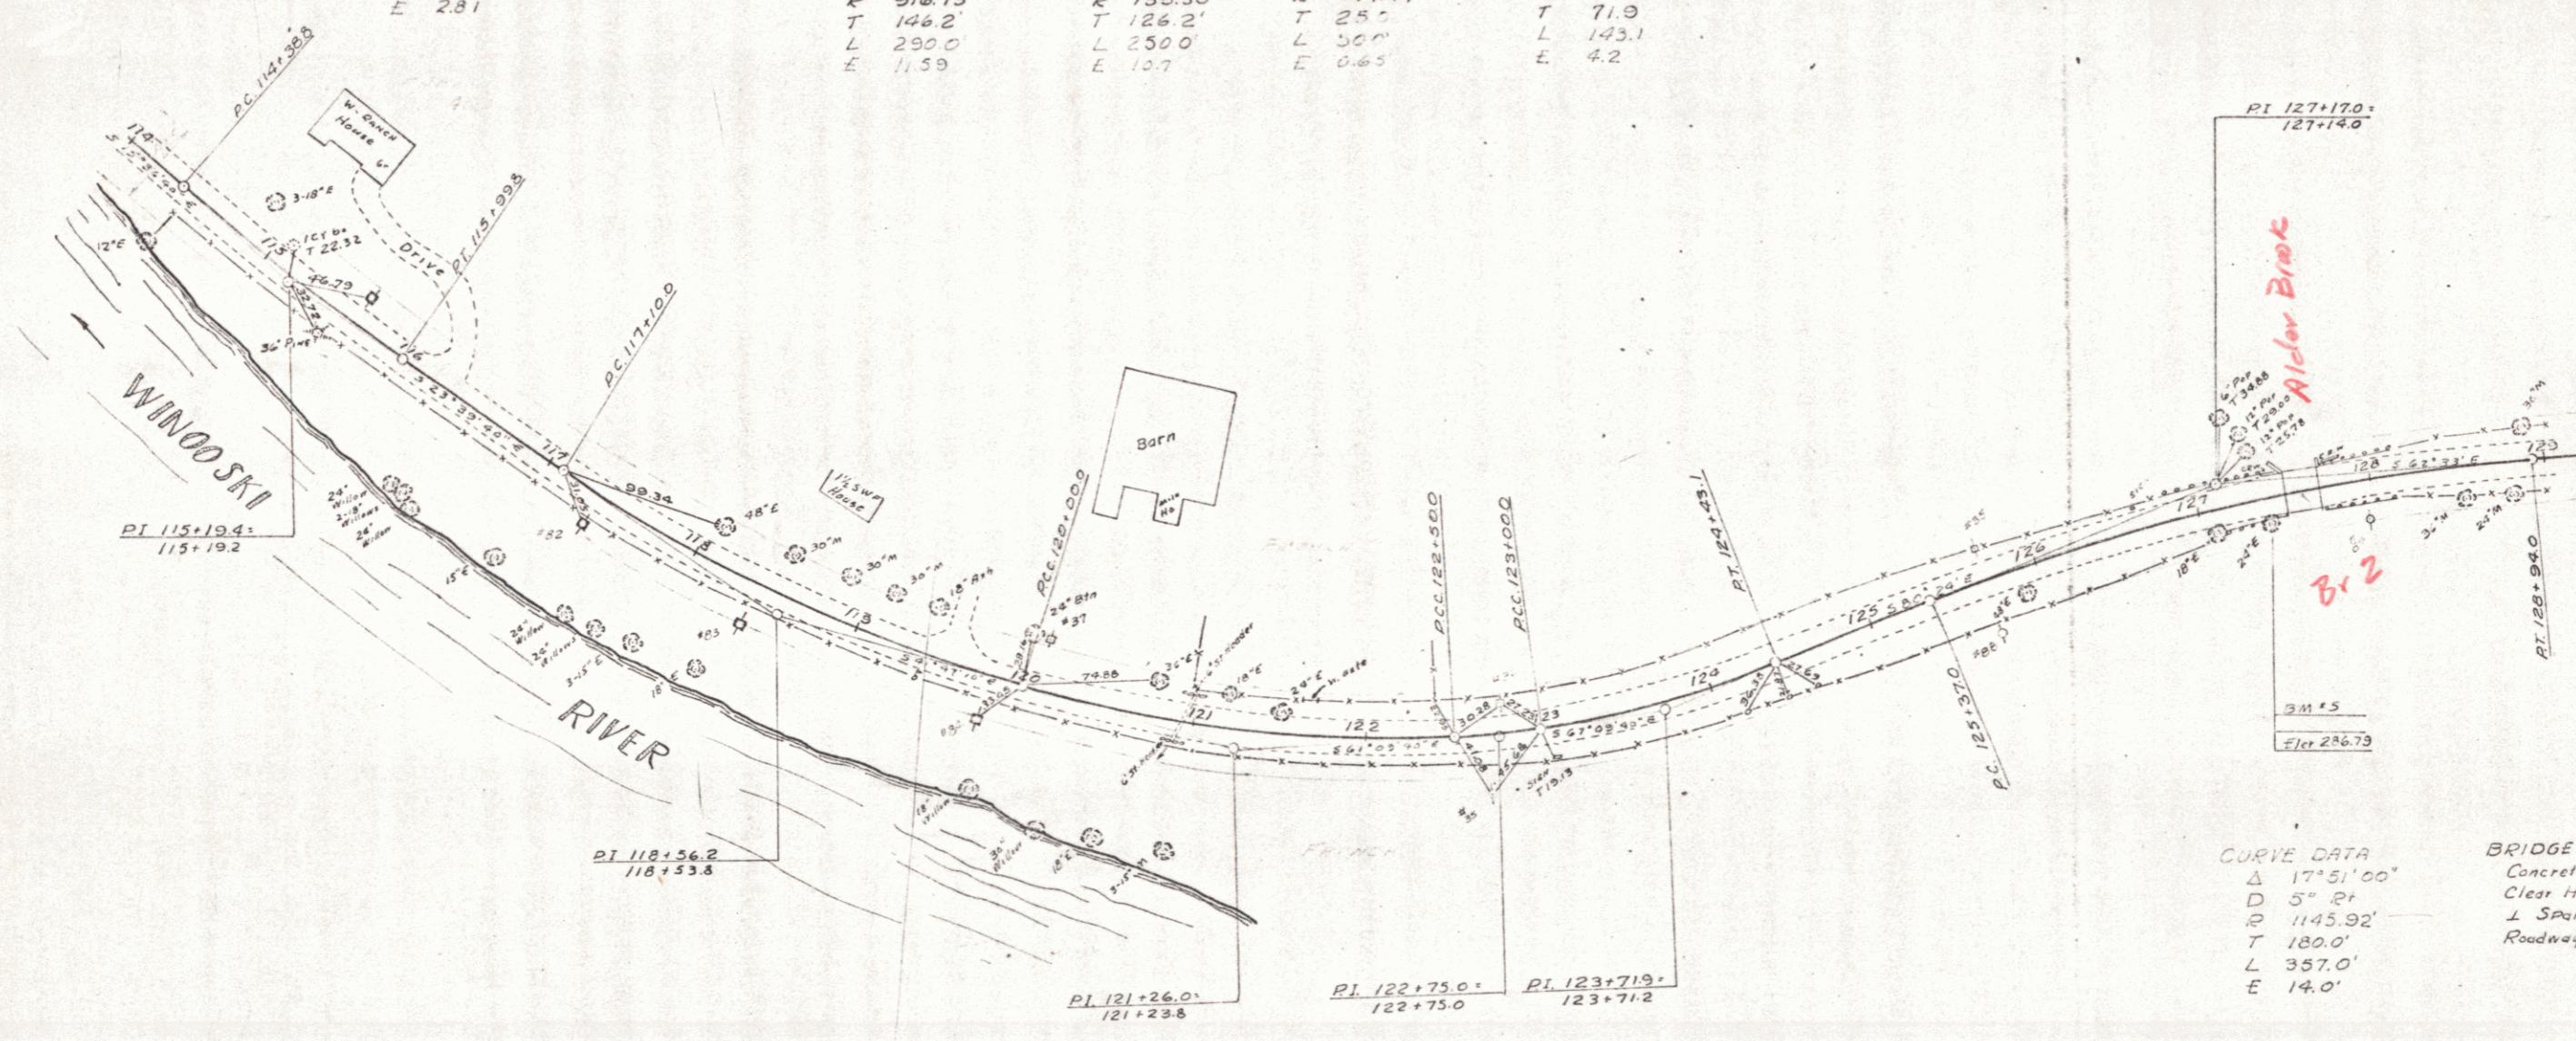

CURVE DATA
 Δ 17° 51' 00"
 D 5° RT
 R 1145.92
 T 180.0
 L 357.0
 E 14.0

BRIDGE DATA
 Concrete T-Beam
 Clear Height 12'0"
 L Span 19'0"
 Roadway Width 25'0"

SURVEYED BY L. G. LEE, DATE MAR 66
 DRAWN BY J. G. LEE, DATE APR 66
 CHECKED BY J. G. LEE, DATE APR 66

SHEET 4