



CURVE DATA  
 $\Delta$  3° 36' 00"  
 D 1° 30' LF  
 R 3819.72'  
 T 120.1'  
 L 240.0'  
 E 18'

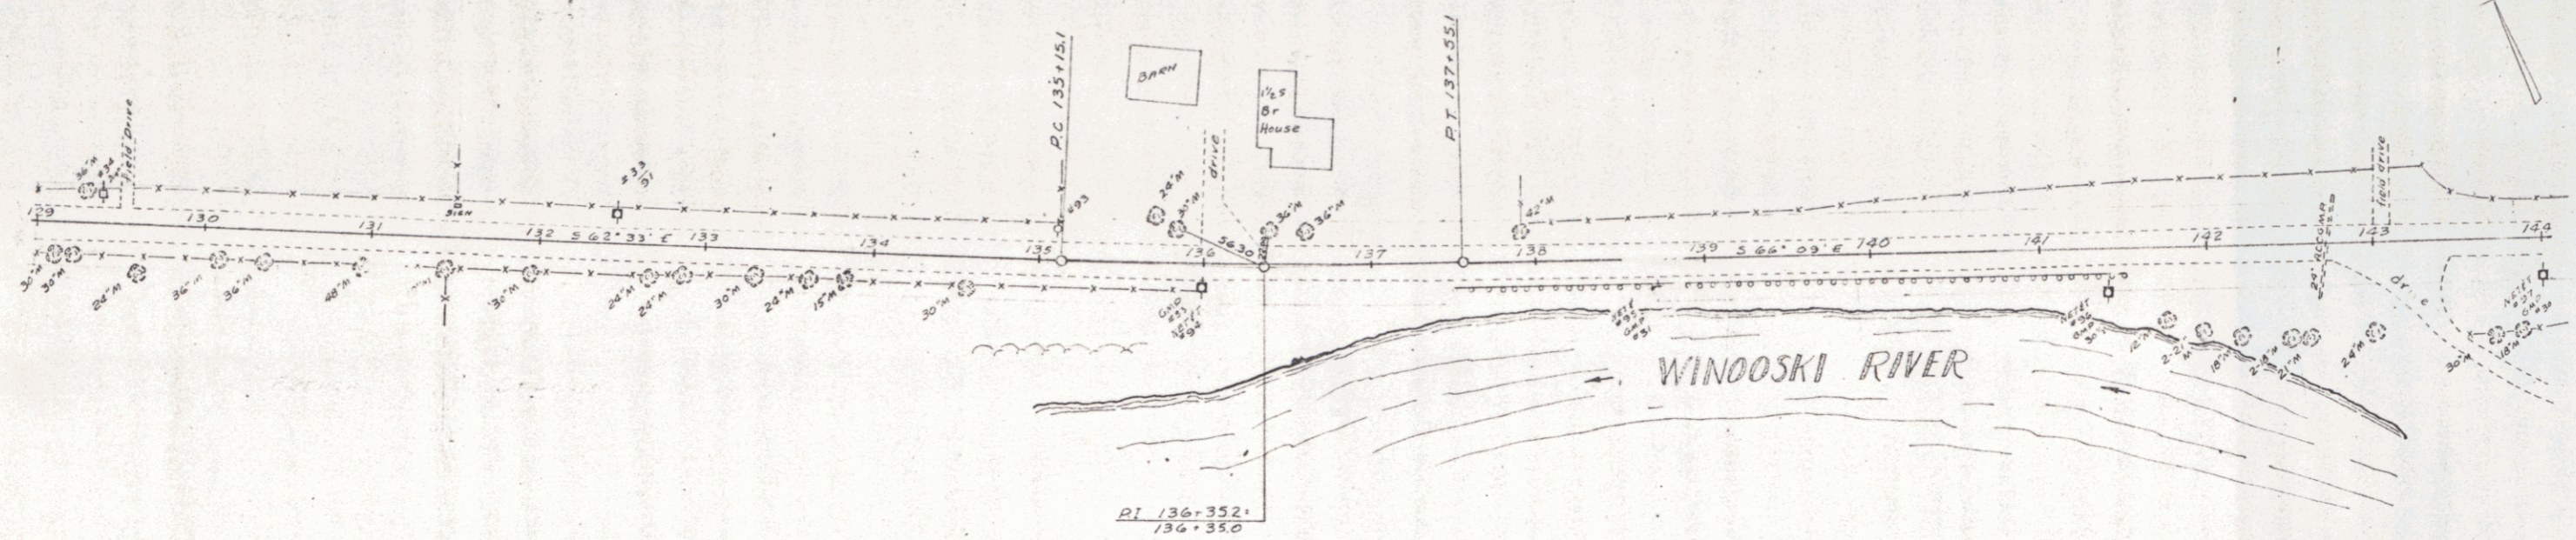

CURVE DATA  
 $\Delta$  7° 32' 00"  
 D 1° 45' LF  
 R 3279.04'  
 T 215.6'  
 L 430.5'  
 E 7.0'

CURVE DATA  
 $\Delta$  0° 32' 00" RT  
 No Curve Run

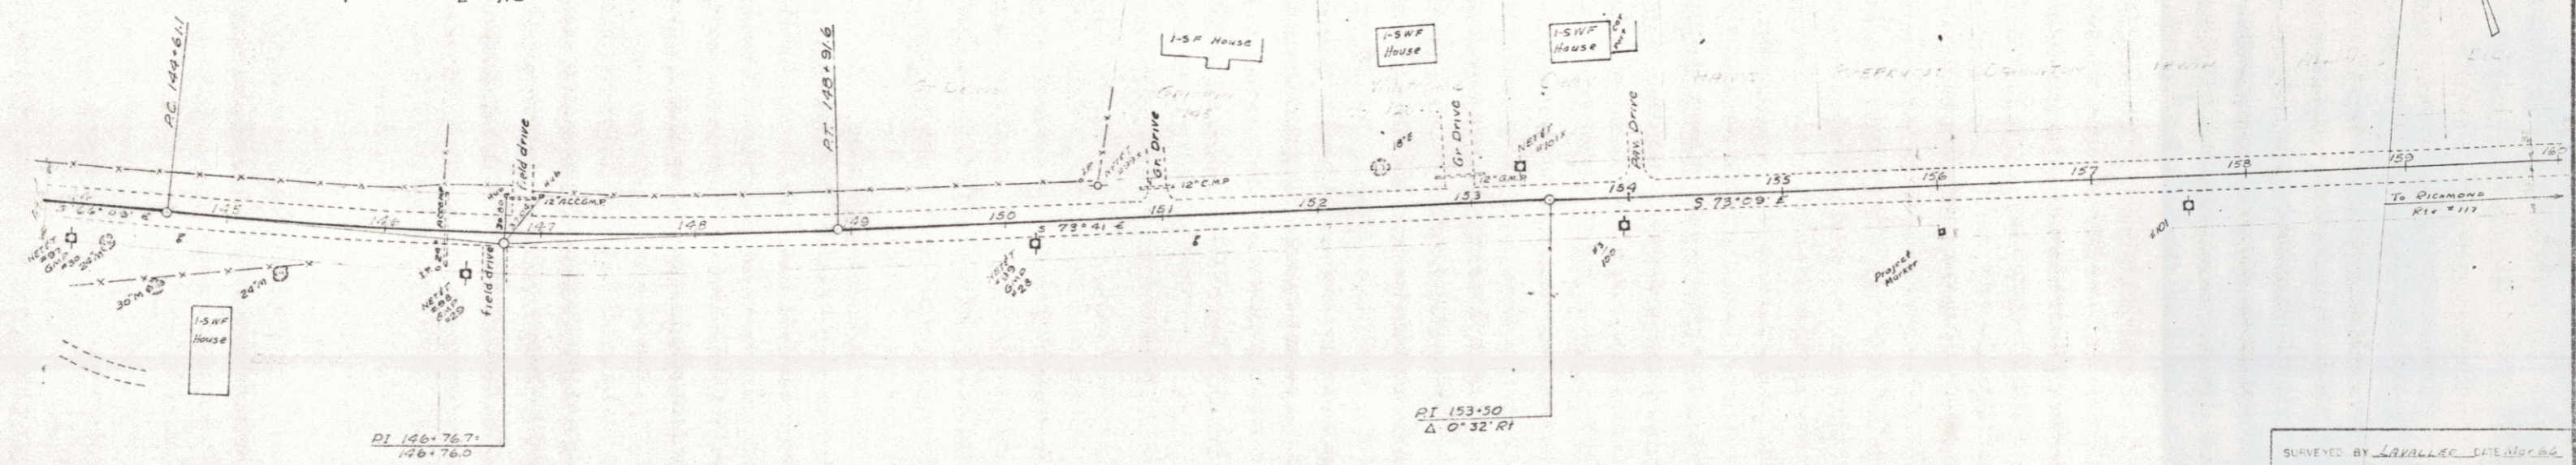

SURVEYED BY L. VALLEE DATE 10/26/66  
 DRAWN BY J. S. PATTON DATE 11/1/66  
 TRACED BY J. S. PATTON DATE 10/26/66  
 FROM Rte #117

SHEETS