



PLAN  
 SHEET NO. 5-30(2)  
 DATE 1948  
 REVISIONS  
 1. 1948  
 2. 1948

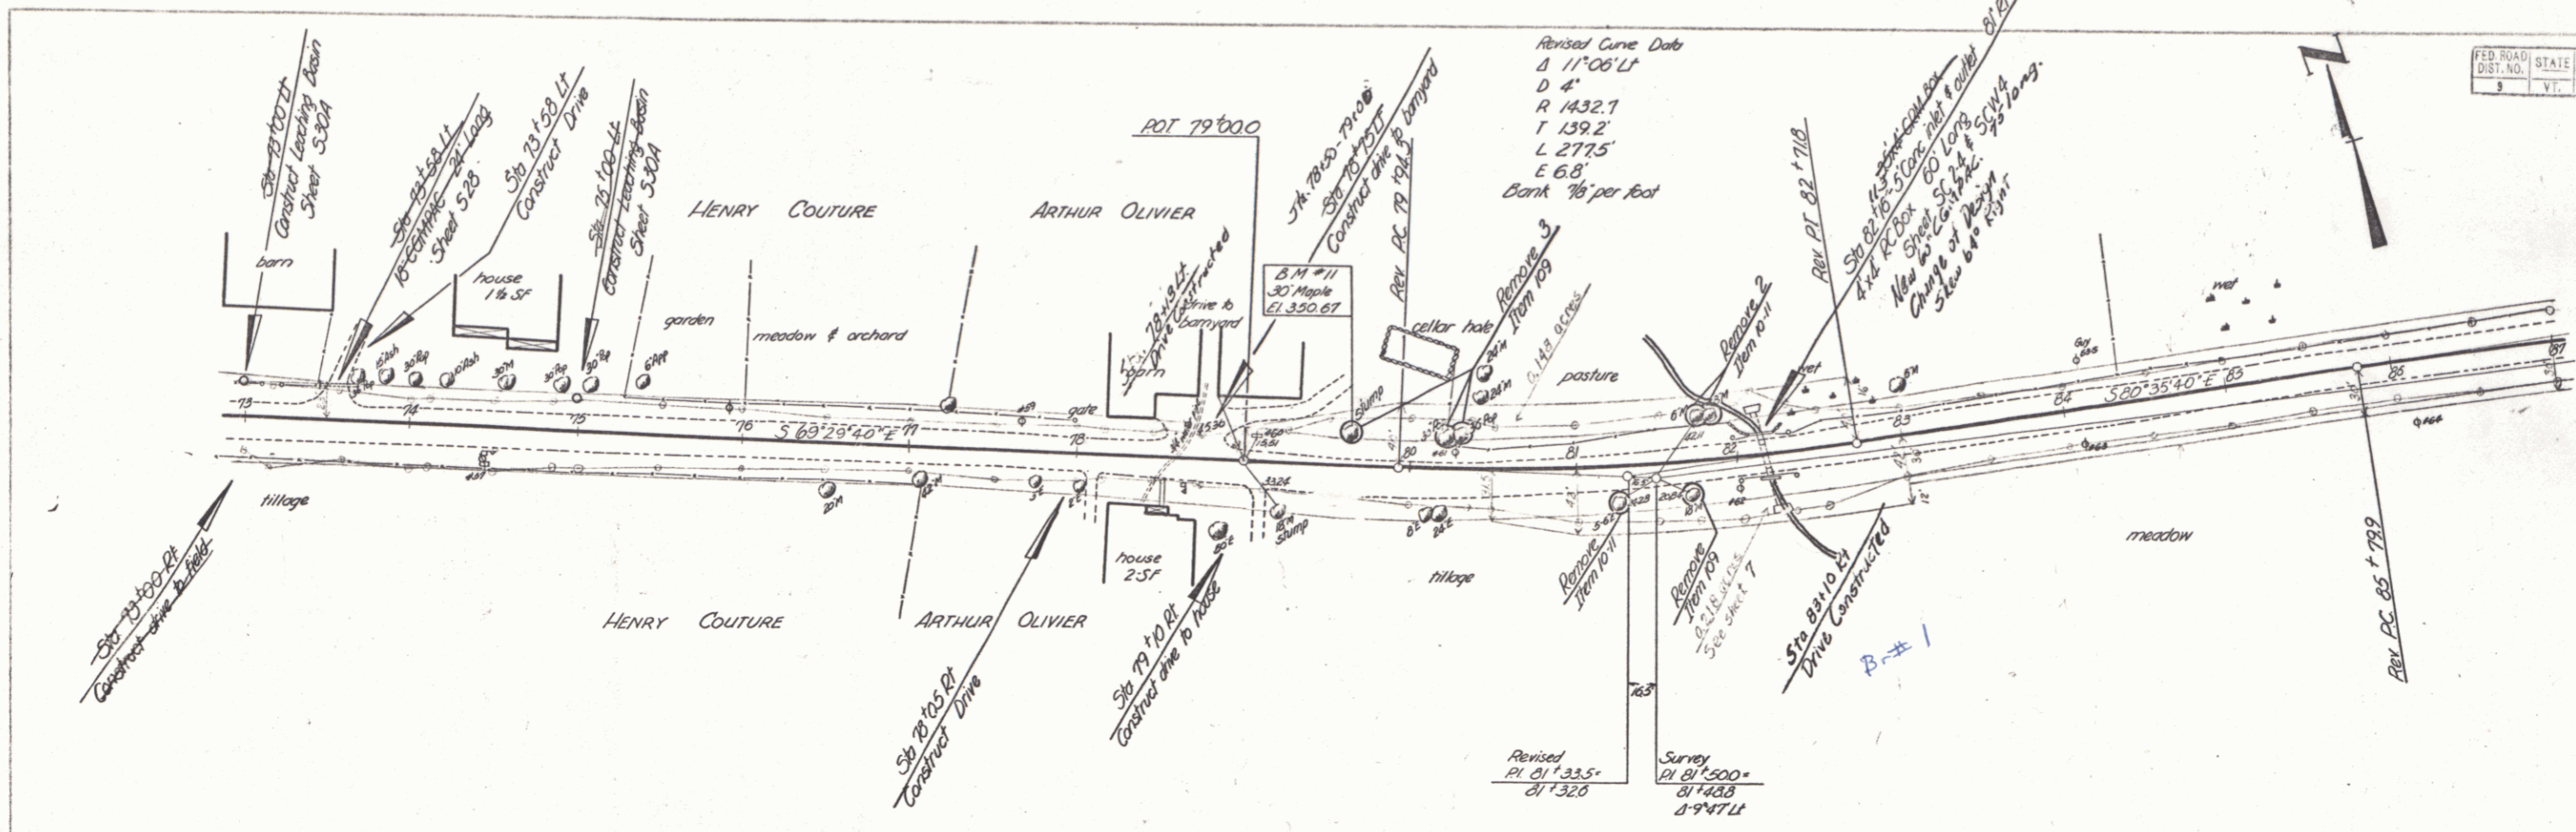

FED. ROAD DIST. NO.	STATE	PROJ. NO.	FISCAL YEAR	SHEET NO.	TOTAL SHEETS
3	VT.	3-32(2)	1948	7	29

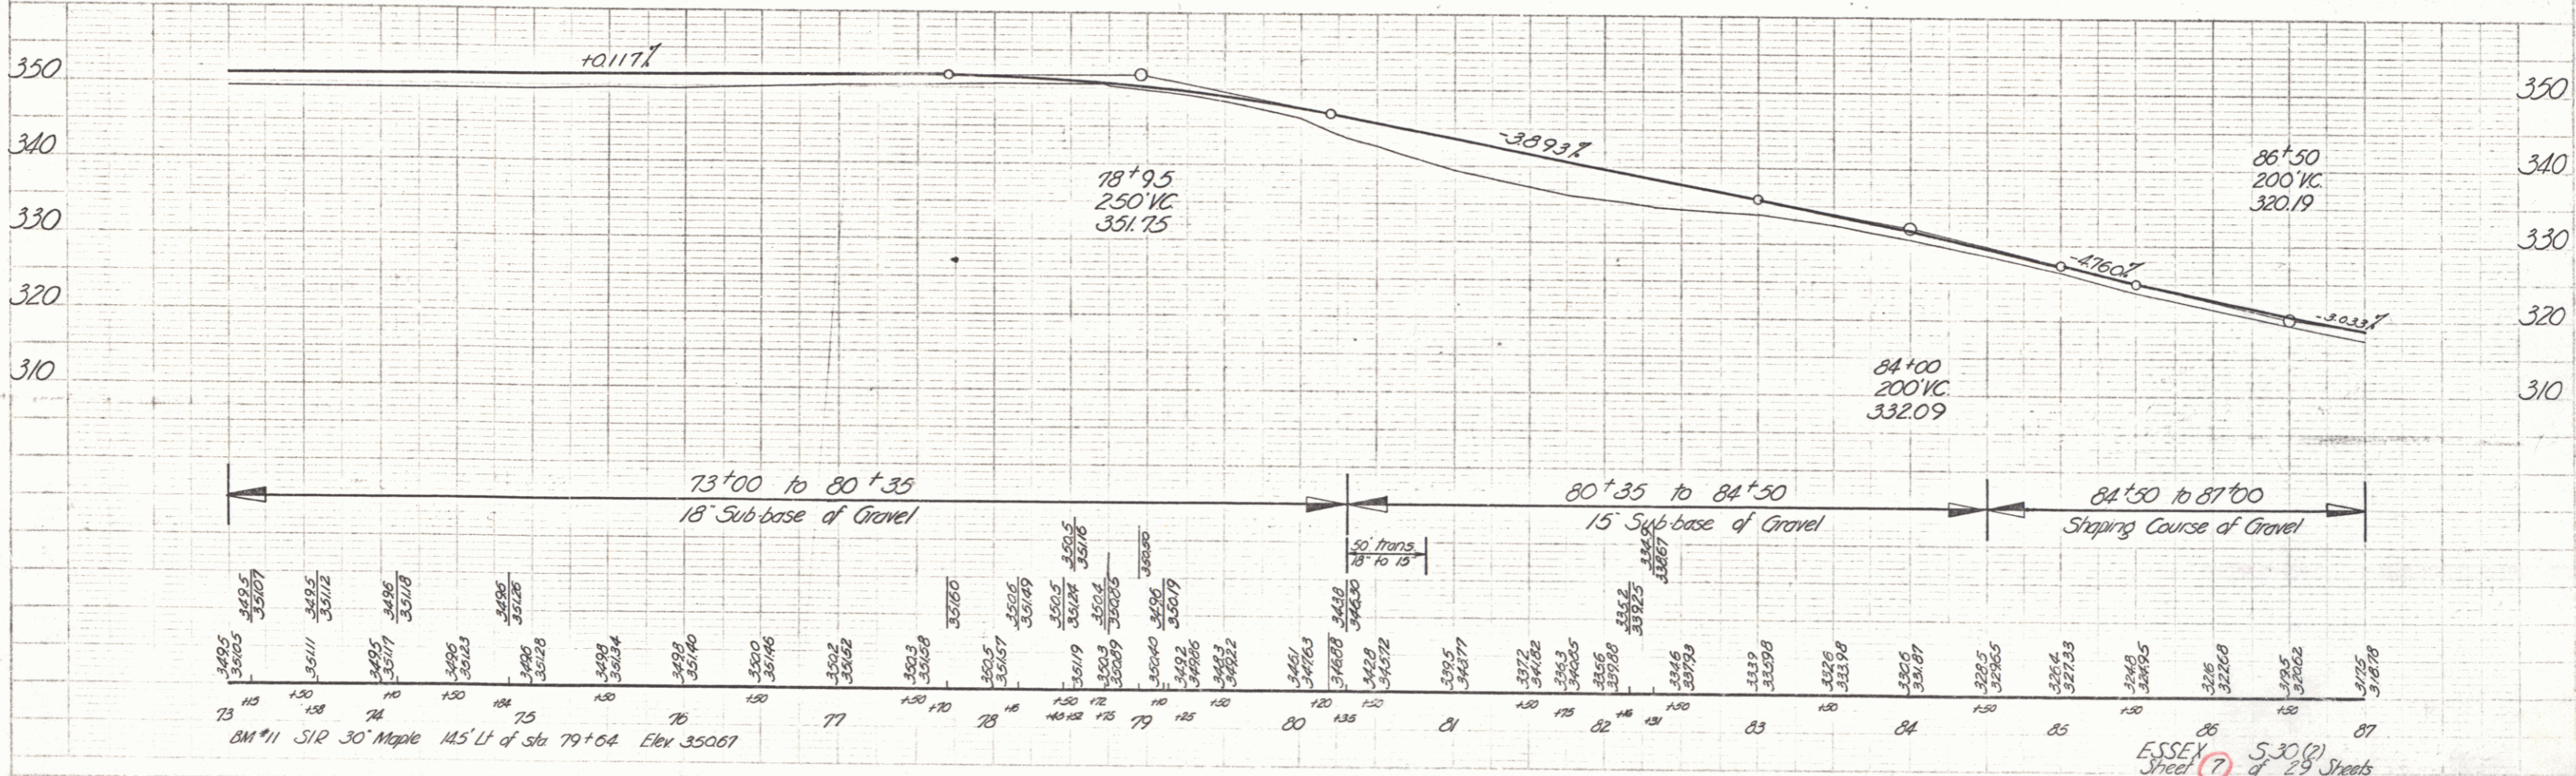

ESSEX  
 Sheet 5-30(2)  
 of 29 Sheets