


Revised Curve Data
 Δ 11'-09" Rt
 D 1'-30"
 R 301/28
 T 3728
 L 7433
 E 181
 Bank 4% per ft

STA 93+00
 END PROJECT S.30(2)
 End original project
 Begin Extension

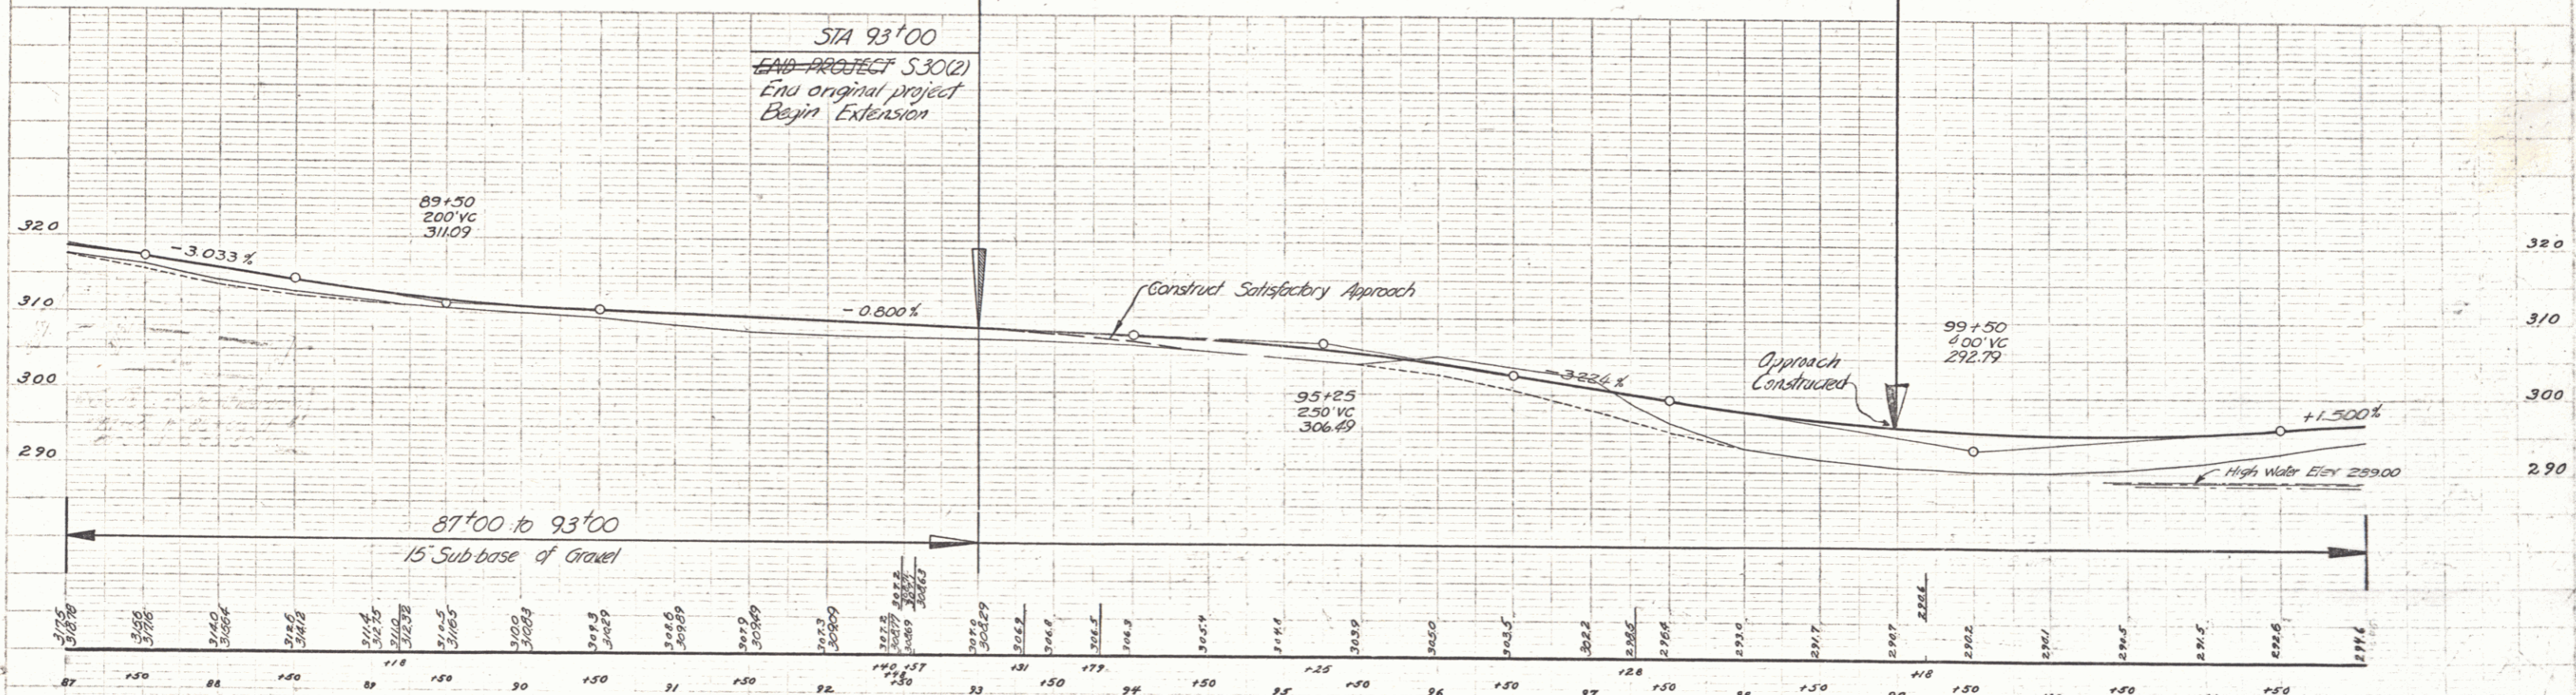

BM #12 S.I.R. 10" Oak 49.5' Lt Sta 87+65 Elev. 320.73
 BM #13 S.I.R. Twin 10" Elm 37' Lt Sta 92+73 Elev. 308.25
 BM #14 S.I.R. 12" Elm Stump 78' Lt Sta 99+30 Elev. 291.96