


DATE: 12/74
 DRAWN BY: J. BARRIS
 CHECKED BY: J. BARRIS
 TRACED BY: J. BARRIS

DATE: 12/74
 DRAWN BY: J. BARRIS
 CHECKED BY: J. BARRIS
 TRACED BY: J. BARRIS

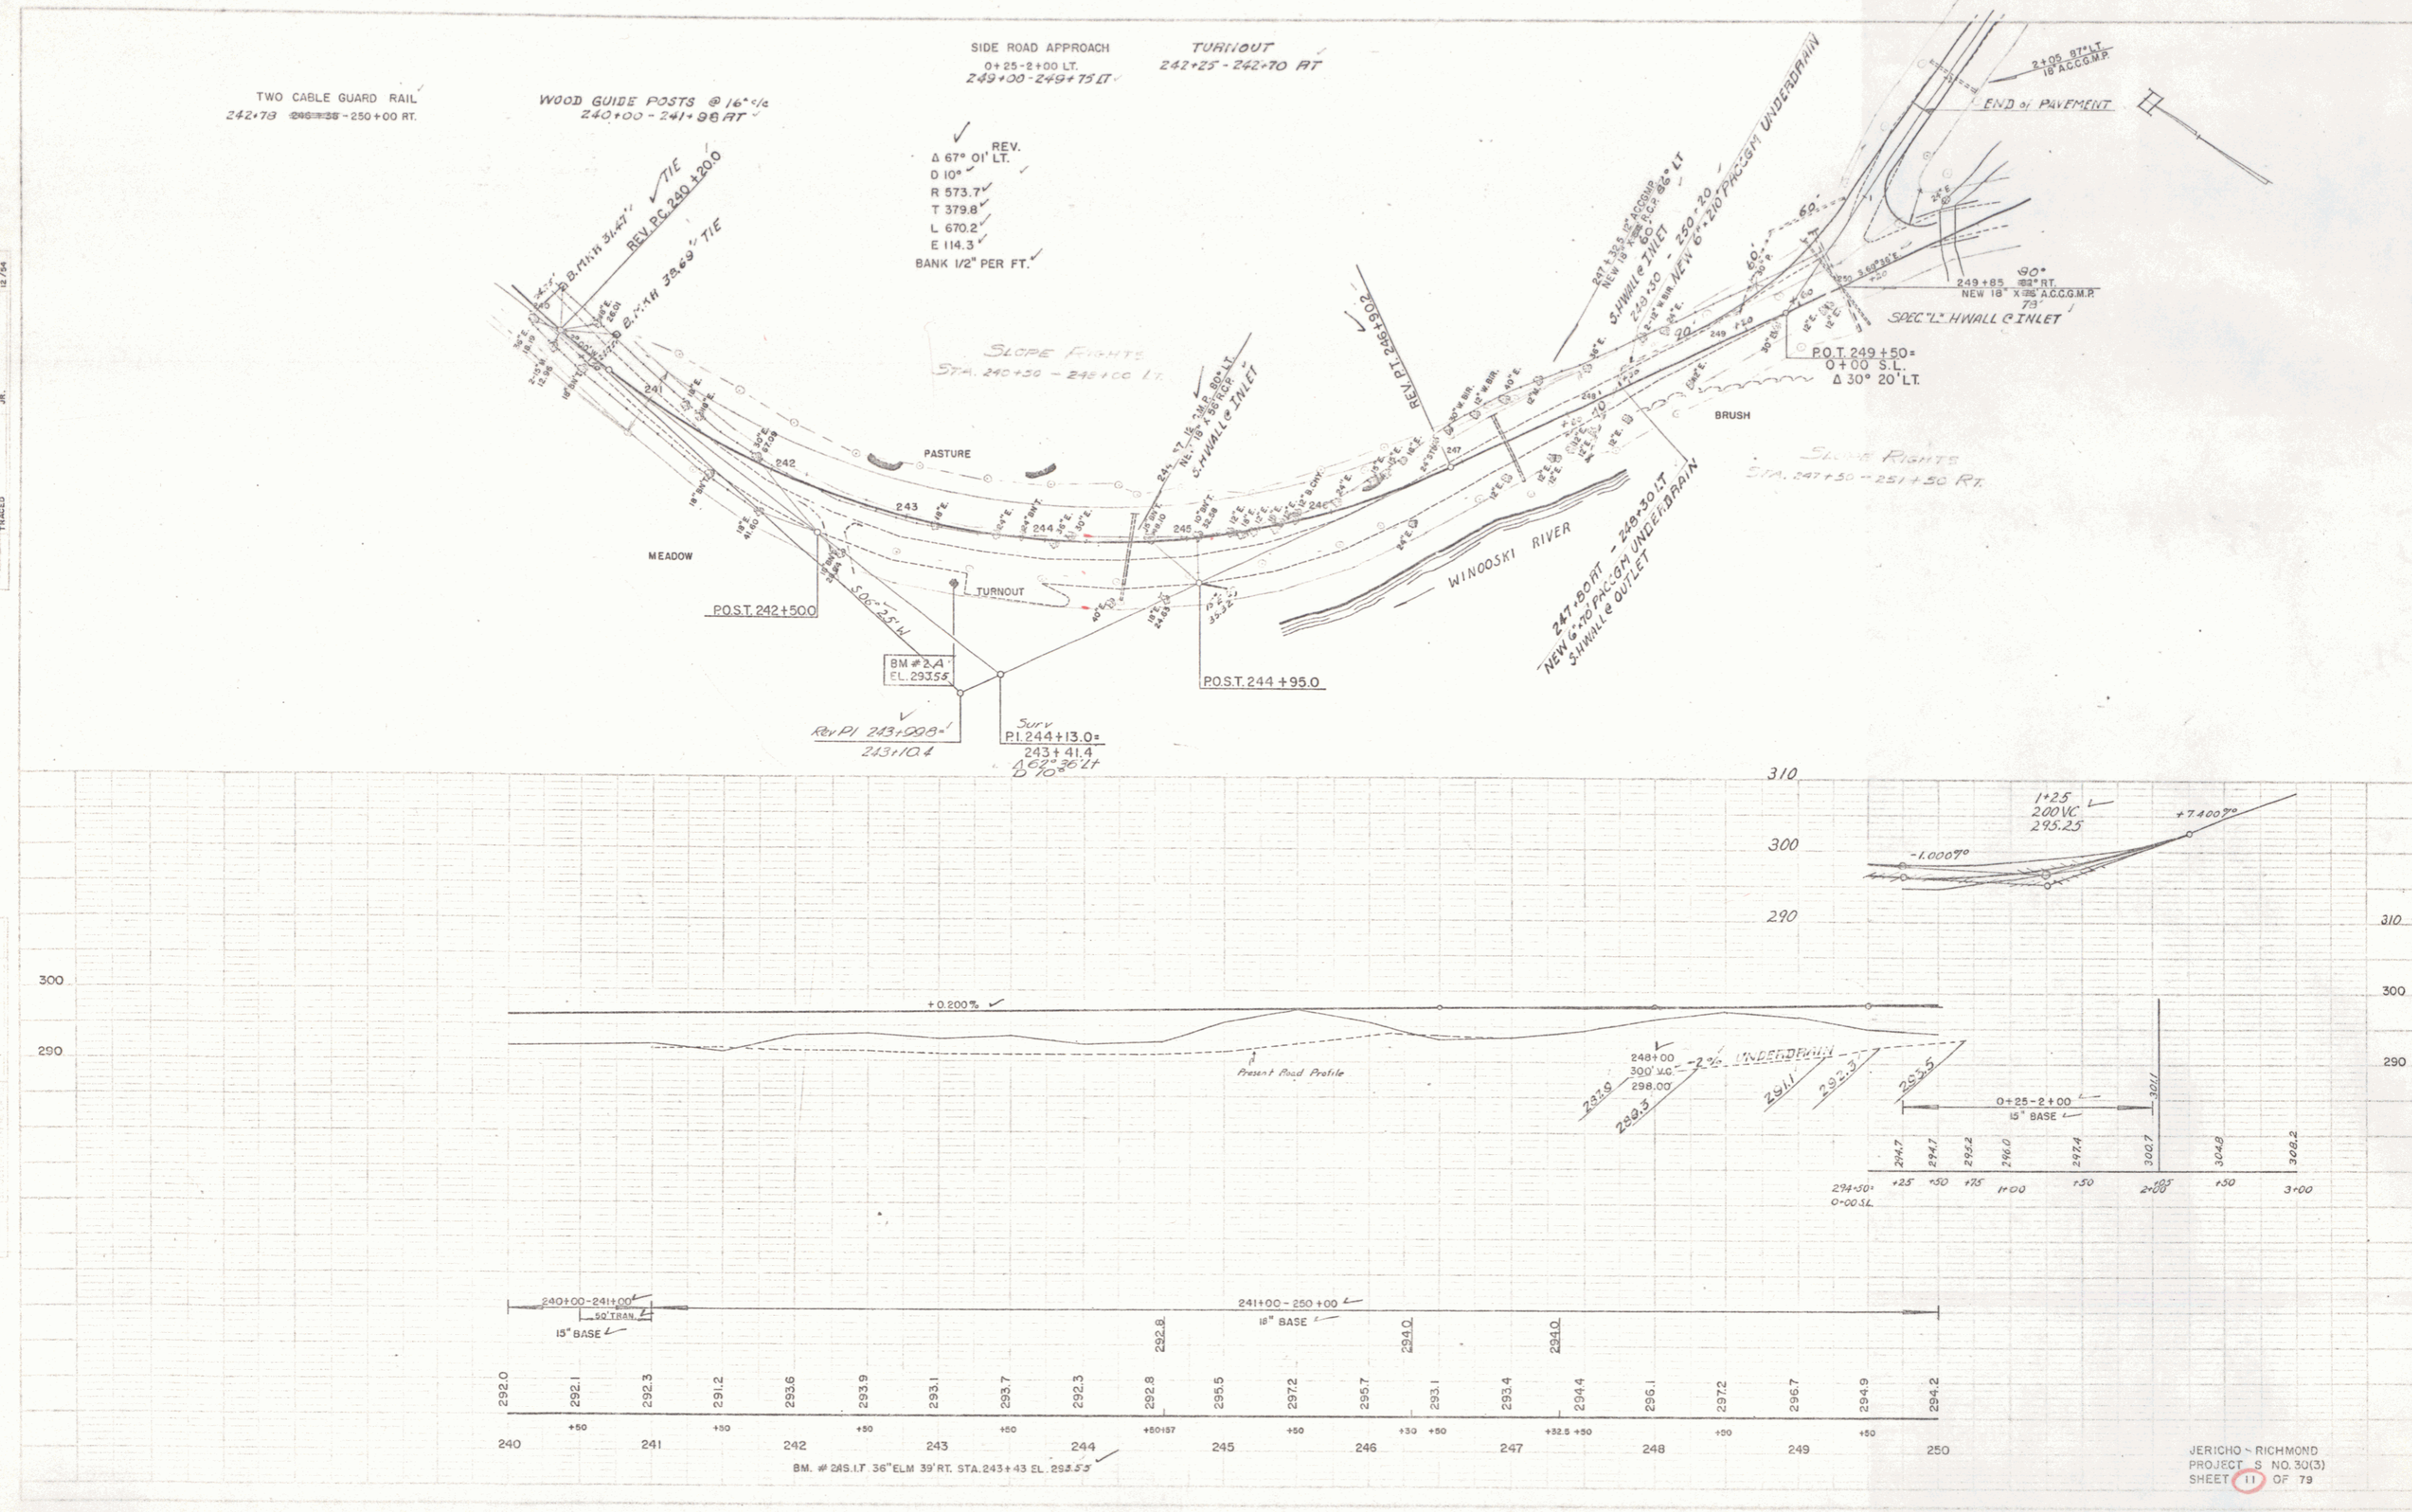

JERICHO - RICHMOND
 PROJECT NO. 30(3)
 SHEET 11 OF 79