
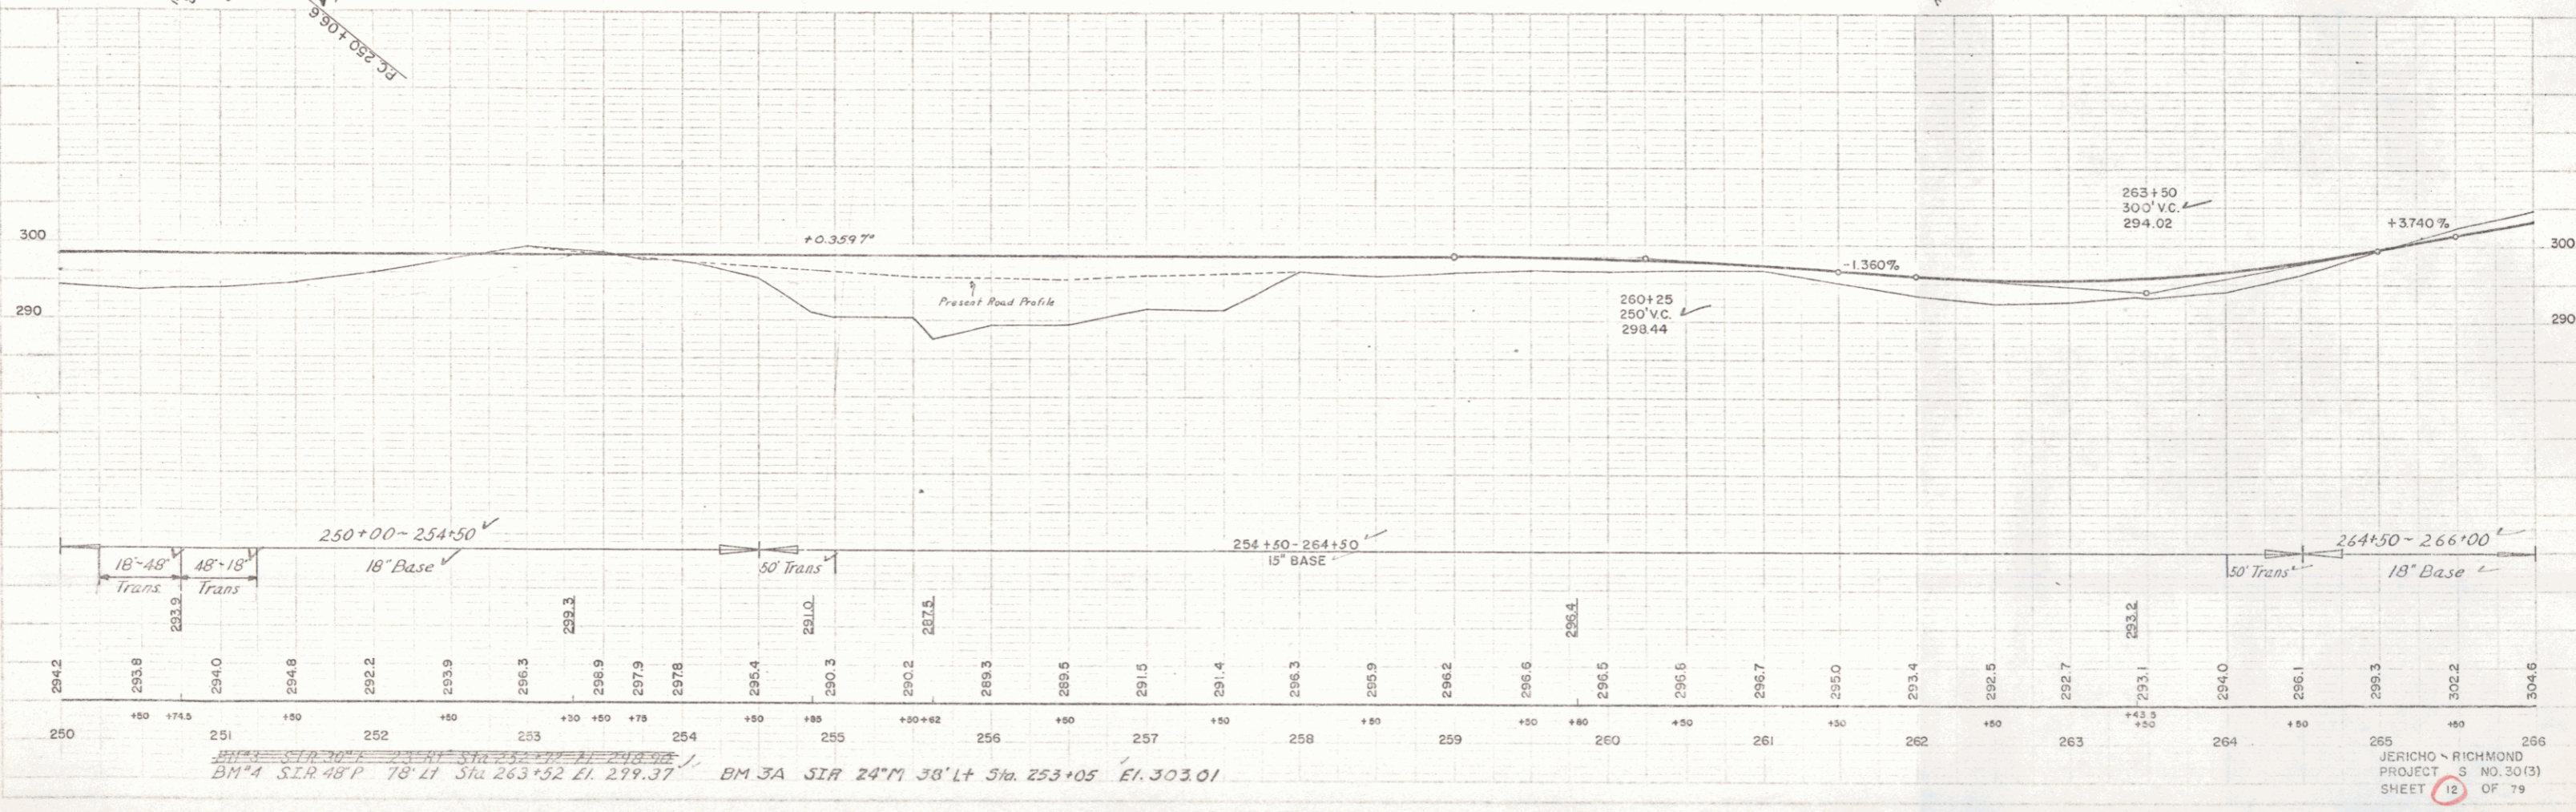


TWO CABLE GUARD RAIL
RT
250+00-260+00 251+18
250+00-260+00
253+30-253+78
262+50-266+00
LT
250+50-251+78
262+60-263+02

GUIDE POSTS
LT
250+70 (31) LT
253+62 (31) LT

CONSTRUCT DRIVES
LT
253+30E
253+75E
260+76E

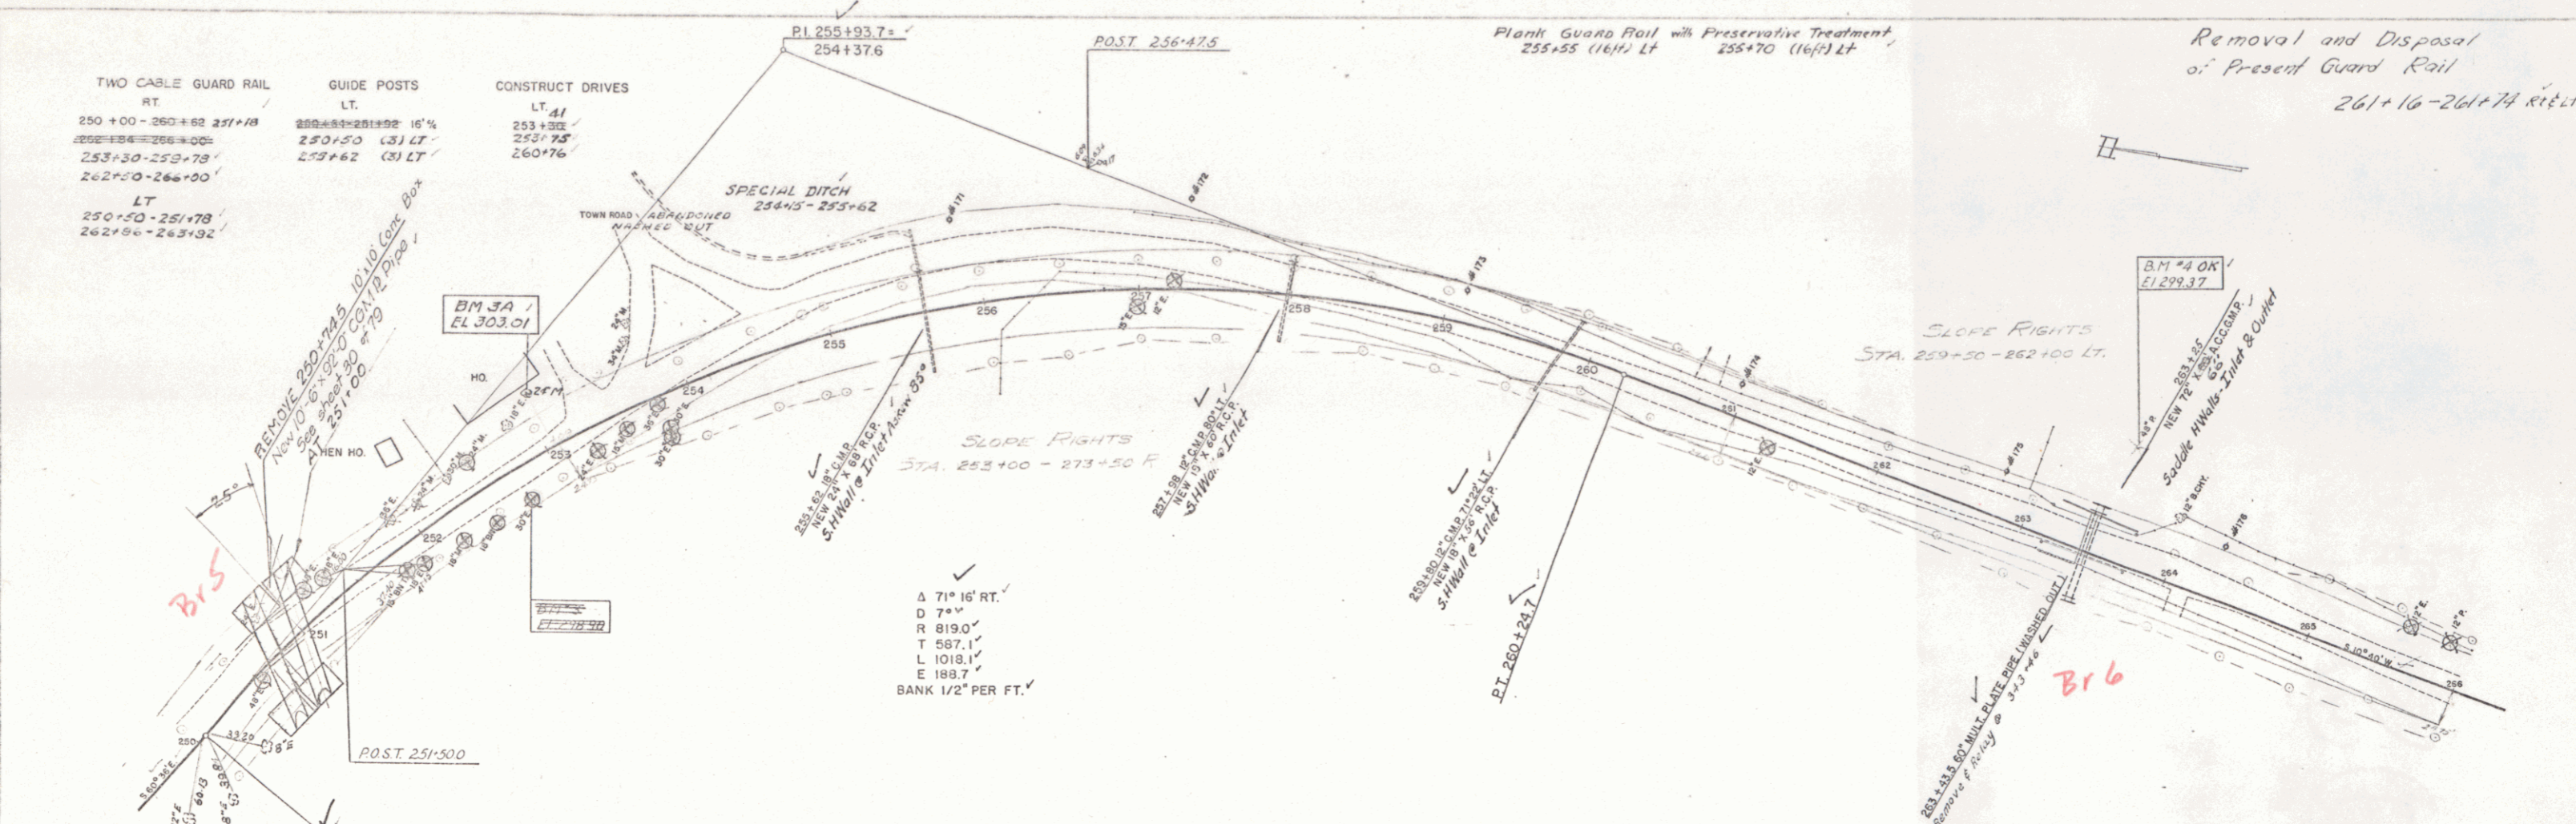

11/74
12/74
PALMER
SCRIBNER
TRAZED

11/74
12/74
PALMER
SCRIBNER
TRAZED

BM 3A SIR 24' M 30' LT Sta. 253+05 EL 303.01

255 JERICHO - RICHMOND
PROJECT S NO. 30(3)
SHEET 12 OF 79