


PLAN
 DATE
 DRAWN BY
 CHECKED BY
 PROJECT NO.

PROFILE
 DATE
 DRAWN BY
 CHECKED BY
 PROJECT NO.

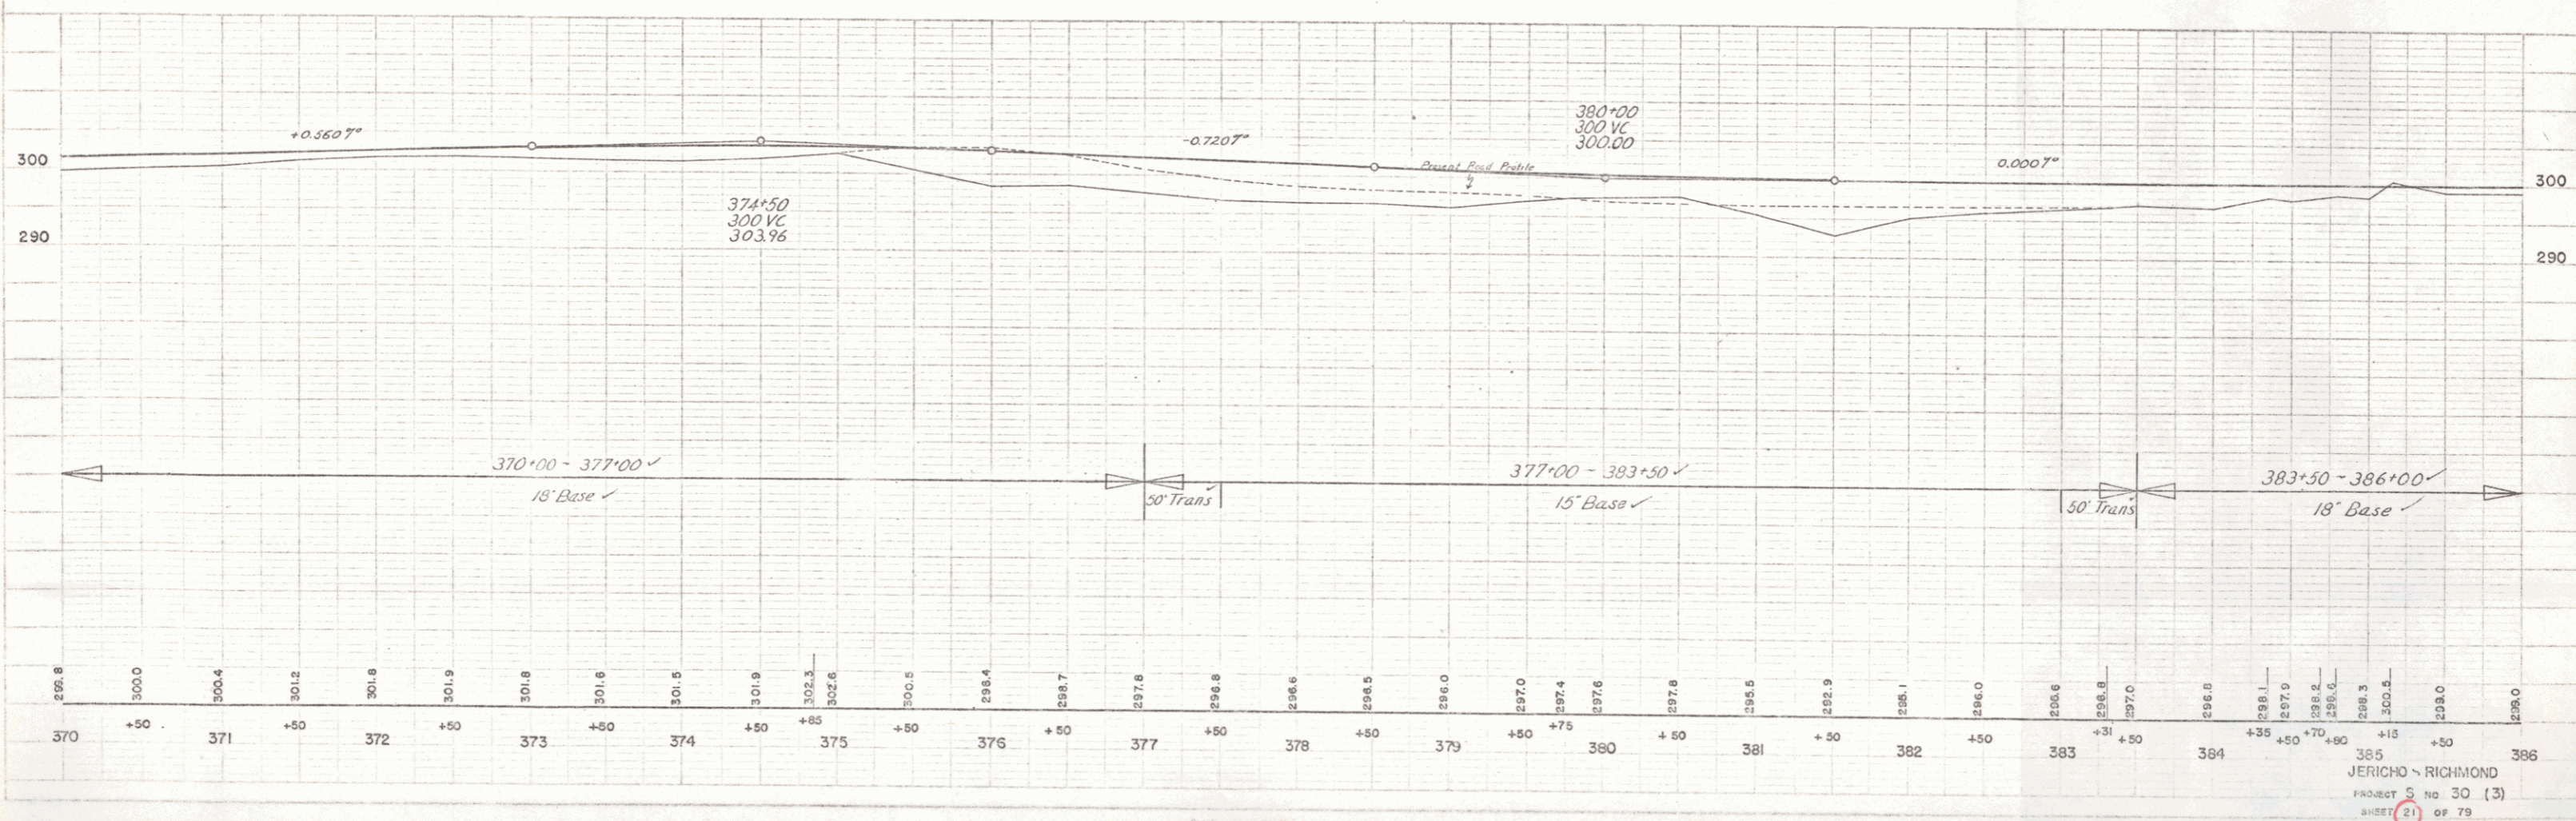

385
 JERICHO - RICHMOND
 PROJECT NO. 30 (3)
 SHEET 21 OF 79