
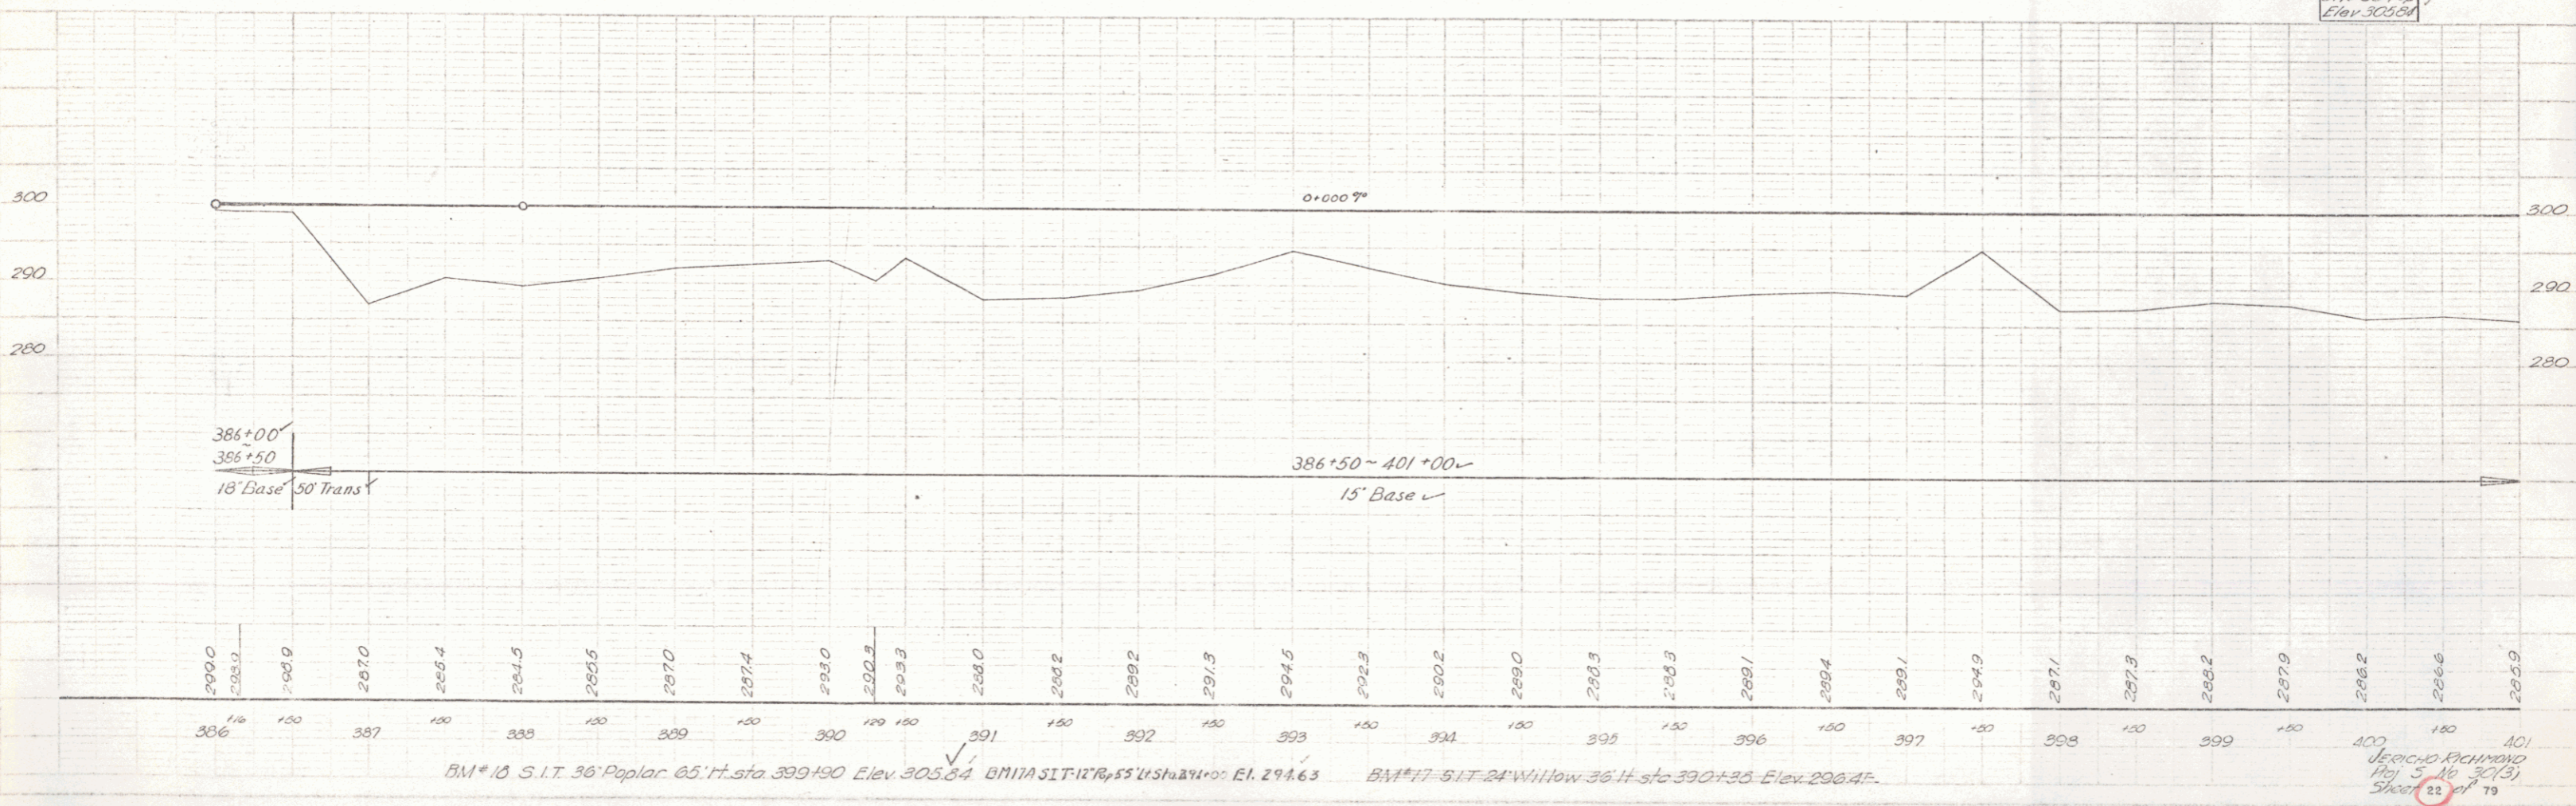


Construct Approach
386+50 Lt

Removal and Disposal
of present guard rail
386+80 (Side road Lt)

Two Cable Guard Rail
Lt Rt
387+00-401+00
388+50-401+00

SLOPE RIGHTS
387+00 - 402+50 LT.

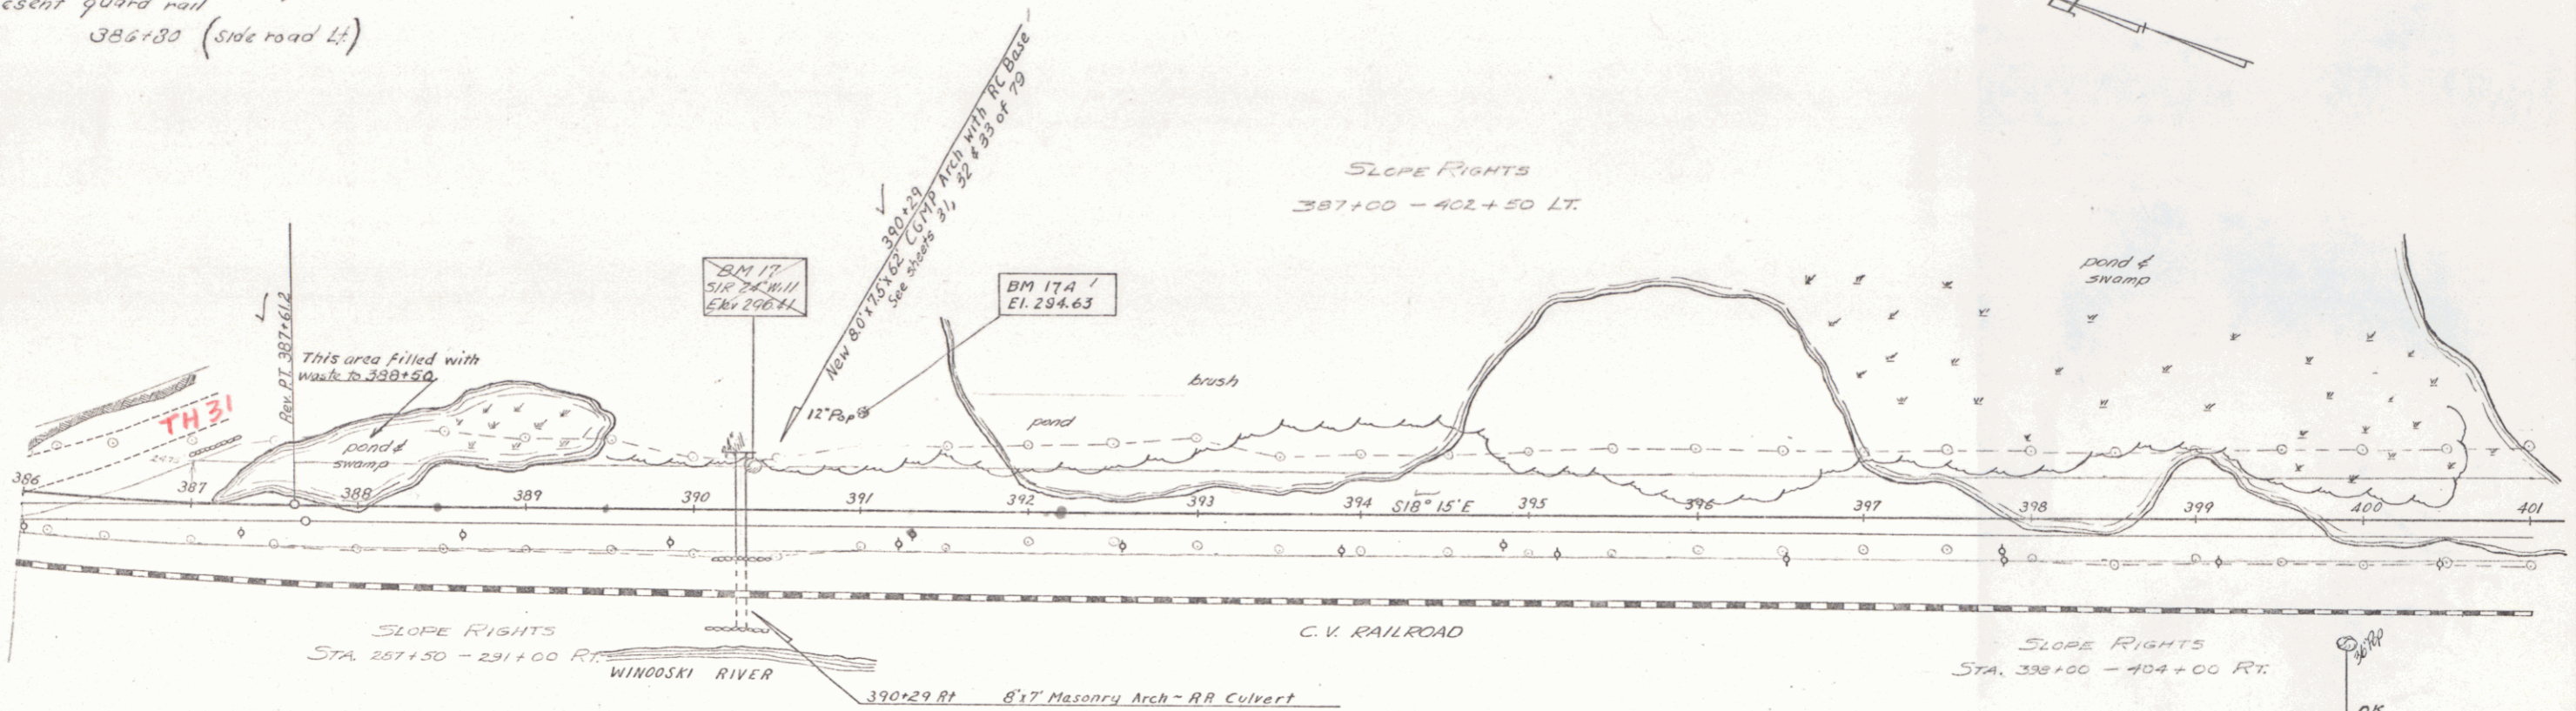

REV. 1/28
A. Gross

18' Base 50' Trans

OK
BM #14
S.I.T. 36' Poplar
Elev. 305.84

BM #10 S.I.T. 36' Poplar 65' ft. sta 399+90 Elev 305.84 BM #17 S.I.T. 24' Willow 36' ft. sta 390+35 Elev 296.47

Leech Richmond
Proj 5 No 30(3)
Sheet 23 of 79