
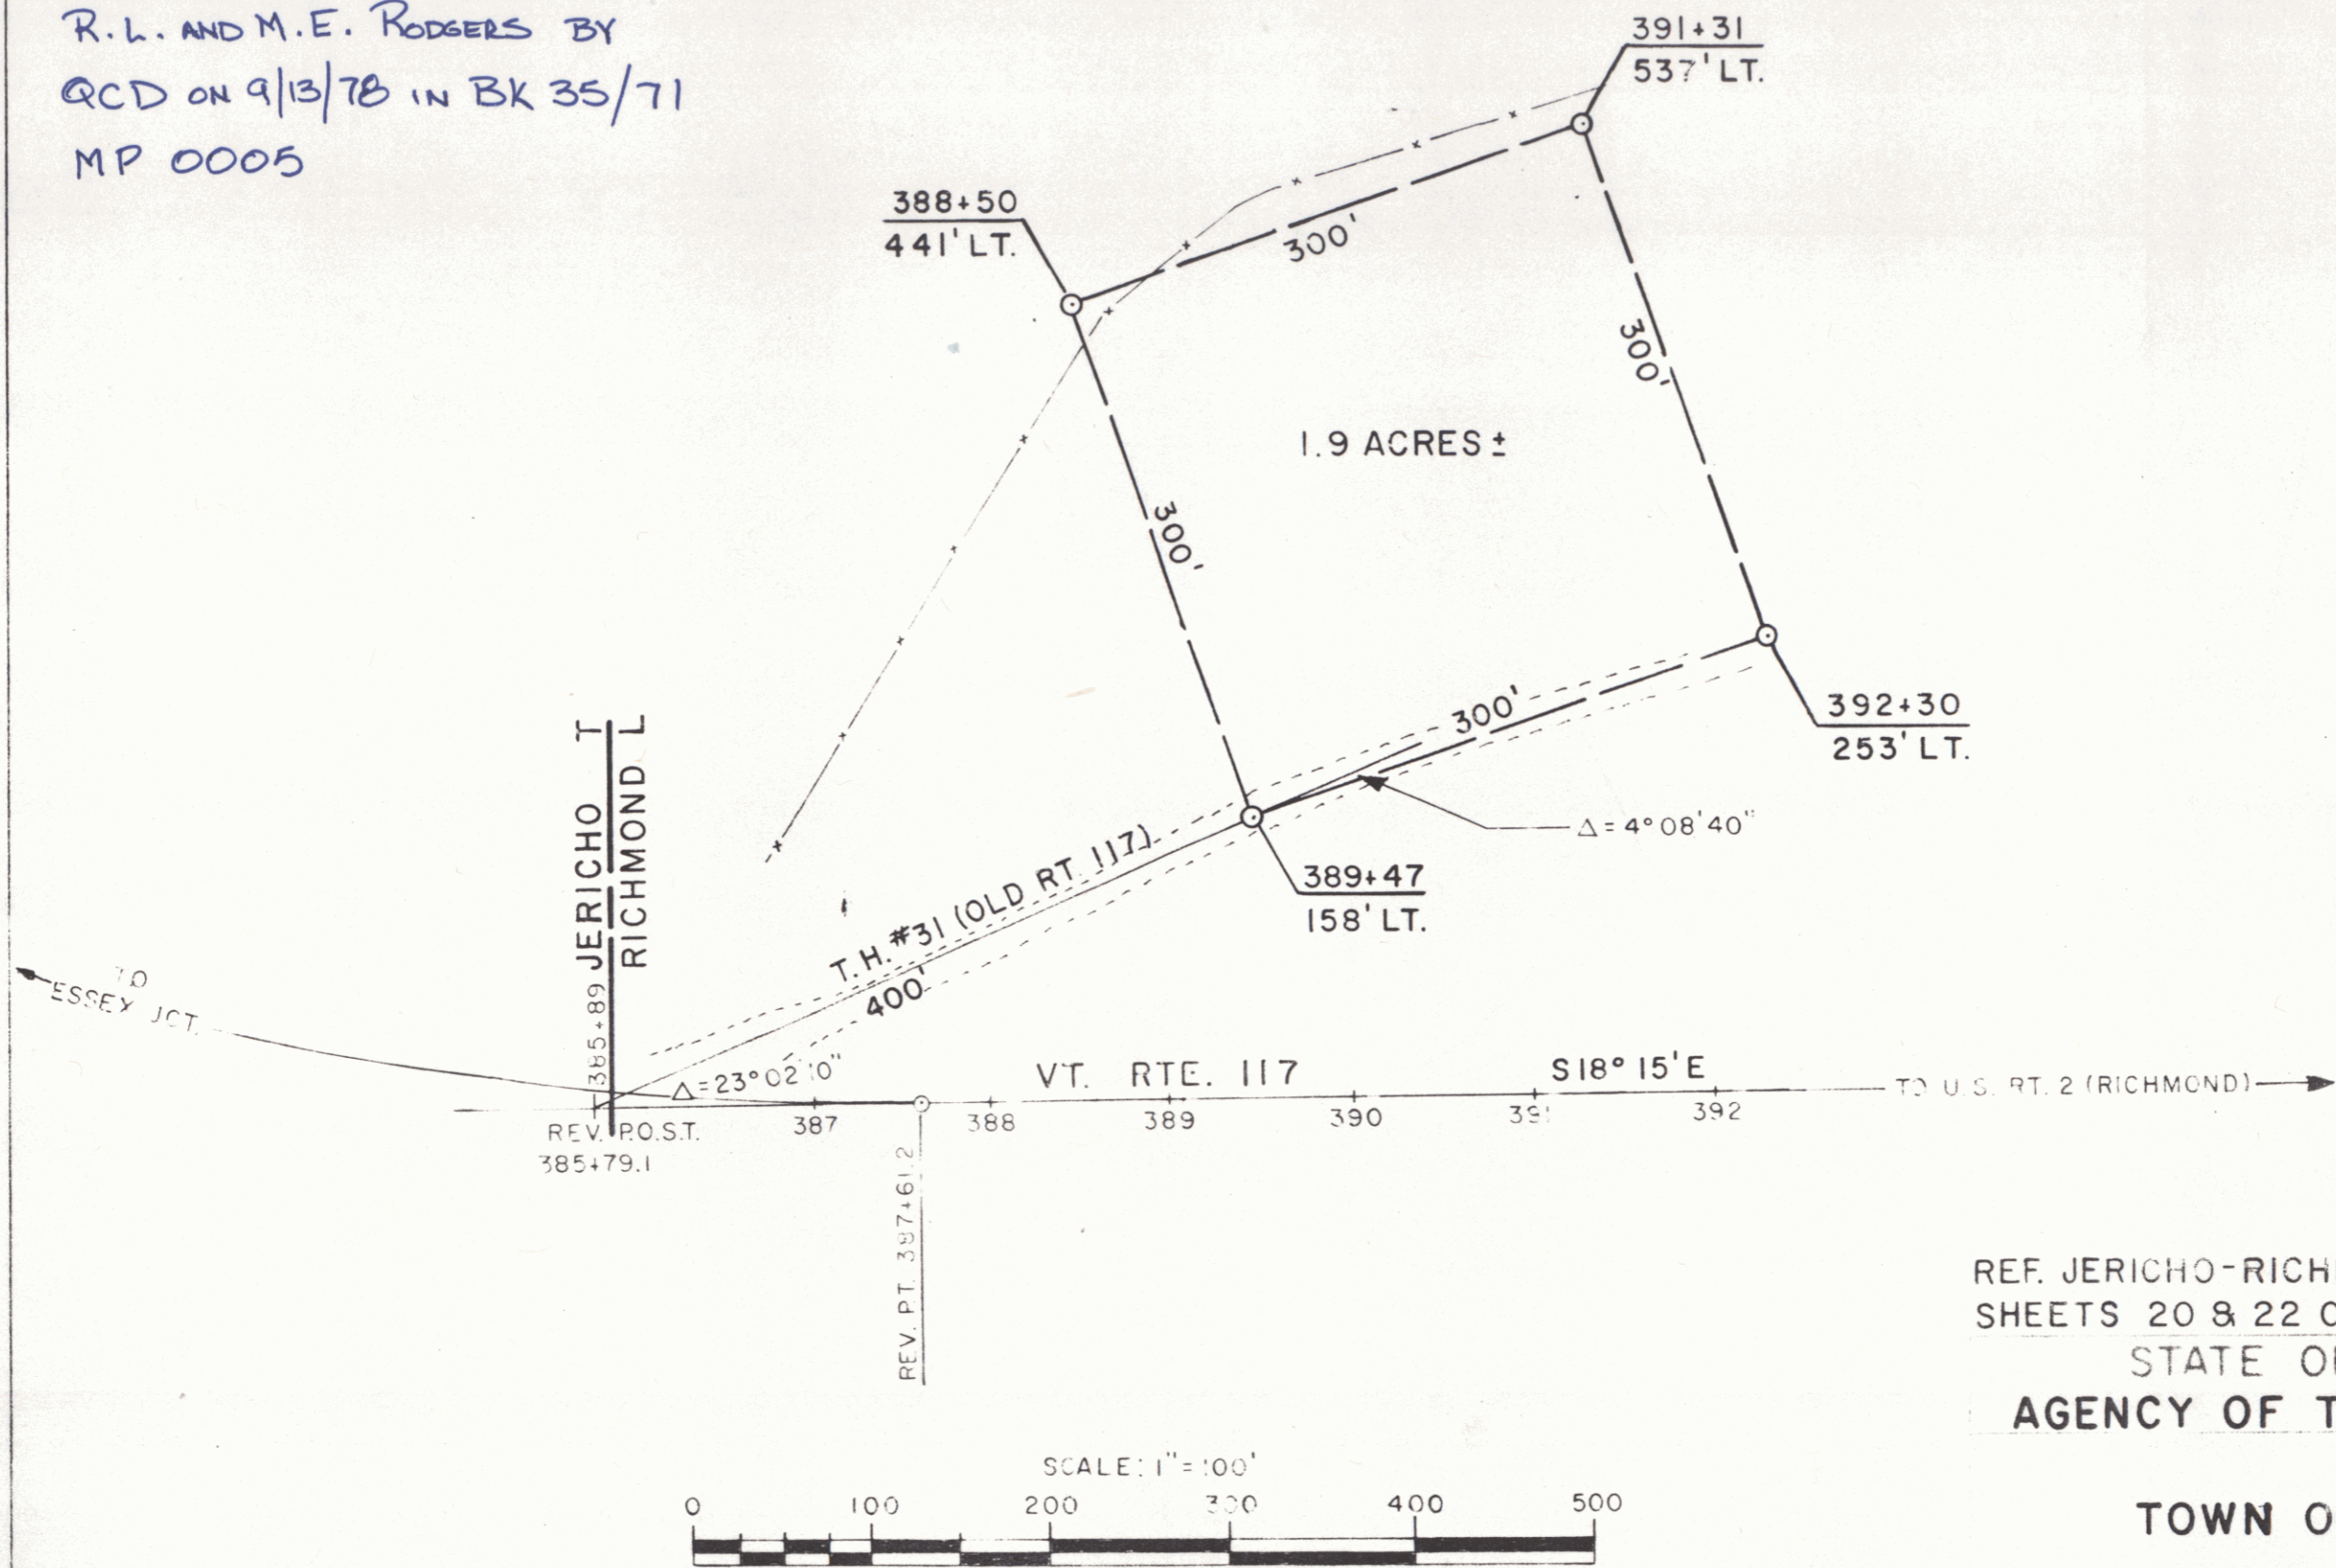


ACQUIRED FROM LOUIS A. & LILLIAN L. MARTELL
BY W.D. DATED APRIL 29, 1963 & RECORDED IN BK. 25 PG. 193.

STATE OF VERMONT TO
R.L. AND M.E. RODGERS BY
QCD ON 9/13/78 IN BK 35/71
MP 0005

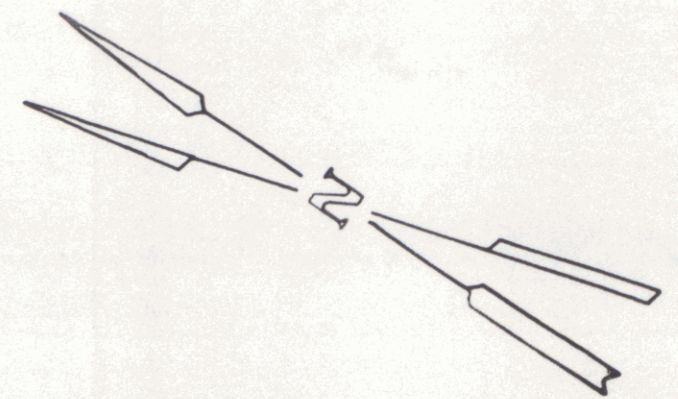

REF. JERICO-RICHMOND S 30 (3)
SHEETS 20 & 22 OF 79

STATE OF VERMONT
AGENCY OF TRANSPORTATION

TOWN OF RICHMOND

DATE 8-9-78 DRAWN BY
P. J. HARDE

SHEET 22A

22A

15