


NEW WOOD GUARD RAIL REQUIRED			NEW REINFORCED CONCRETE PIPE CULVERTS REQUIRED					
CULV. STA.	RIGHT	LEFT	STATION	DIAM.	LENG.	CONCR. H.	CONC. C.	REINFL. STEEL
138+23	24'	24'	138+23	15"	32'	3E	2.3c.y.	3376 _a
141+45	24'	24'	141+45	24"	40'	2.9c.y.		5716 _a

REV. CURVE No. 16
 Δ 17°05' L
 D 6'
 R 9550
 T 143.5
 Δ 289.7
 E 10.7

REV. CURVE No. 17
 Δ 14°20' R
 D 4'
 R 1432.7
 T 181.8
 L 361.7
 E 11.5

PLAN
 CHANCE
 7-30-30

CHANCE
 8-1-30
 8-2-30

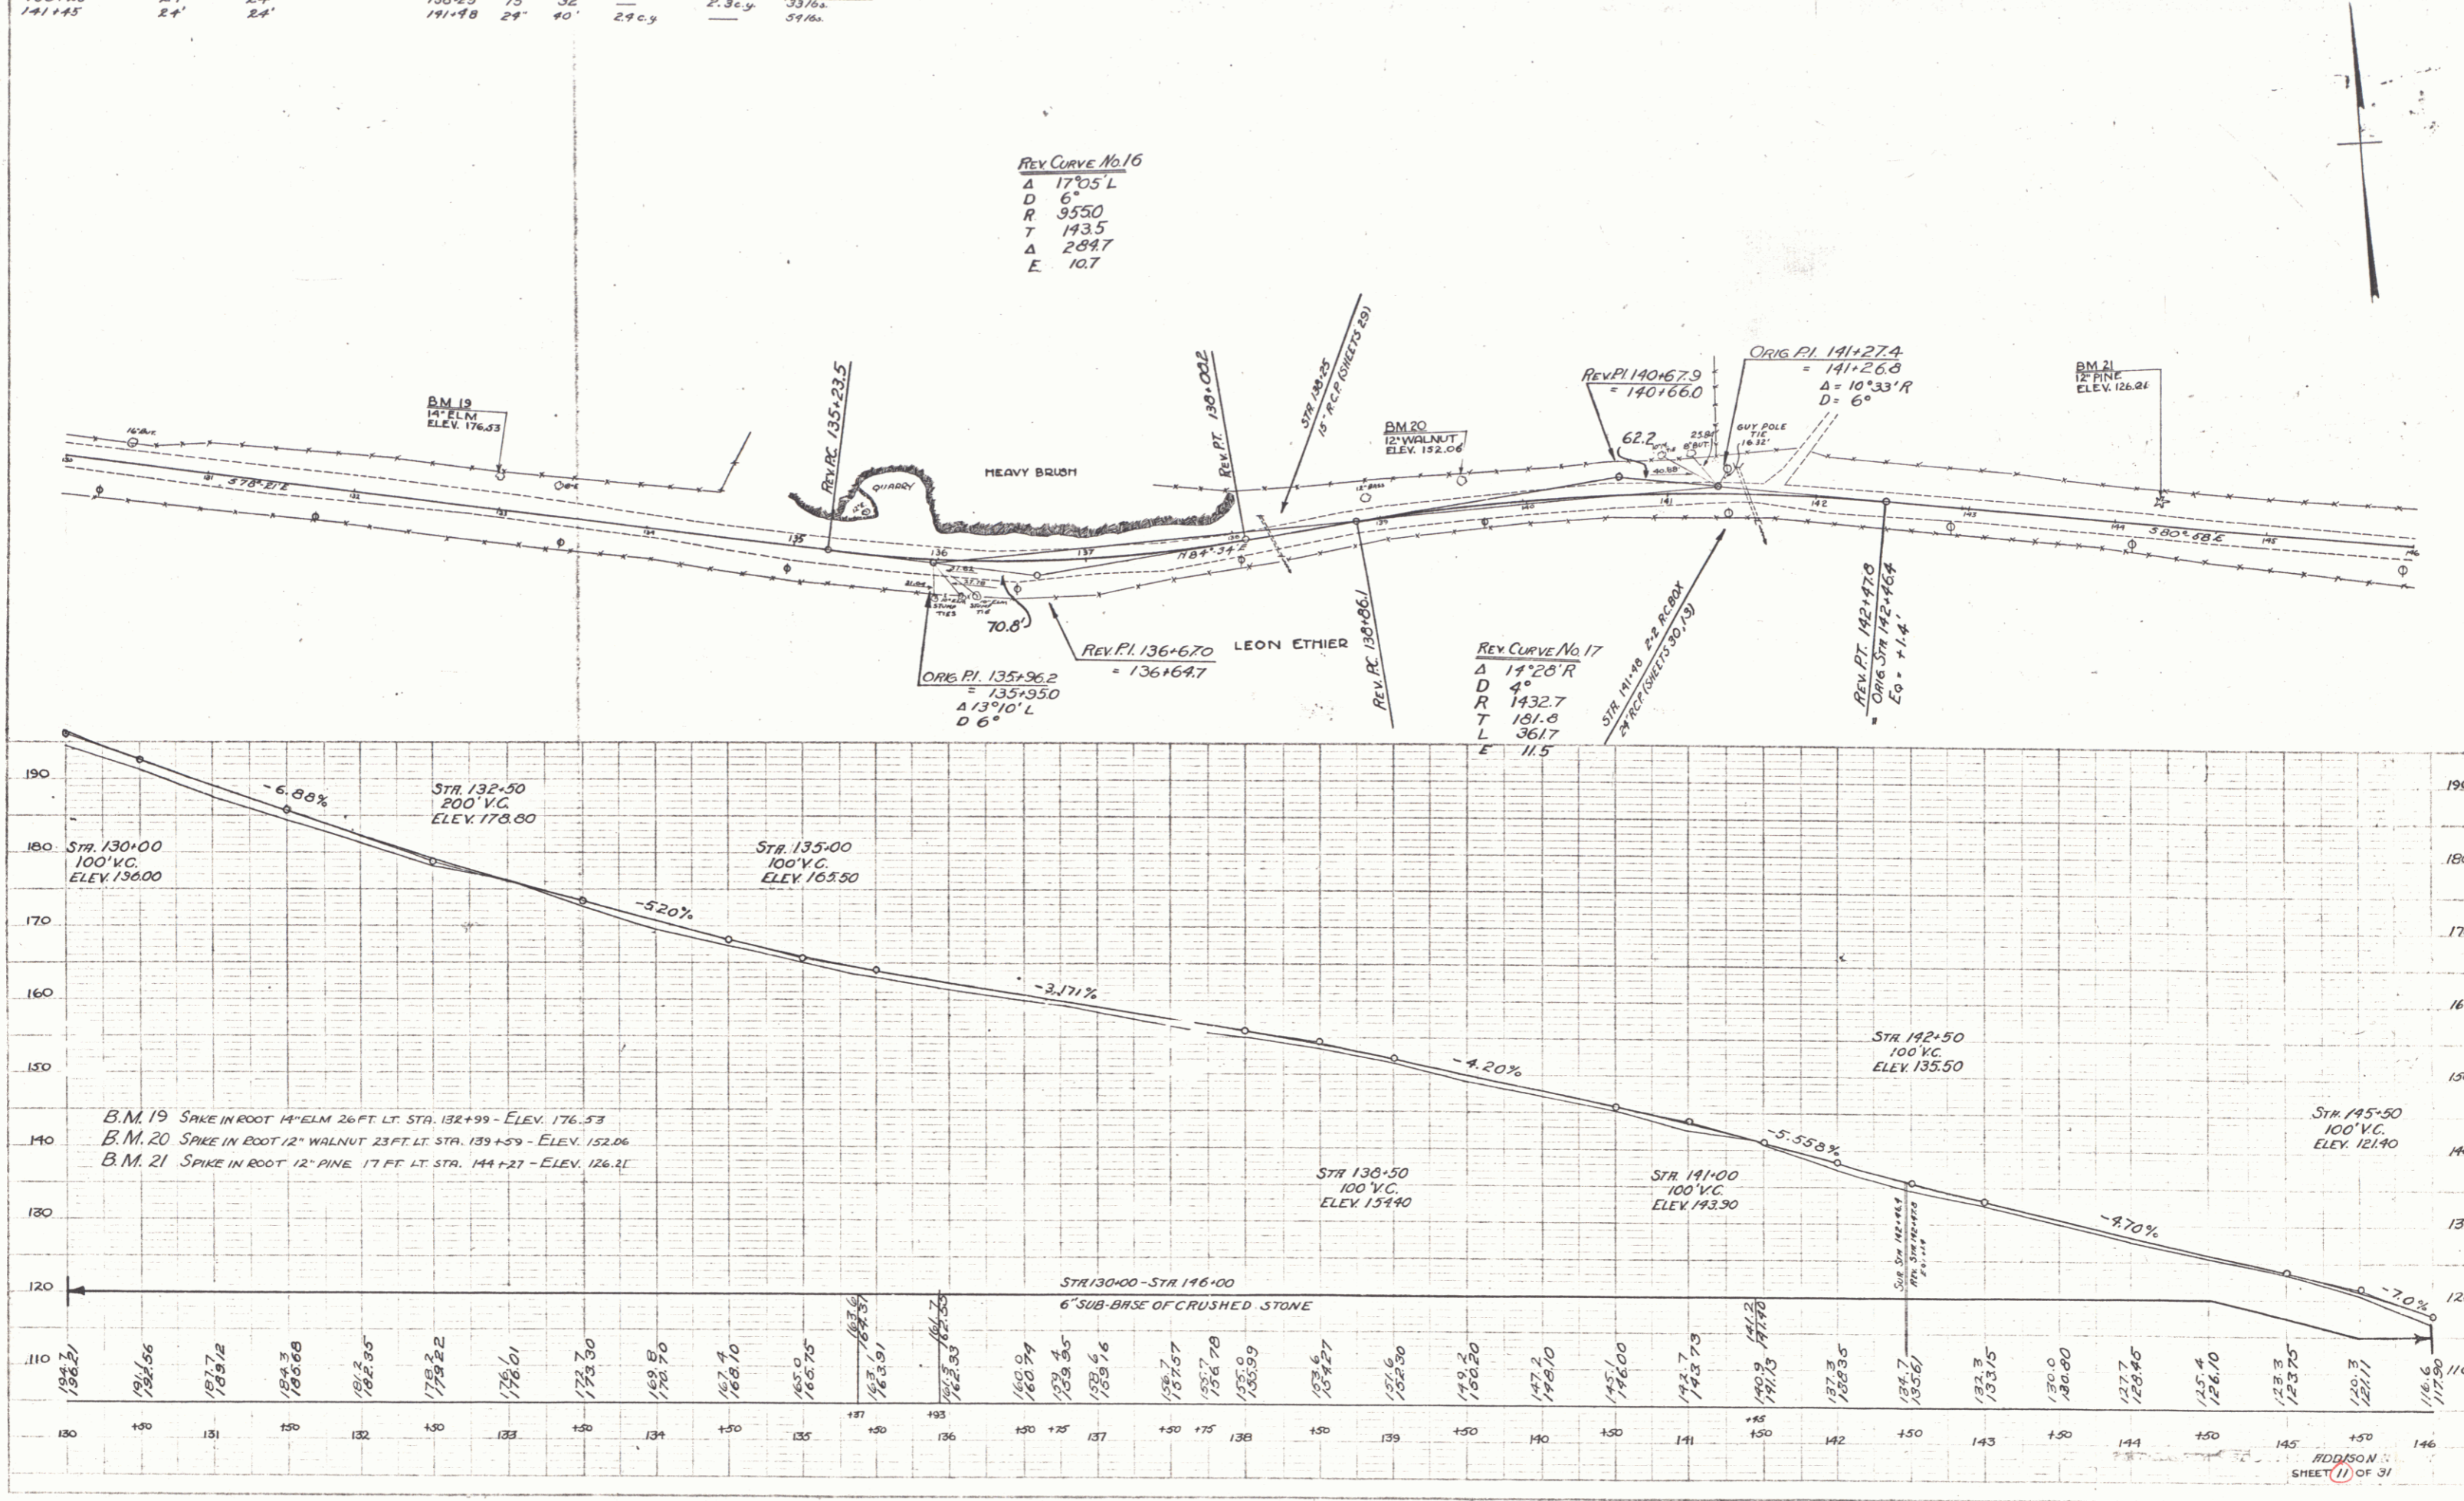

B.M. 19 SPIKE IN ROOT 14" ELM 26 FT. LT. STA. 132+99 - ELEV. 176.53
 B.M. 20 SPIKE IN ROOT 12" WALNUT 23 FT. LT. STA. 139+59 - ELEV. 152.06
 B.M. 21 SPIKE IN ROOT 12" PINE 17 FT. LT. STA. 144+27 - ELEV. 126.21