
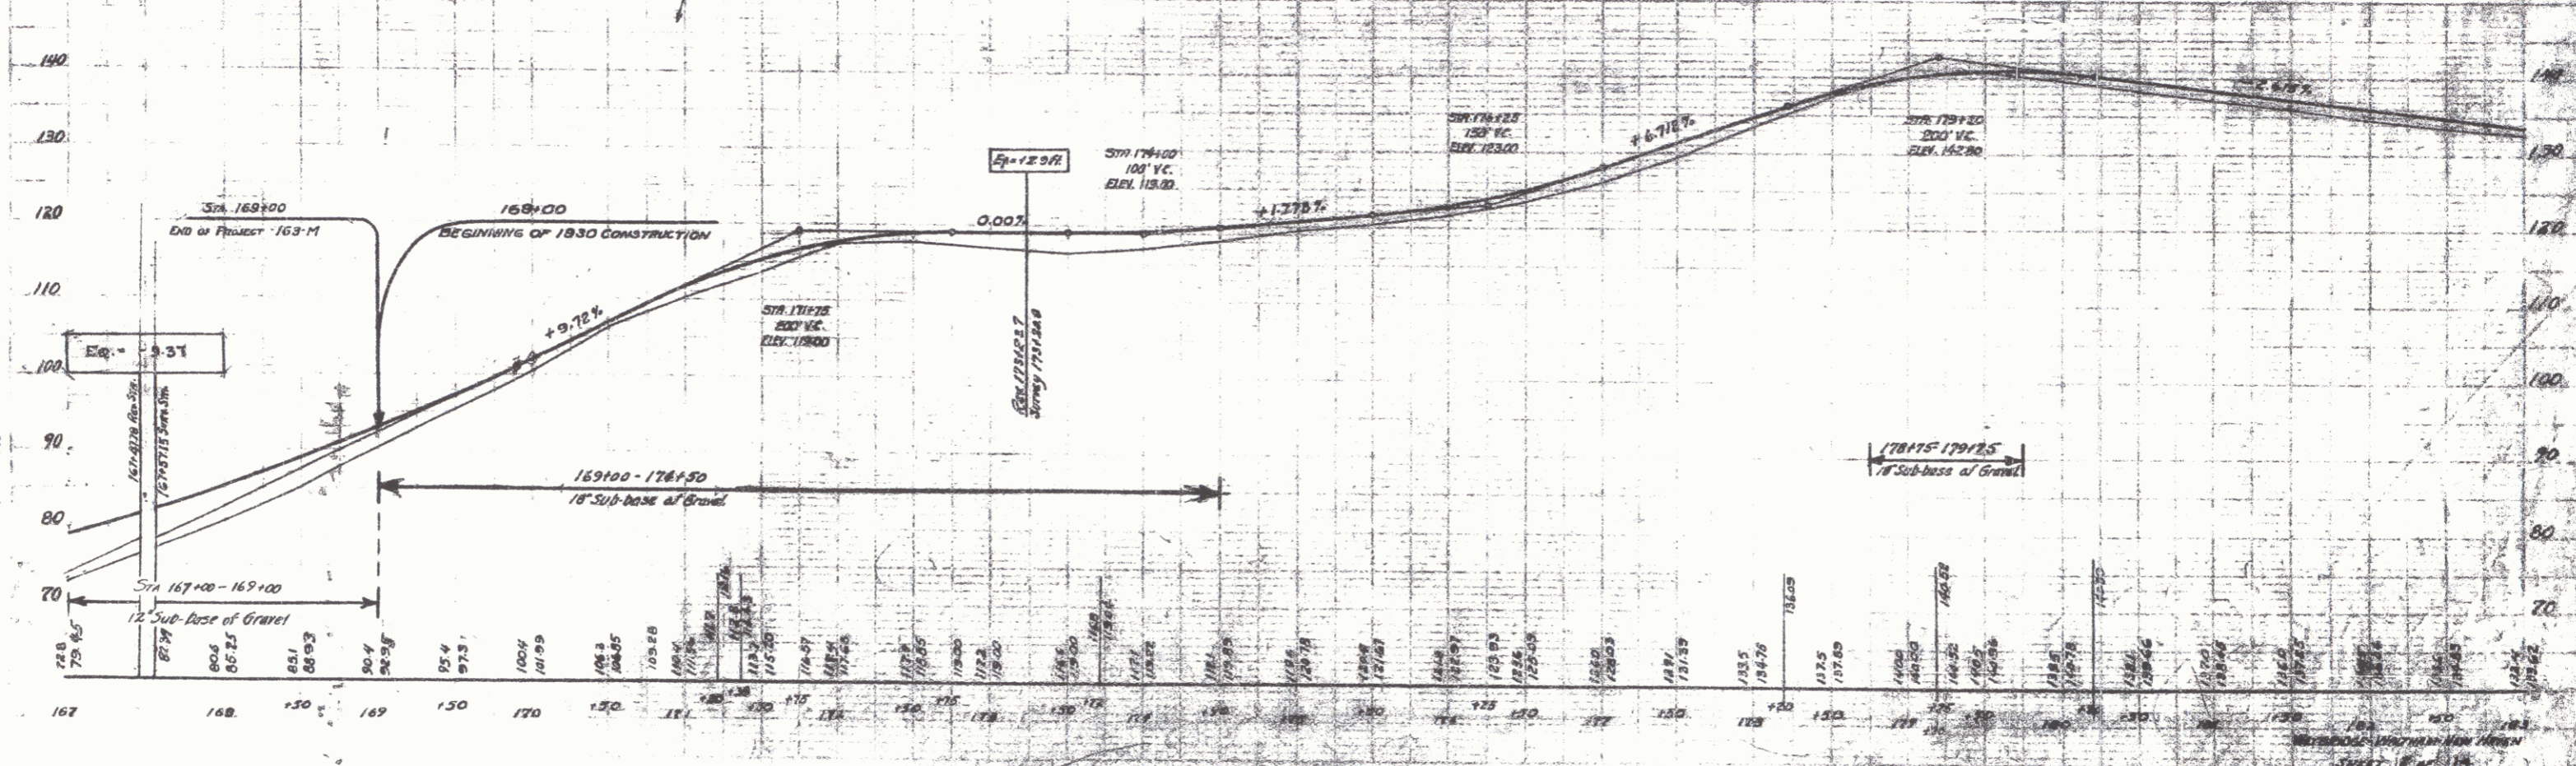


Date of this Survey: 1930
 Station: 167+00 to 178+50
 Length: 11.50 Sta.
 Curve No. 21
 R = 1000
 L = 115.0
 ELEV. 152.00

POOR ORIGINAL COPY

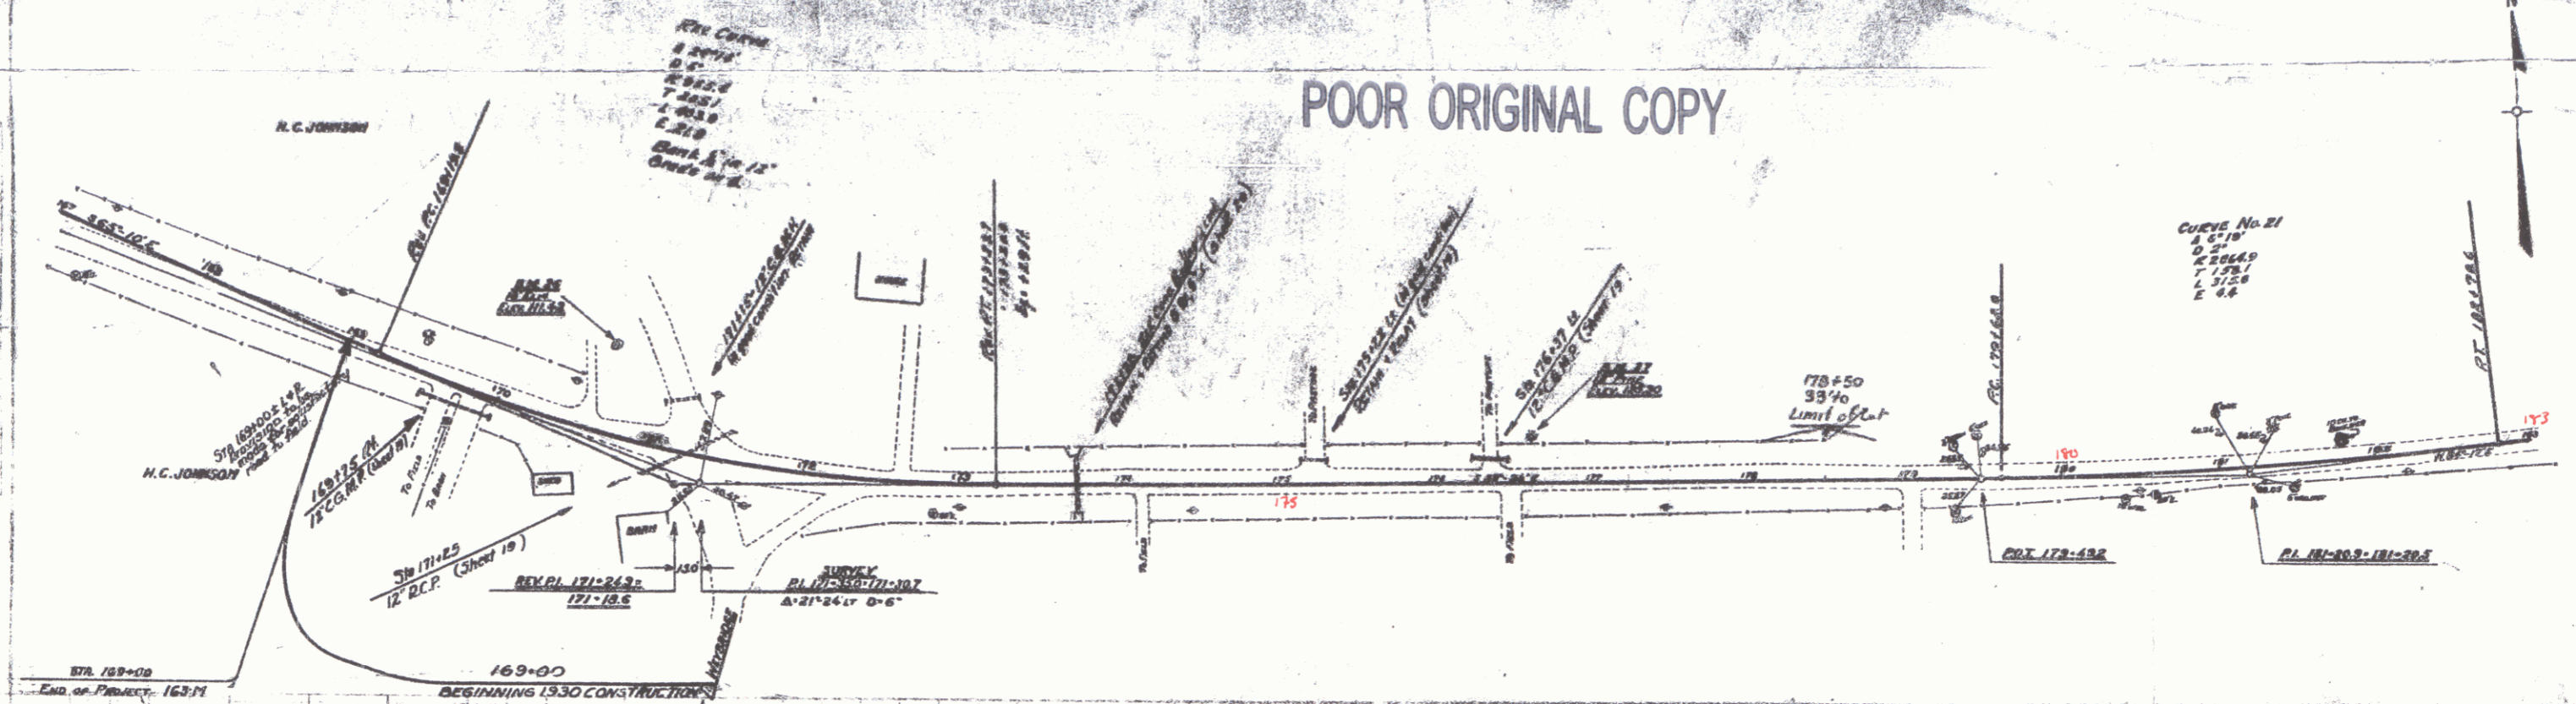

1694 1934 E 14

31