
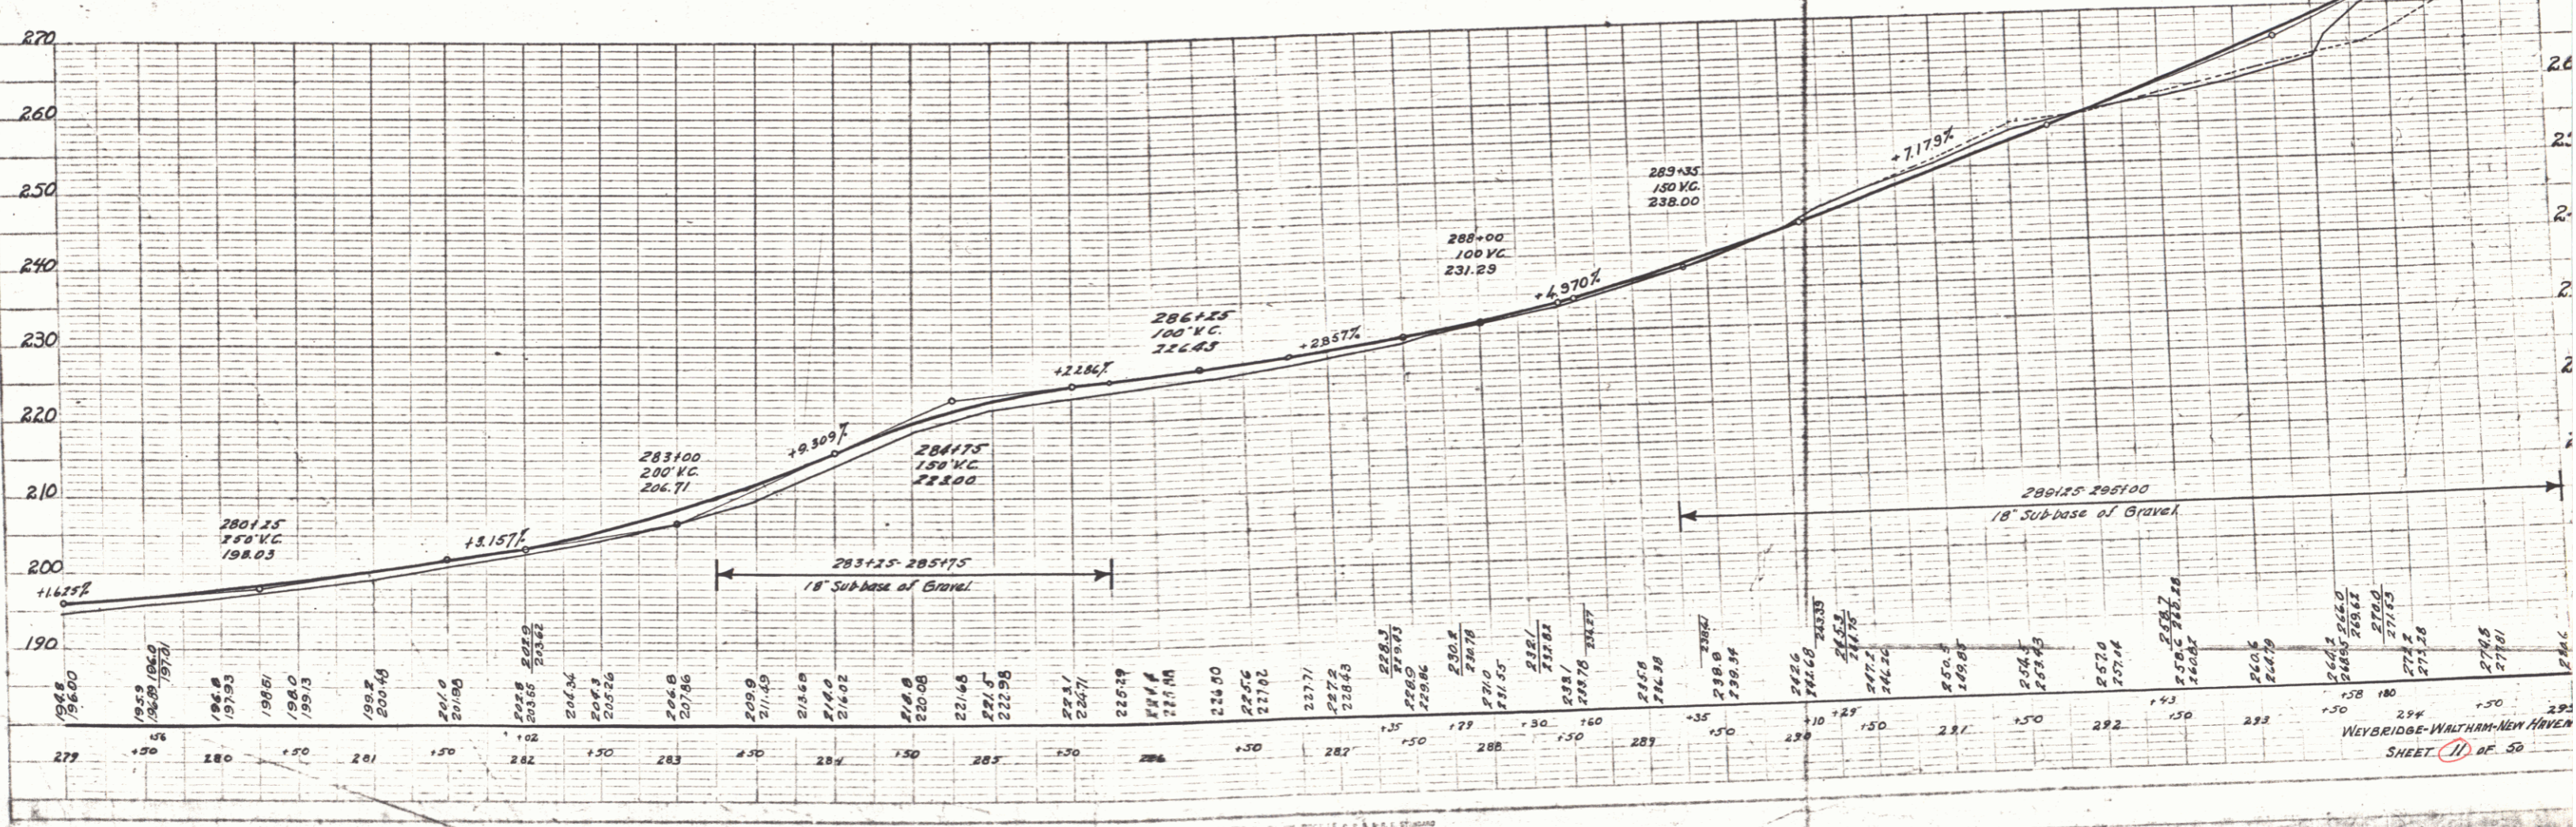


DEFINE CONC. PIPE CONVERTS REQUIRED
 STATION DATA LENGTH CONC. & CONC. STEEL
 202+02 18' 36" 1.0 cy 54"
 208+30 15' 36" 1.9 1.24 92"
 292+42 15' 48" 1.9 1.2 92"

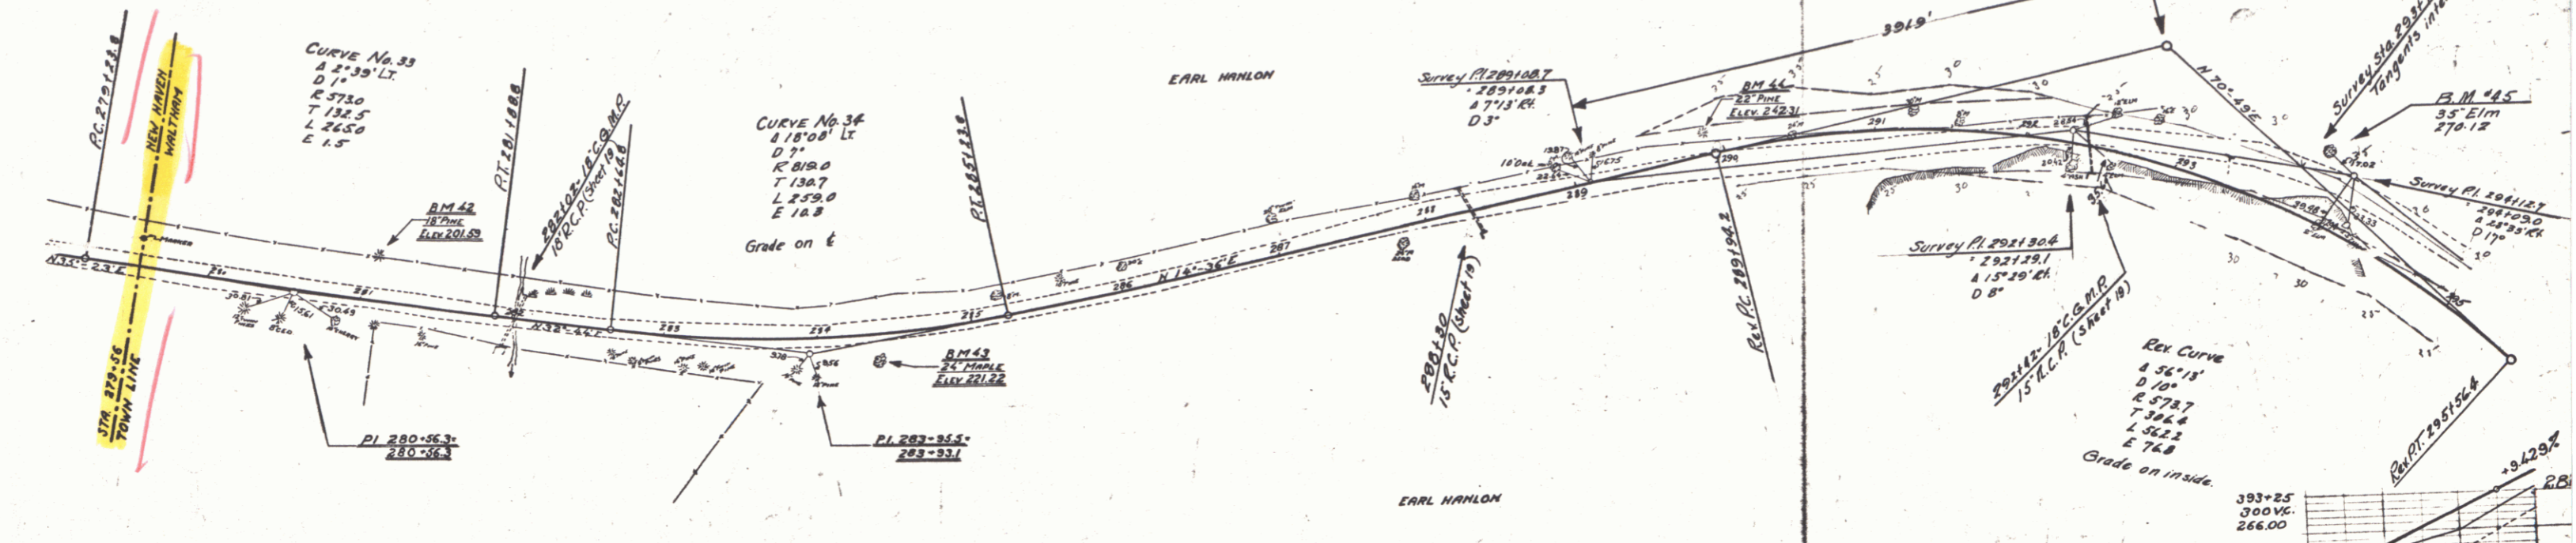

PLAN
 SCALE: 1" = 40'
 NOTE: SHOW ALL CONCRETE CURVES
 WITH DIMENSIONS AND STATIONING

PROFILE
 SCALE: 1" = 10'
 NOTE: SHOW ALL GRADES AND CURVES
 WITH DIMENSIONS AND STATIONING