

NEW RAIN CONC. PIPE CULVERTS REQUIRED

Station	Diagl	Long	Conc. R.	Skel
3131.50	15'	40"	10% S	75'
3161.75	18'	32"	18	66
3201.27	18'	36"	18	27


FED. ROAD DIST. NO. STATE ROAD NO. COUNTY DIST. SHEET NO. DATE
 1930 18 50

PLAN

DATE	1930
BY	W. B. WALKER
CHECKED	
APPROVED	

PROFILES

DATE	1930
BY	W. B. WALKER
CHECKED	
APPROVED	

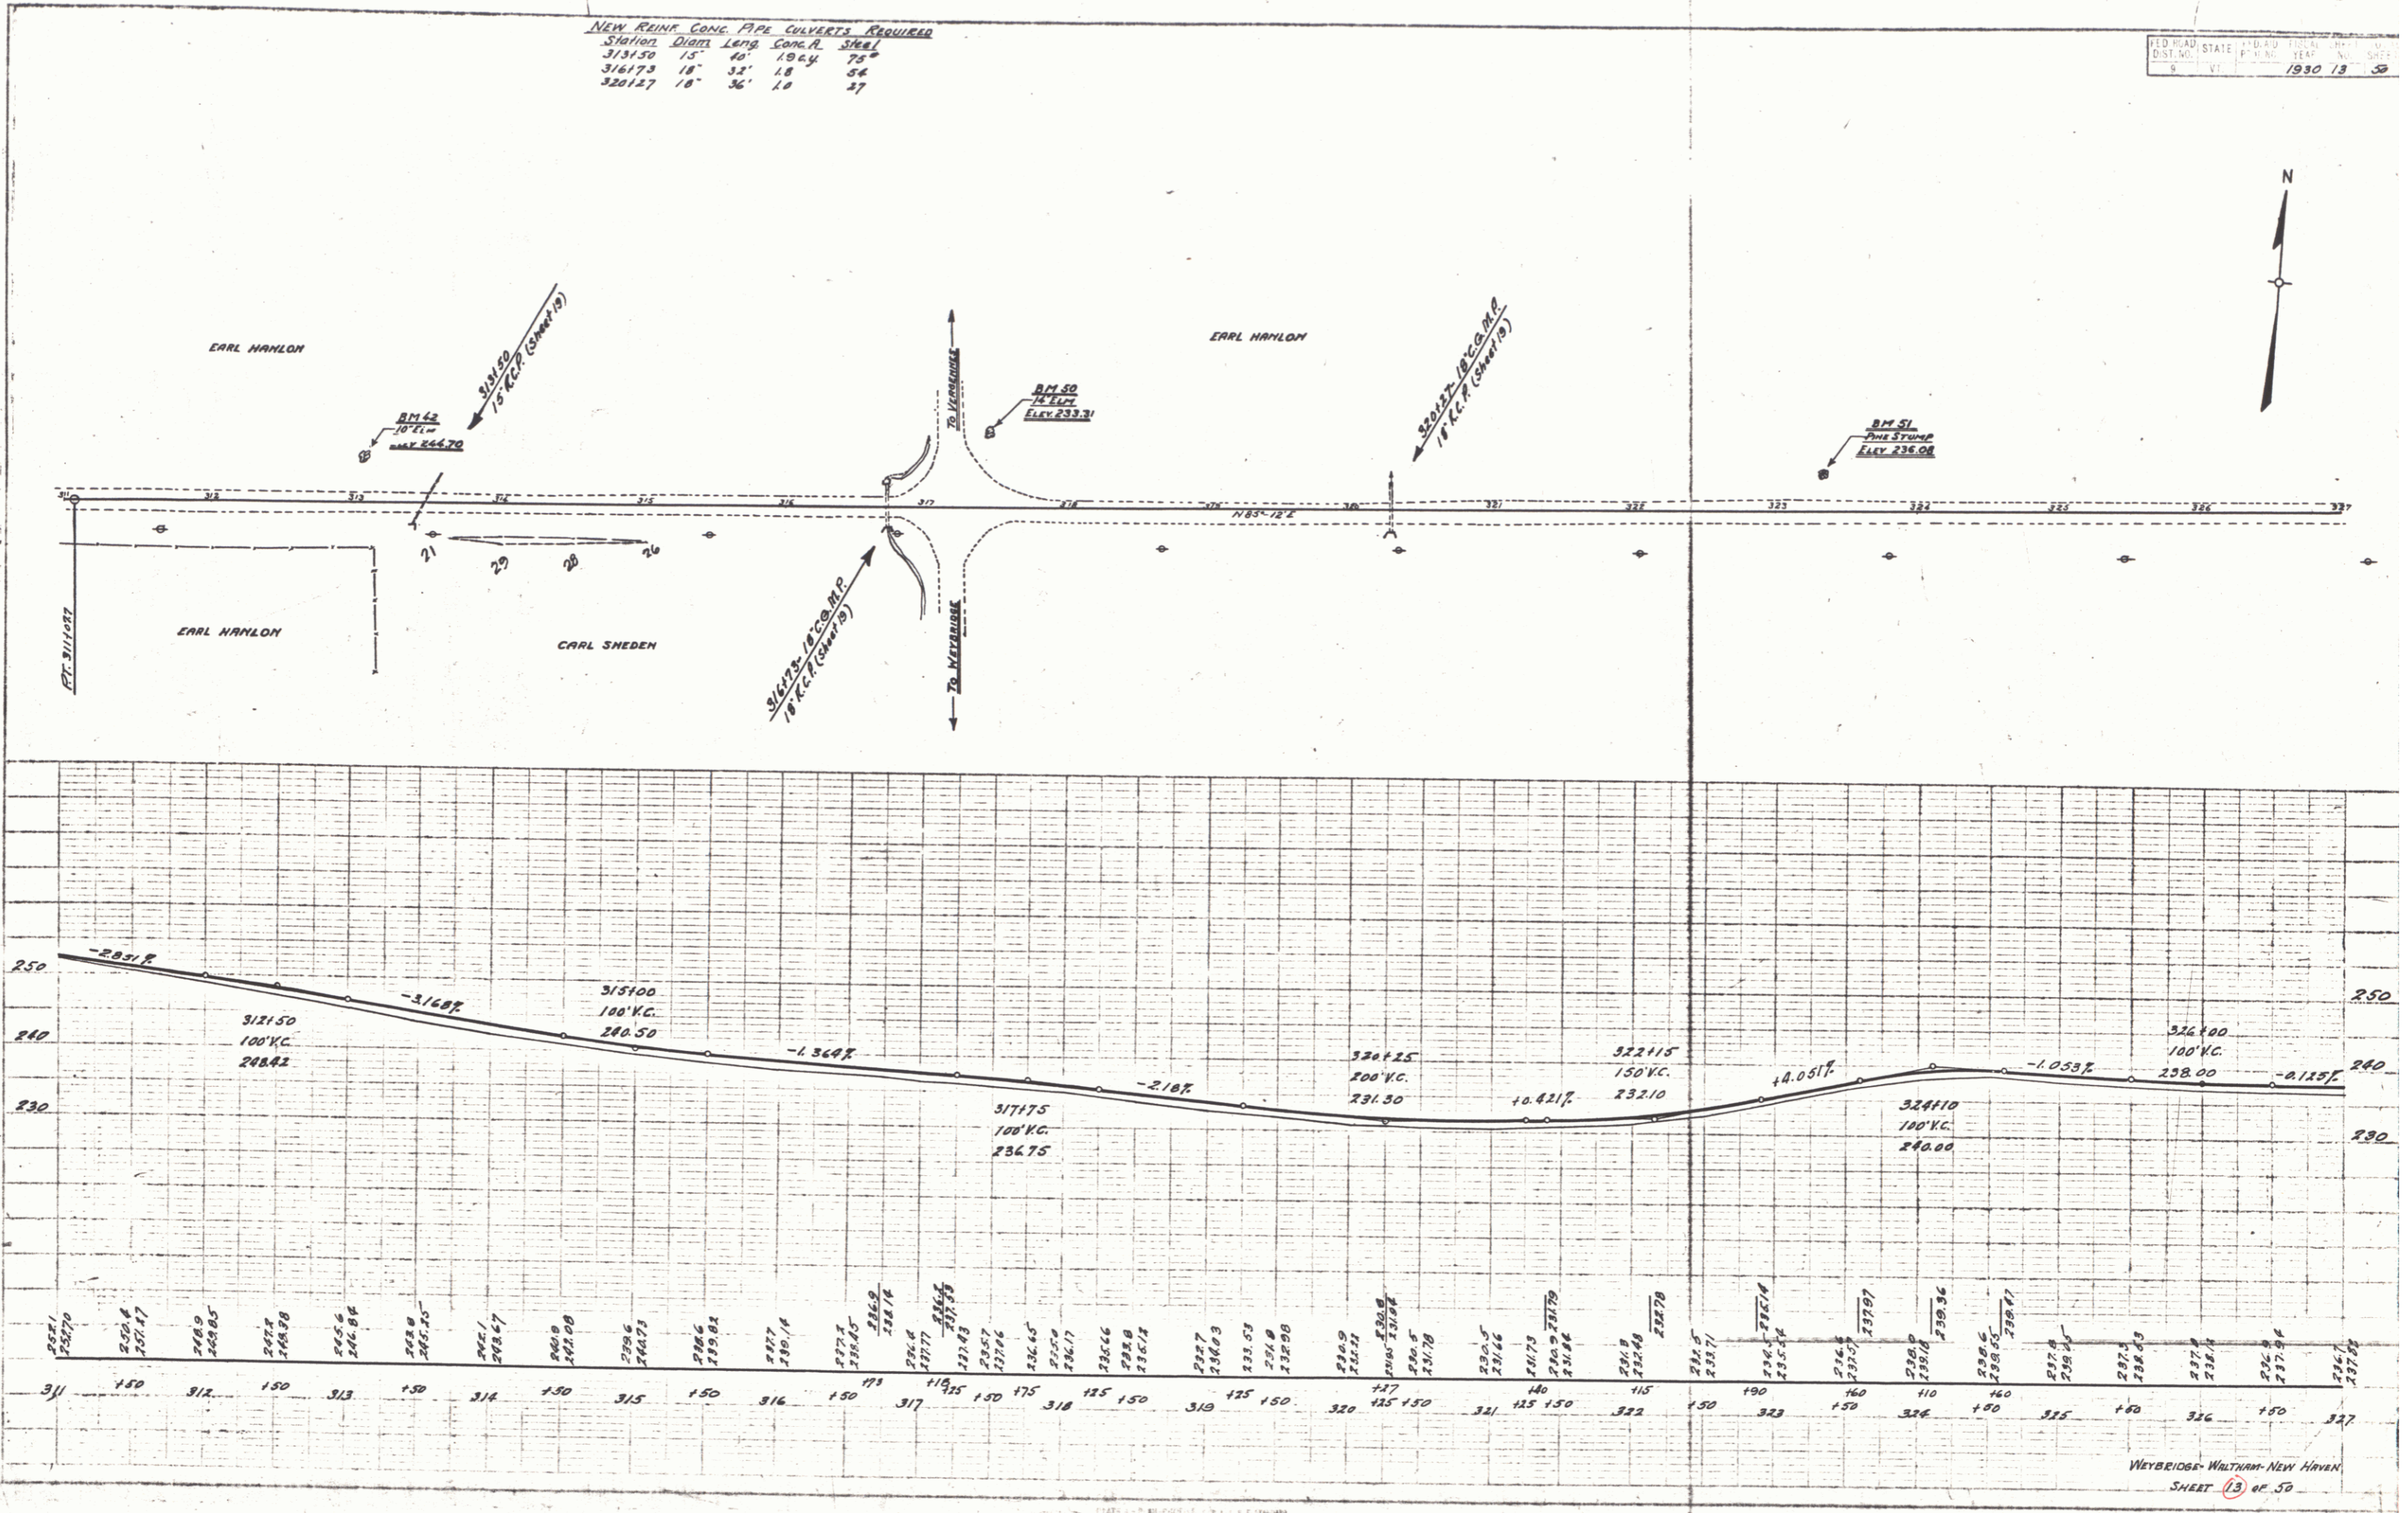

WEYBROOK-WALTHAM-NEW HAVEN
 SHEET (3) OF 50

10