


NEW PLINE CONC. PIPE CULVERTS REQUIRED
 Station Diam. Long Conc. Pipe
 366+22 18' 4" 18cy 50"

FIELD NO. STATE DIST. TOWN
 1030 15 50

PLAN
 DATE
 DRAWN BY
 CHECKED BY
 IN CHARGE

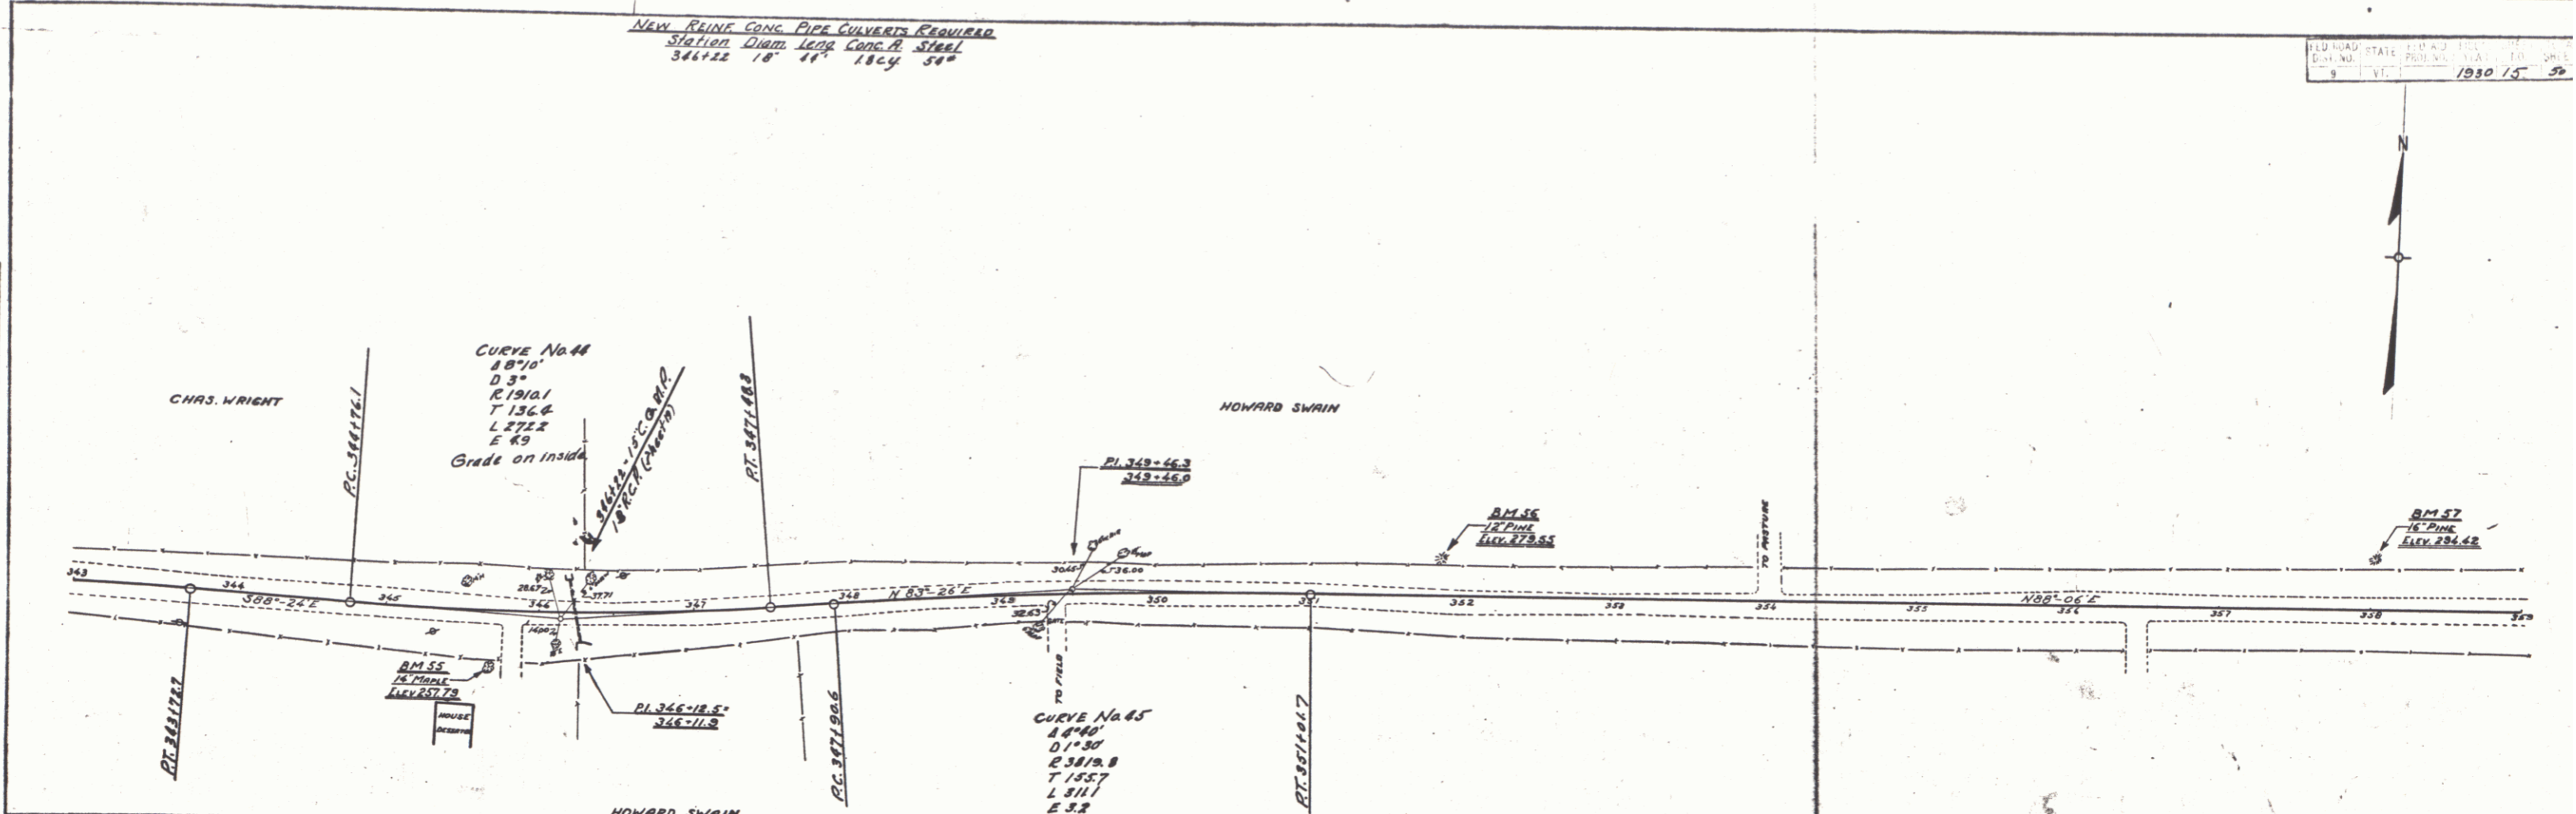

PROFILE
 DATE
 DRAWN BY
 CHECKED BY
 IN CHARGE

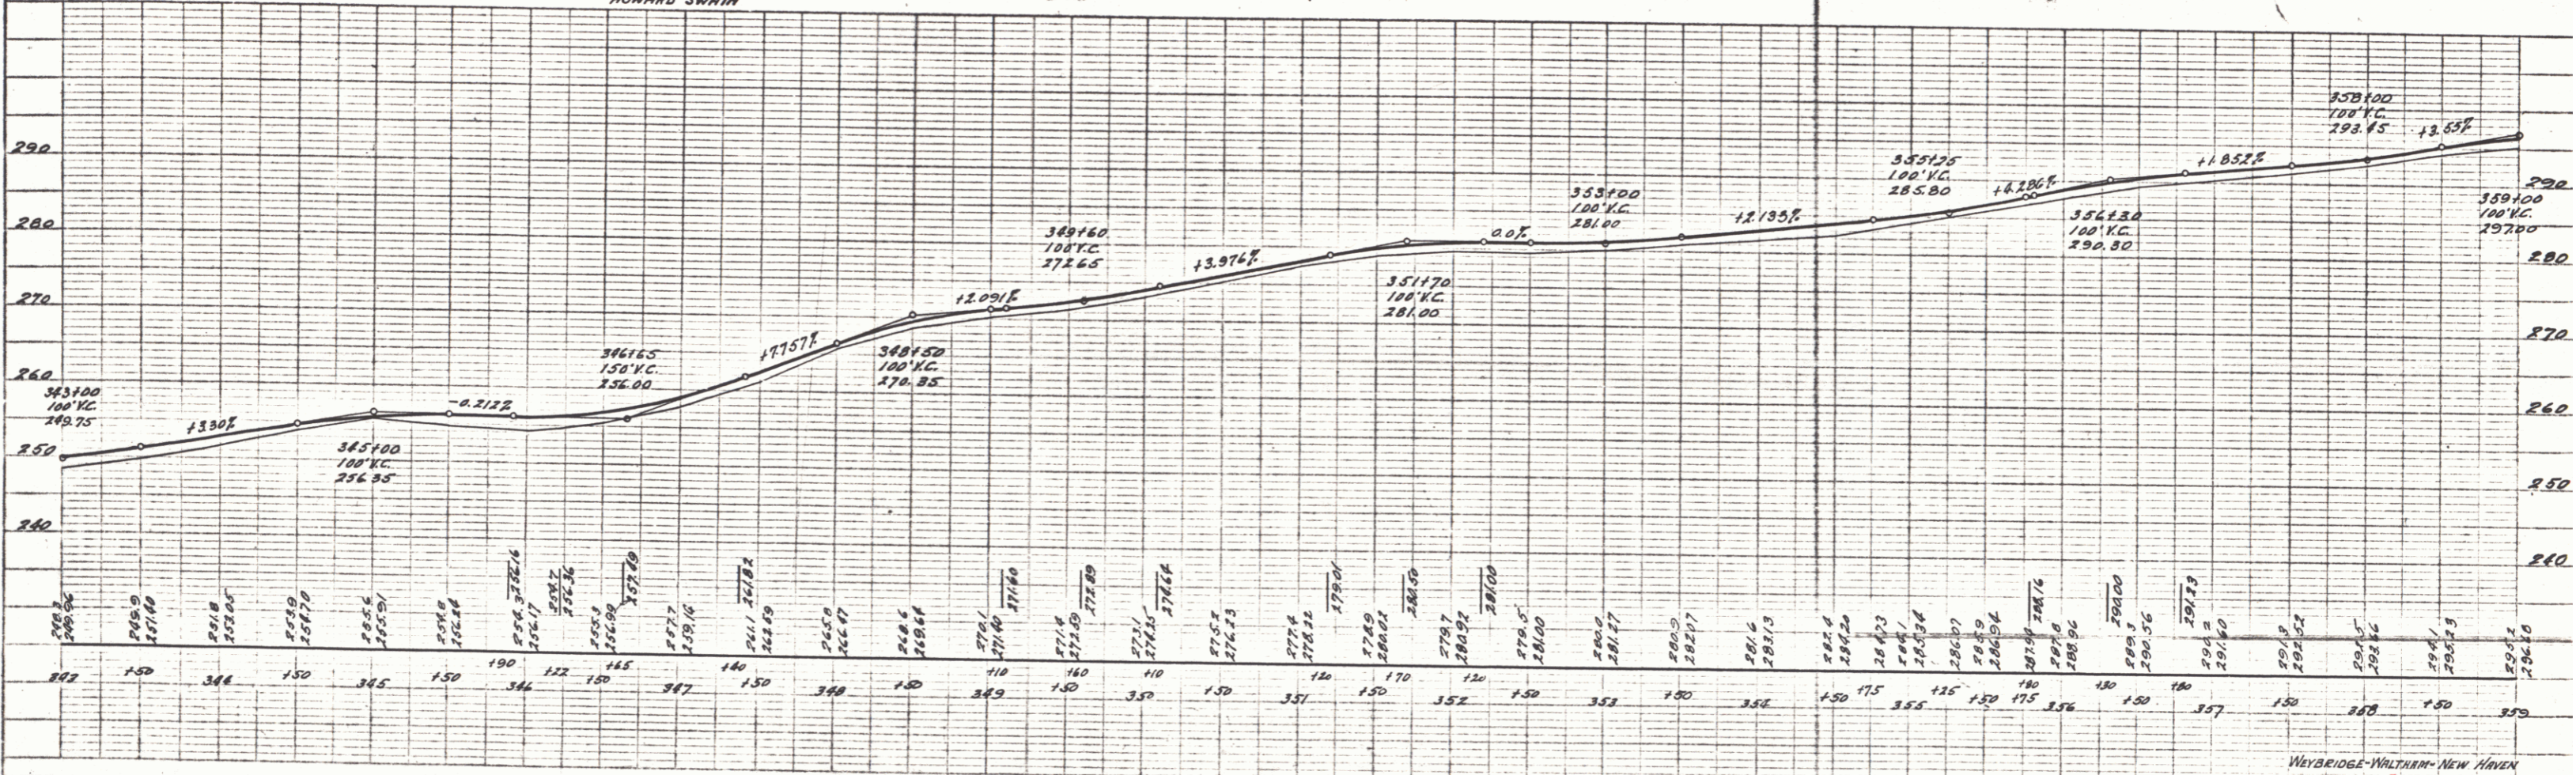


PLATE 1 - PLAN - PROFILE & 3" x 6" SHEET
 10/11/15 & 10/12/15 E.D. 10/15/15

WAYBRIDGE - WALTHAM - NEW HAVEN
 SHEET 13 OF 50