
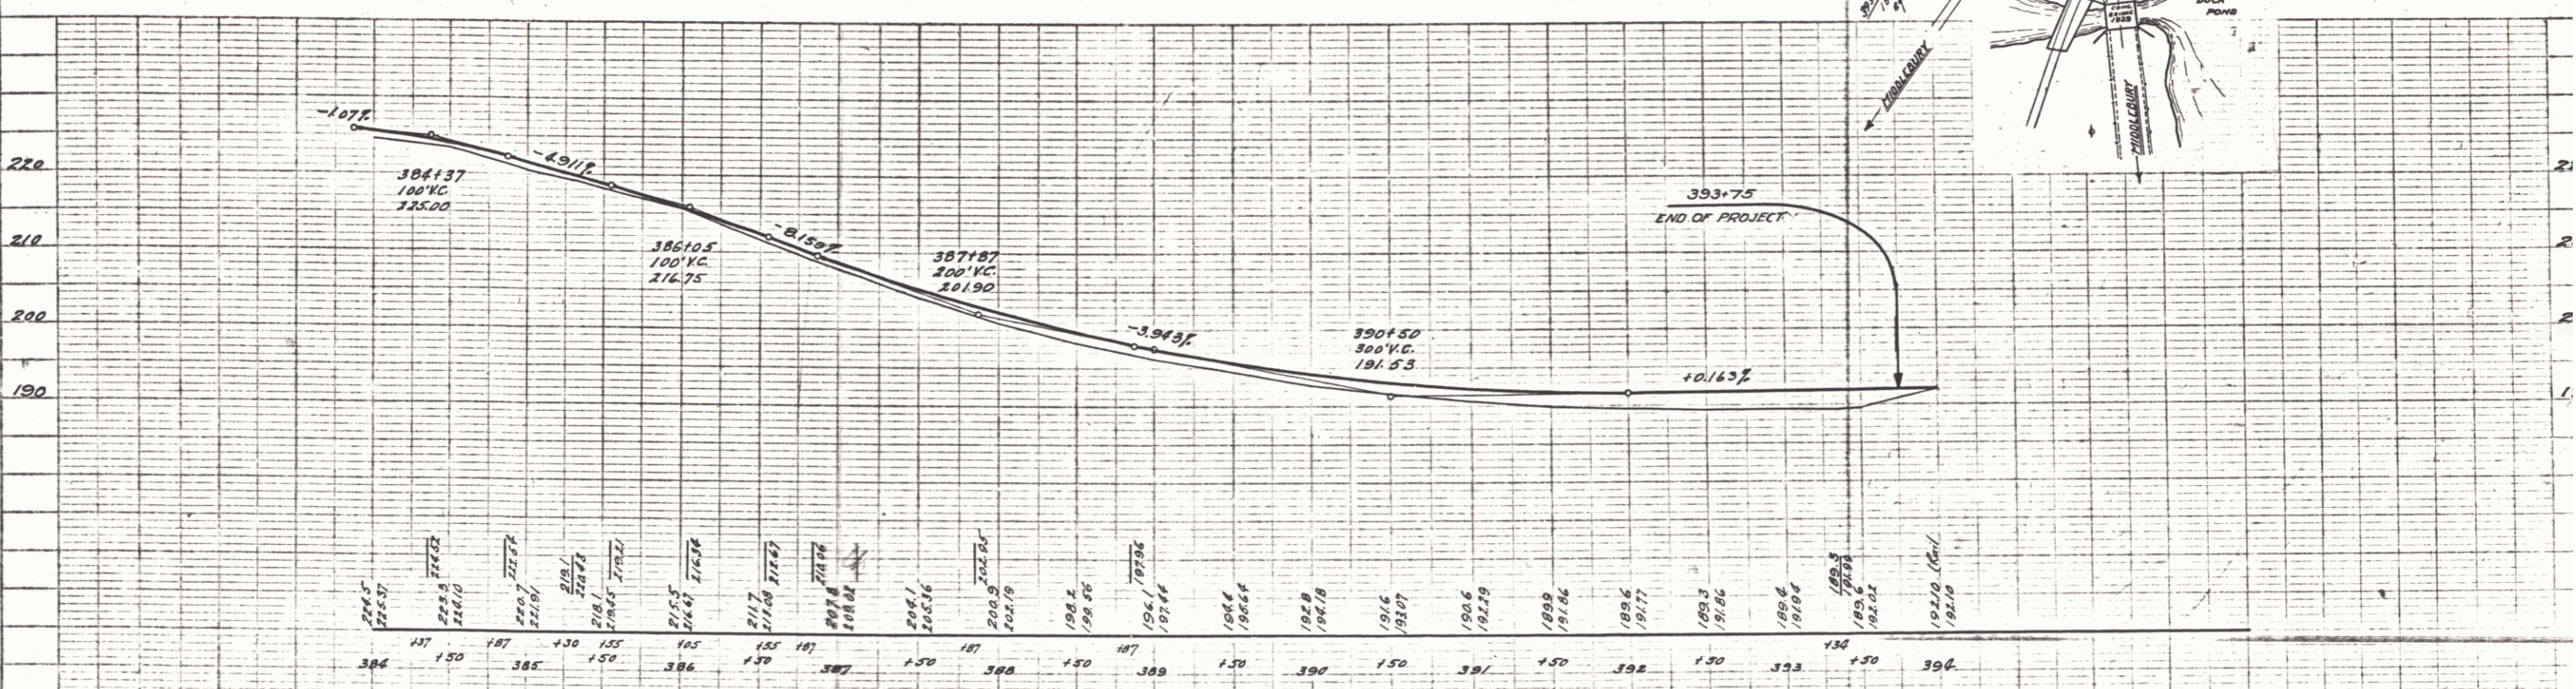


NEW REIN. CONC. PIPE CULVERTS REQUIRED
 Station 383+34 15' 36" 30cy 33

18 ROAD STATE 18.0 18.0 18.0 18.0 18.0
 DIST. NO. STATE PROJ. NO. YEAR NO. SHEET
 9 VT. 1930 18 52

PLAN
 DATE
 DRAWN BY
 CHECKED BY
 IN CHARGE
 TITLE
 SHEET NO.

PROFILE
 DATE
 DRAWN BY
 CHECKED BY
 IN CHARGE
 TITLE
 SHEET NO.

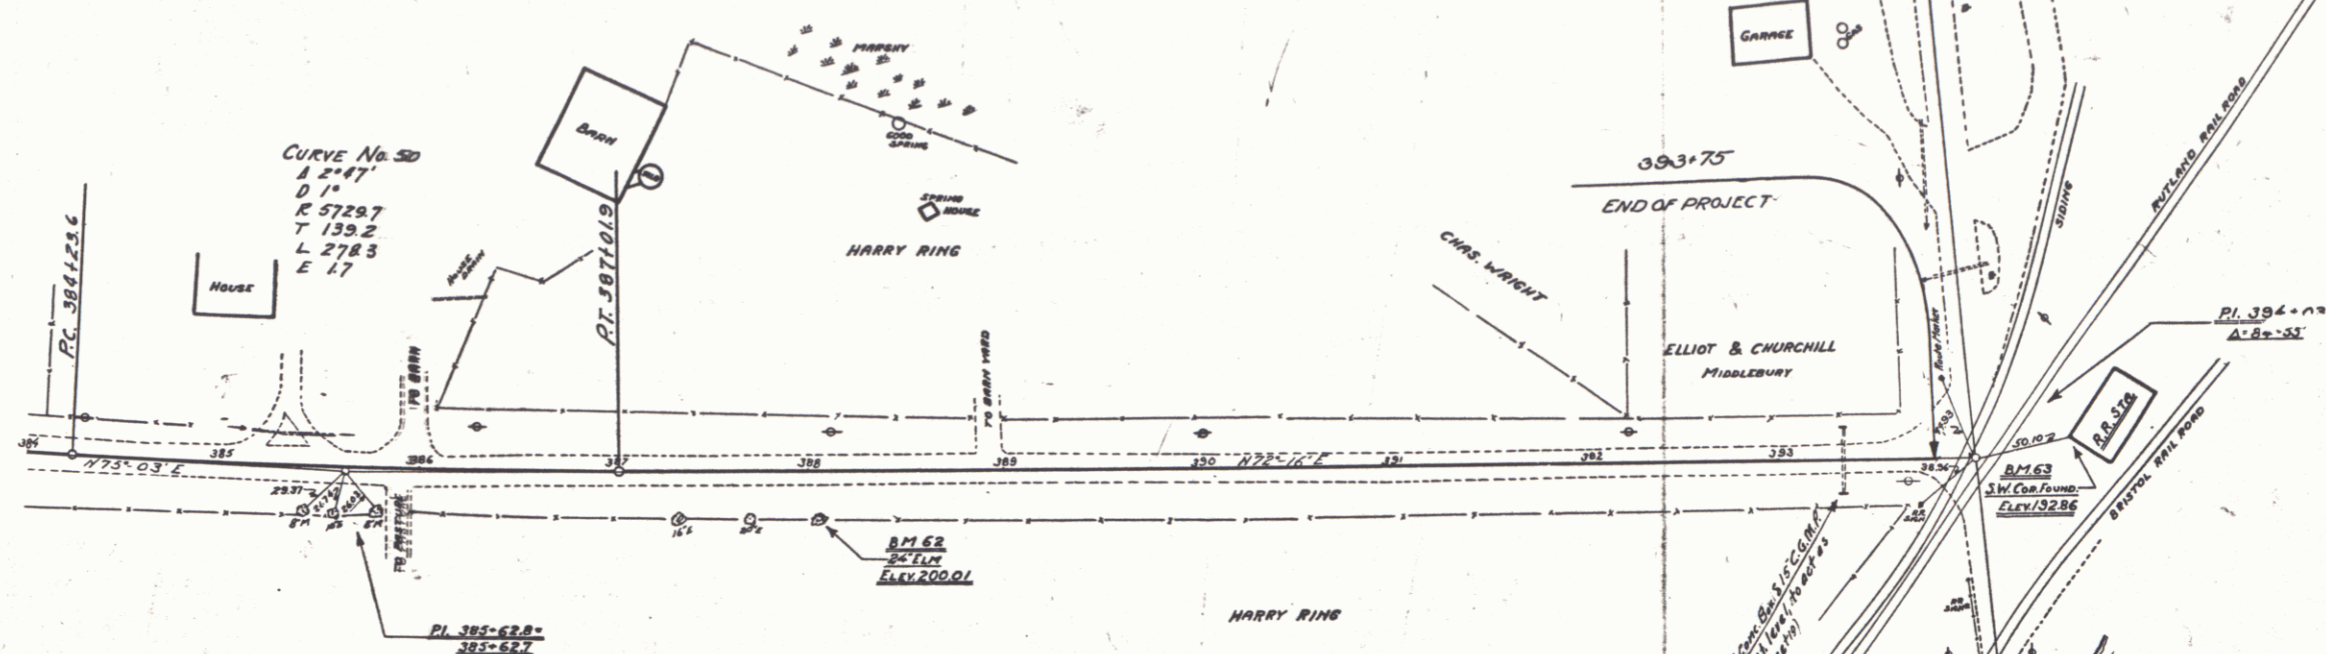

WEYBRIDGE-WALTHAM-NEW HAVEN
 SHEET 18 OF 52

15