


MUCK EXCAVATION
180+00-184+25

TWO CABLE GUARD RAIL
LA RT
183+54-195+74 188+75-195+47
155+75- 20

DRILLING AND BLASTING OF
SOLID ROCK SUBGRADE
185+75-188+75
195+75-196+00

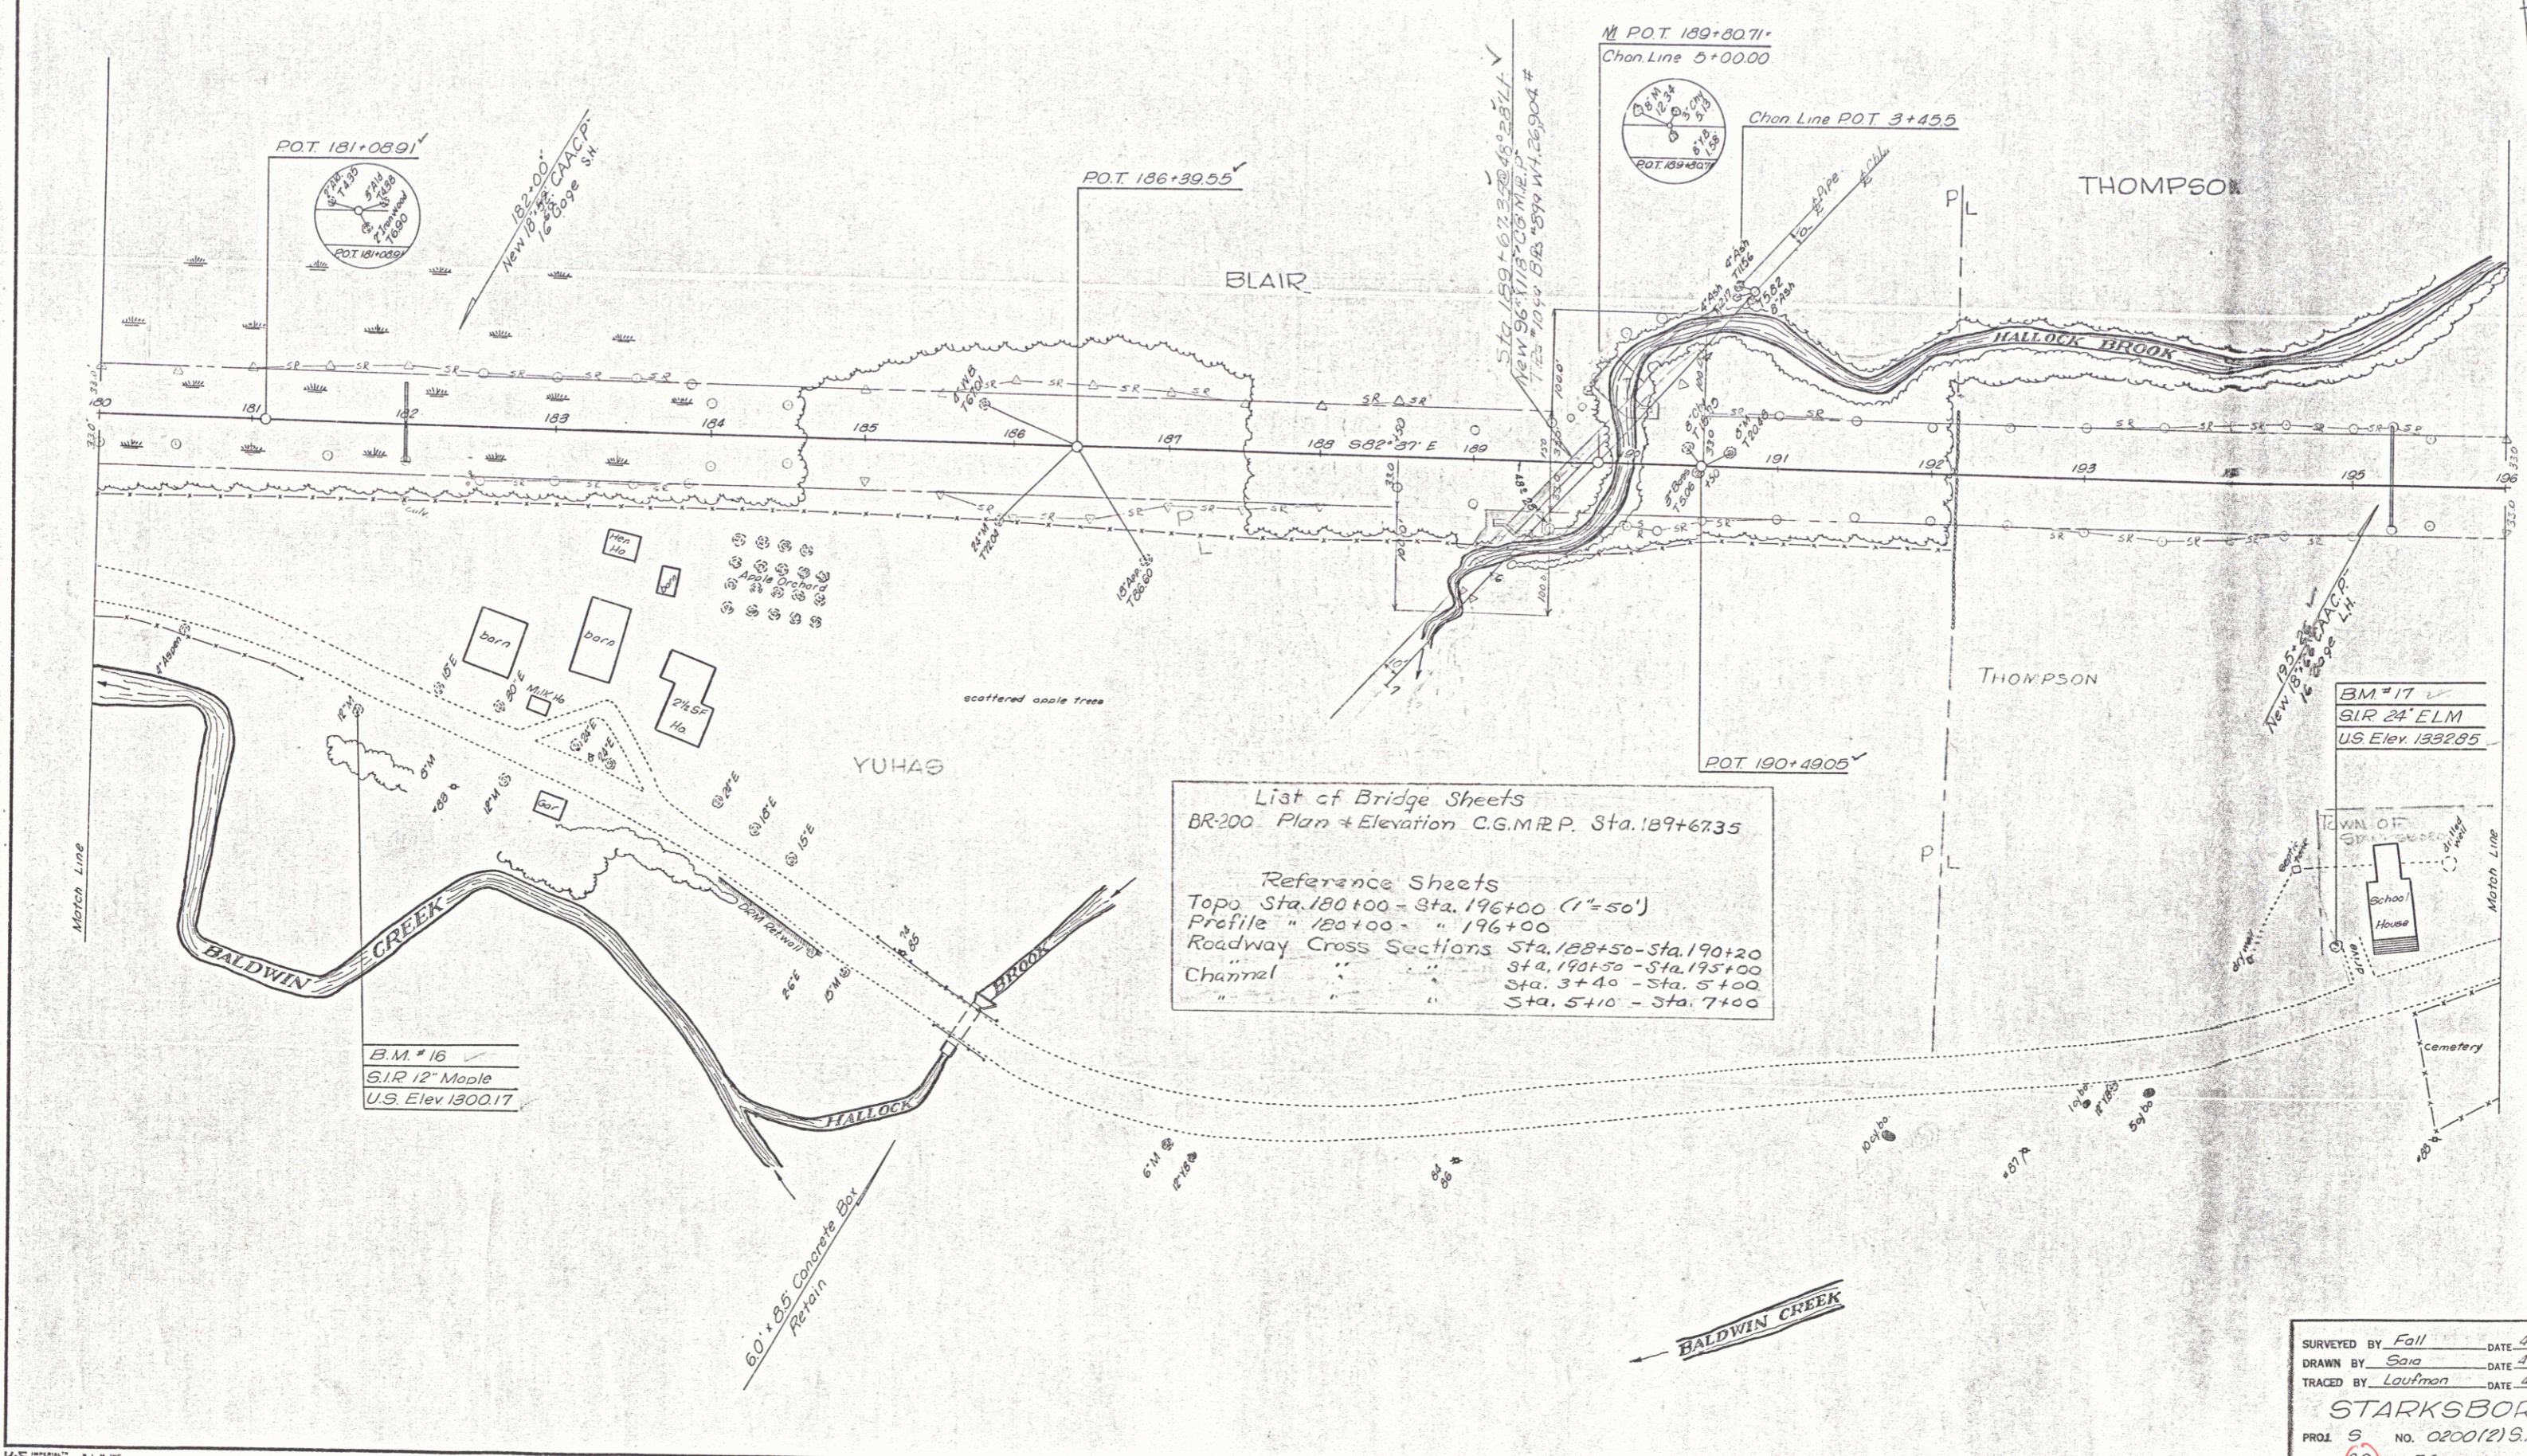

List of Bridge Sheets
BR-200 Plan & Elevation C.G.M.R.P. Sta. 189+6735

Reference Sheets
Topo Sta. 180+00 - Sta. 196+00 (1"=50')
Profile " 180+00 - " 196+00
Roadway Cross Sections Sta. 188+50 - Sta. 190+20
Channel " " Sta. 190+50 - Sta. 195+00
" " " Sta. 3+40 - Sta. 5+00
" " " Sta. 5+10 - Sta. 7+00

B.M. # 16
SIR 12" Maple
US Elev 1800.17

B.M. # 17
SIR 24" ELM
US Elev 1332.95

SURVEYED BY Fall DATE 4-63
DRAWN BY Saig DATE 4-64
TRACED BY Lautman DATE 4-64

STARKSBORO
PROJ. S No. 02001213A
SHEET 32 OF 76