

BRIDGE DATA
 Wood Deck
 Stone Abutments
 Clear Width - 7'
 Clear Height - 4'
 Roadway - 12.5'

CONSTRUCT APPROACH
 Lt. Rt.
 224.78 224.78

MUCK EXCAVATION
 225.50 - 228.00
 232.50 - 237.00


TWO CABLE GUARD RAIL
 Lt. Rt.
 230.52 - 231.43 235.50 - 237.00
 233.24 - 237.09
 5.75 2.25

UNCLASSIFIED CHANNEL EXCAVATION
 CL 1.00 - CL 1.52
 CL 2.60 - CL 3.00

CONSTRUCT SPECIAL Ditch
 (to be paid for under the item of 101-A)
 Rt.
 224.00 - 227.50
 233.50 - 236.00

Curve Data
 Δ 45° 11' 30" Lt.
 D 3° 30'
 R 16370
 T 6813
 L 12912
 E 136.1
 Bank 1/2" in 12"

DRILLING AND BLASTING OF SOLID ROCK SUBGRADE
 232.00 - 232.50

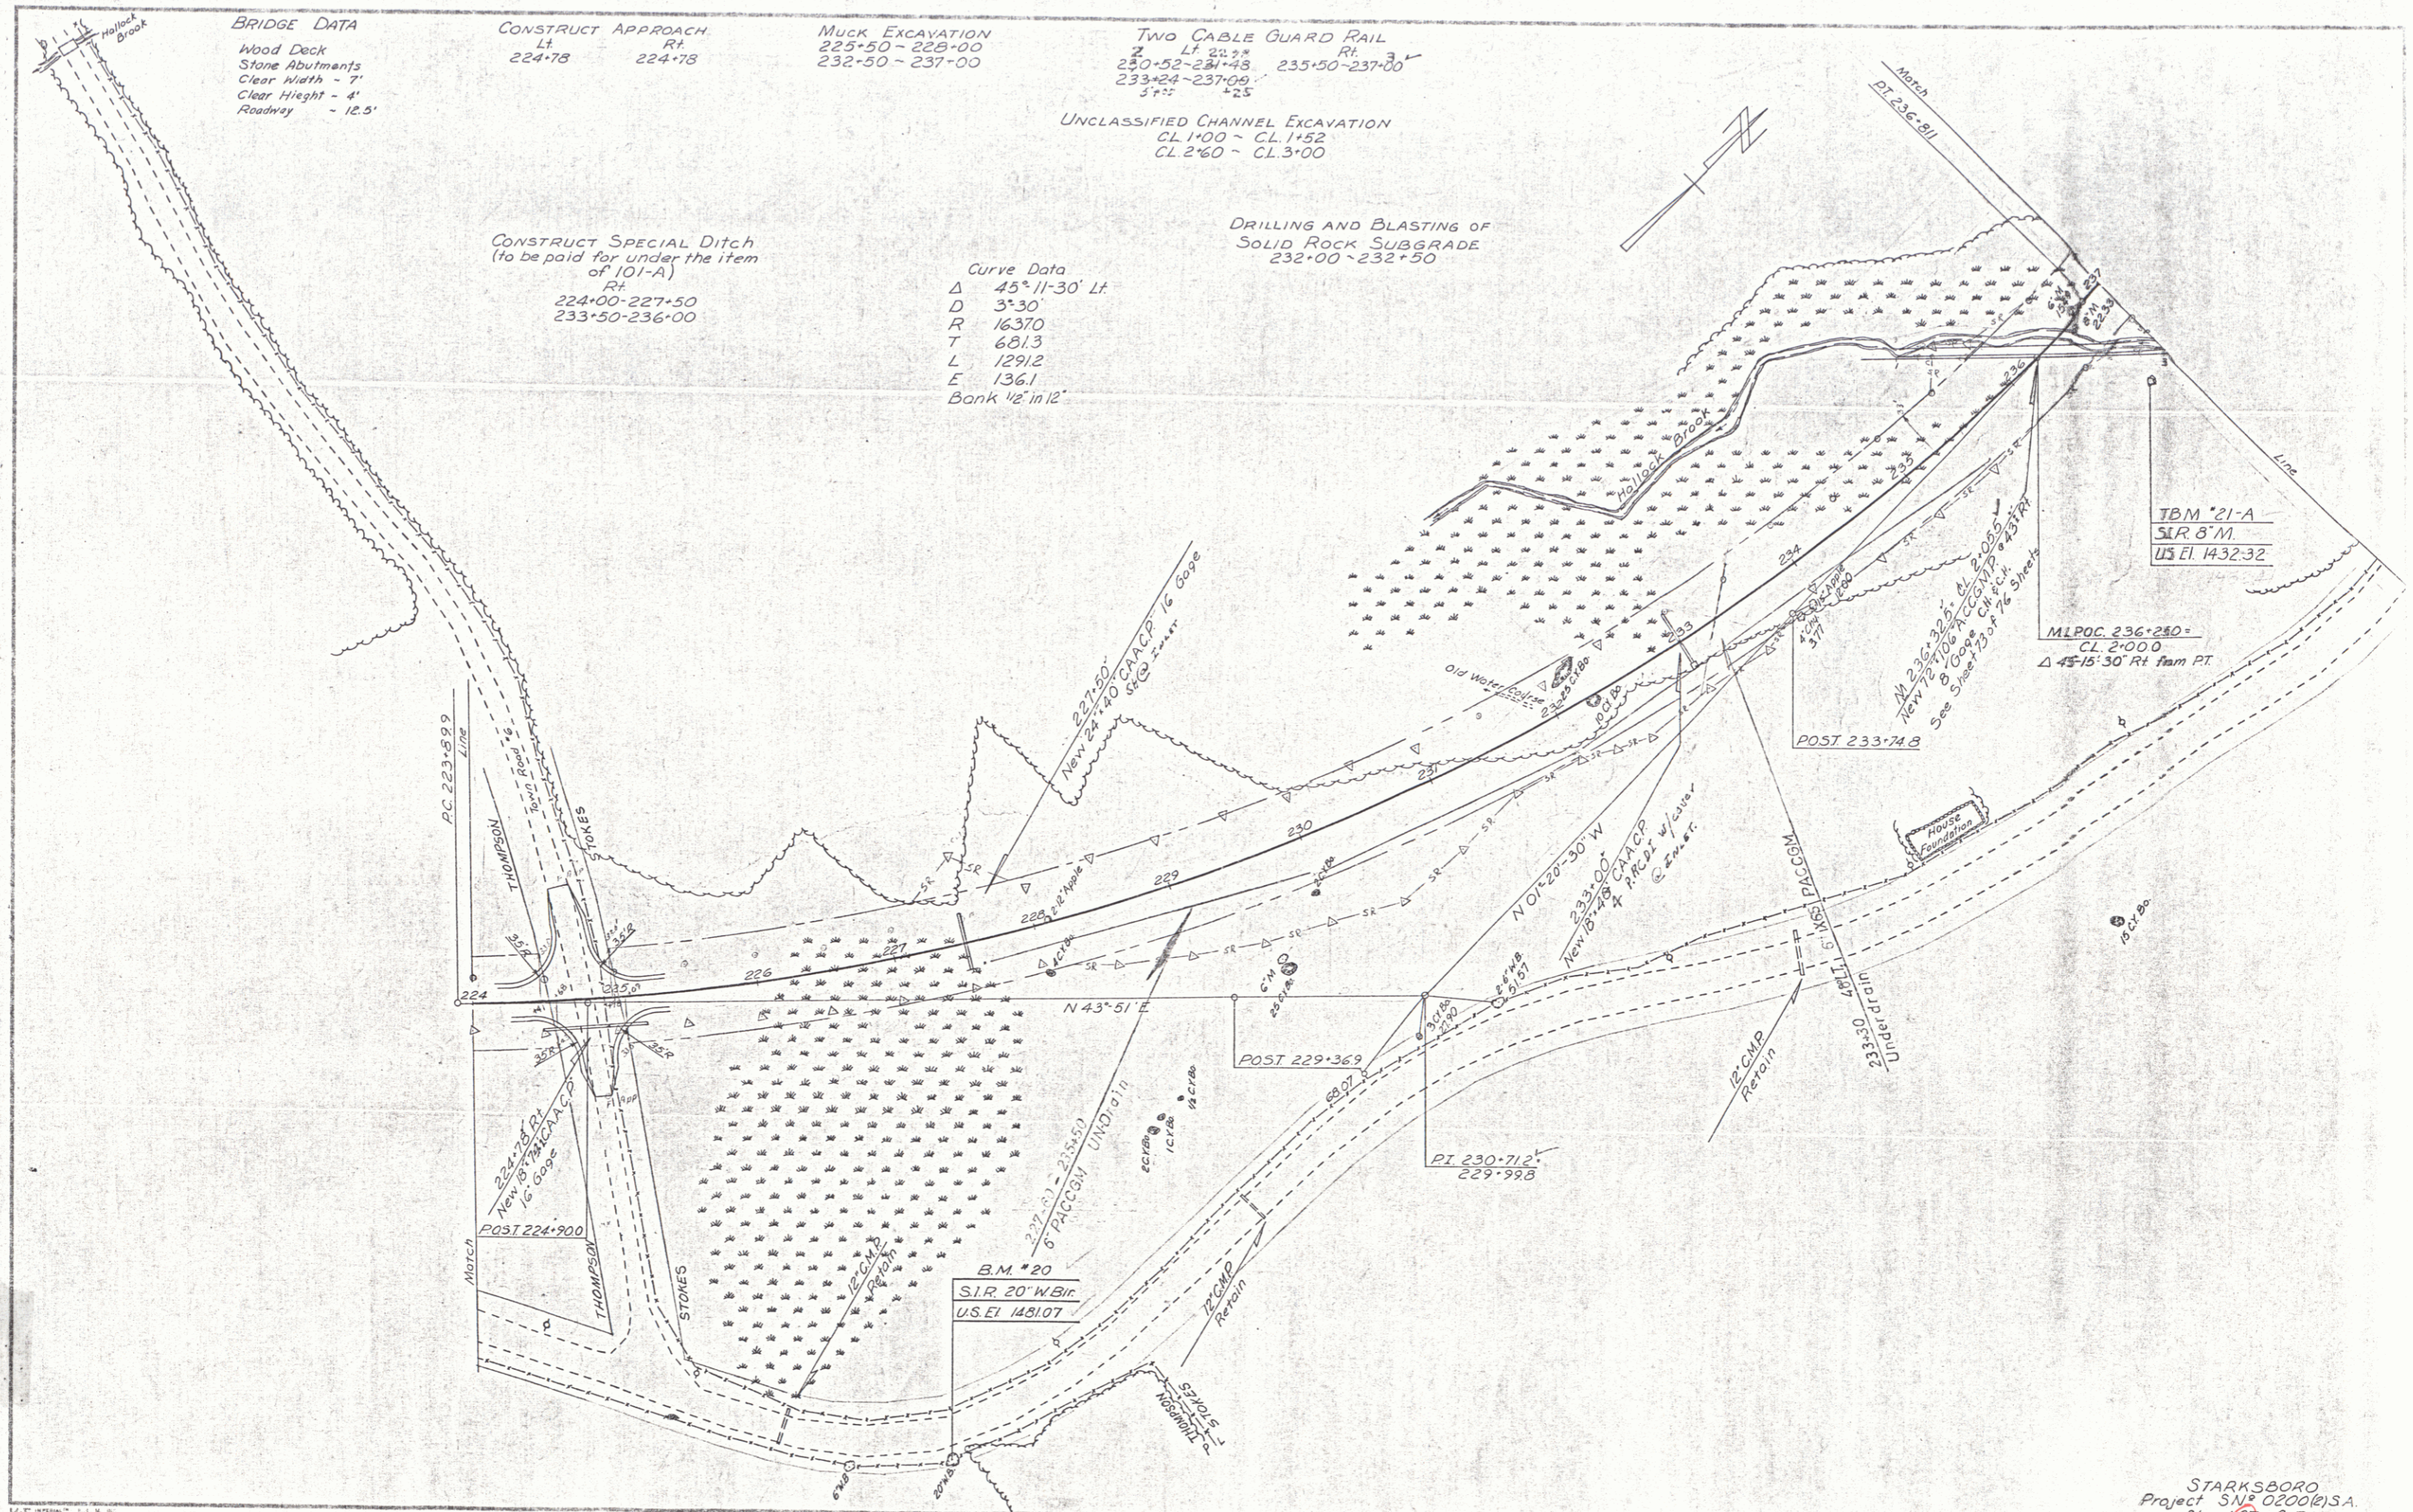

TBM #21-A
 S.I.R. 8' M.
 U.S. El. 1432.32

M.L.P.O.C. 236-240
 CL 2.000
 Δ 45-15-30 Rt. from PT.

B.M. #20
 S.I.R. 20' W.B.I.R.
 U.S. El. 1481.07

STARKSBORO
 Project S.N. 0200125A
 Sheet 37 of 76