


12-81
1-82
C.E.H.

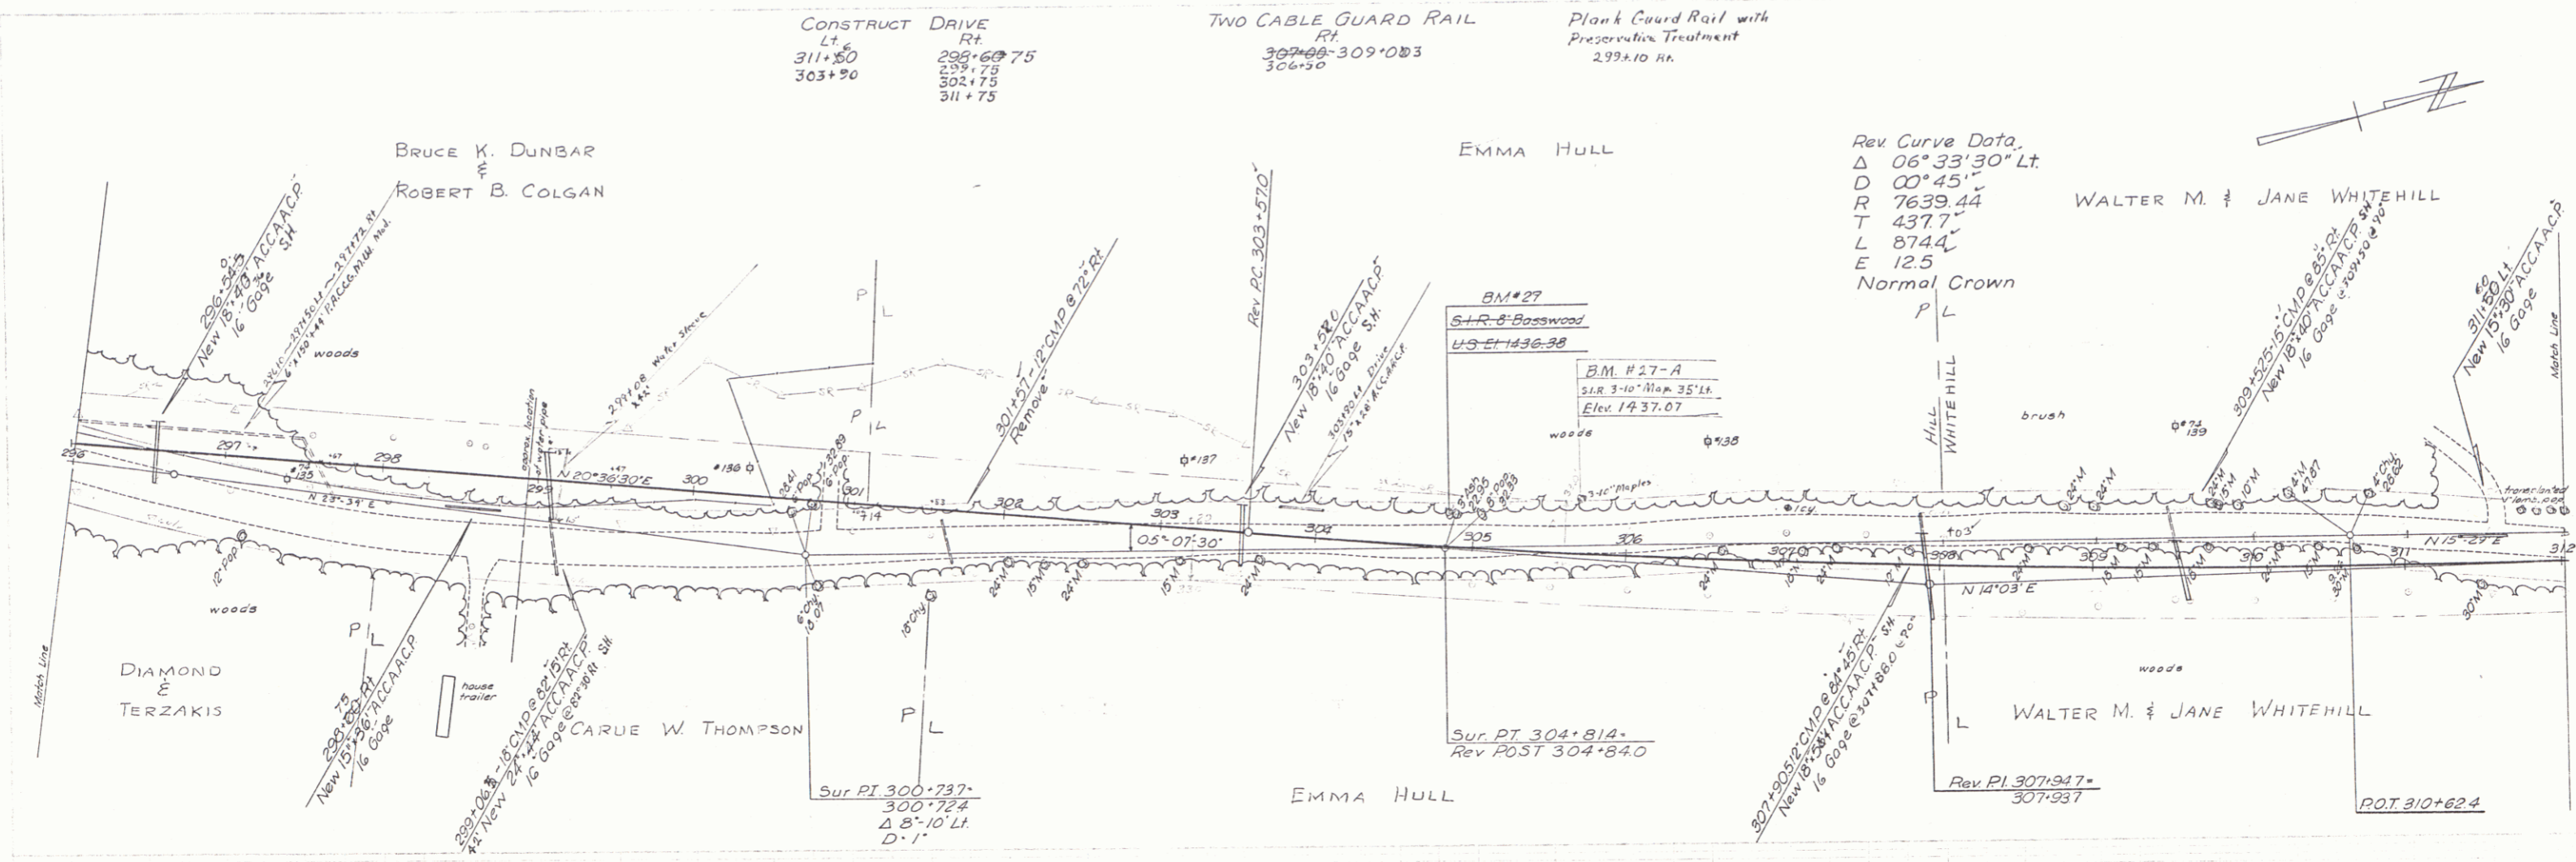


CONSTRUCT DRIVE
LT. 311+50
RT. 303+90

TWO CABLE GUARD RAIL
RT. 307+00-309+00
306+50

Plank Guard Rail with Preservation Treatment
2.99:10 RR.

Rev Curve Data,
Δ 06°33'30" Lt.
D 00°45'
R 7639.44
T 437.7'
L 874.4'
E 12.5'
Normal Crown

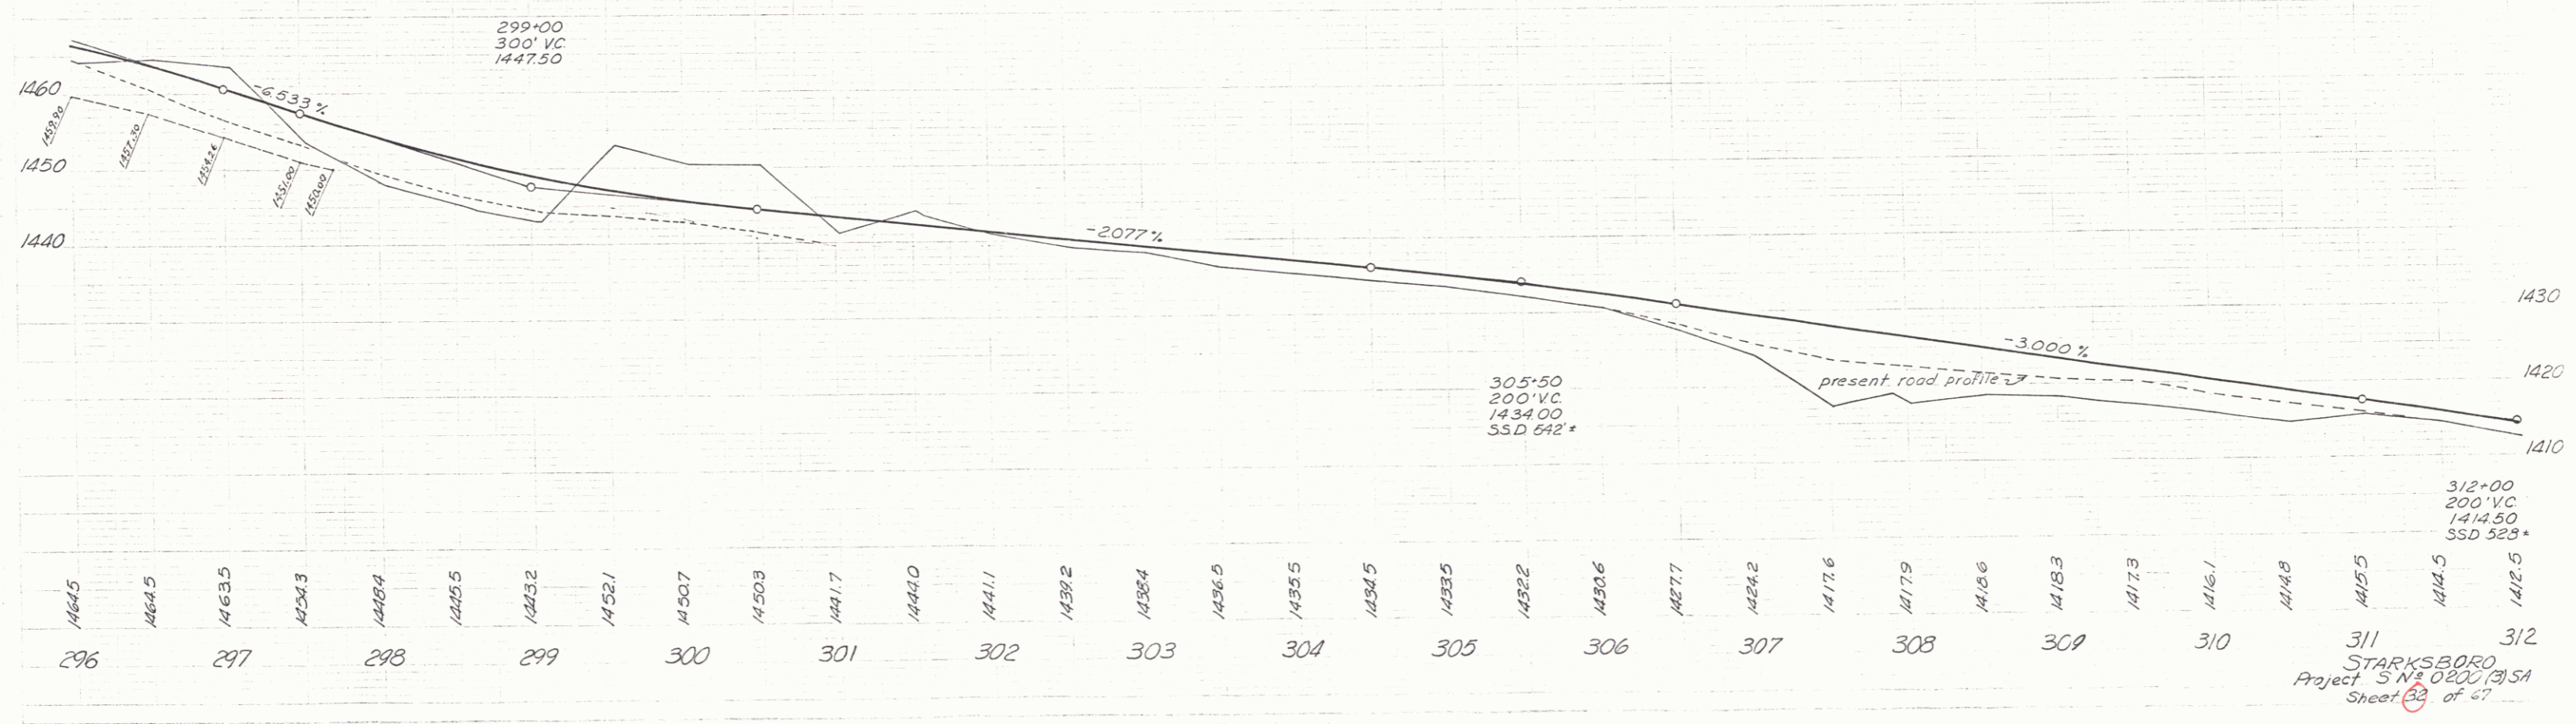

Van Miganen 10-81
C.E.H.

311
STARKSBORO
Project S N 0200 (3) SA
Sheet 33 of 67