
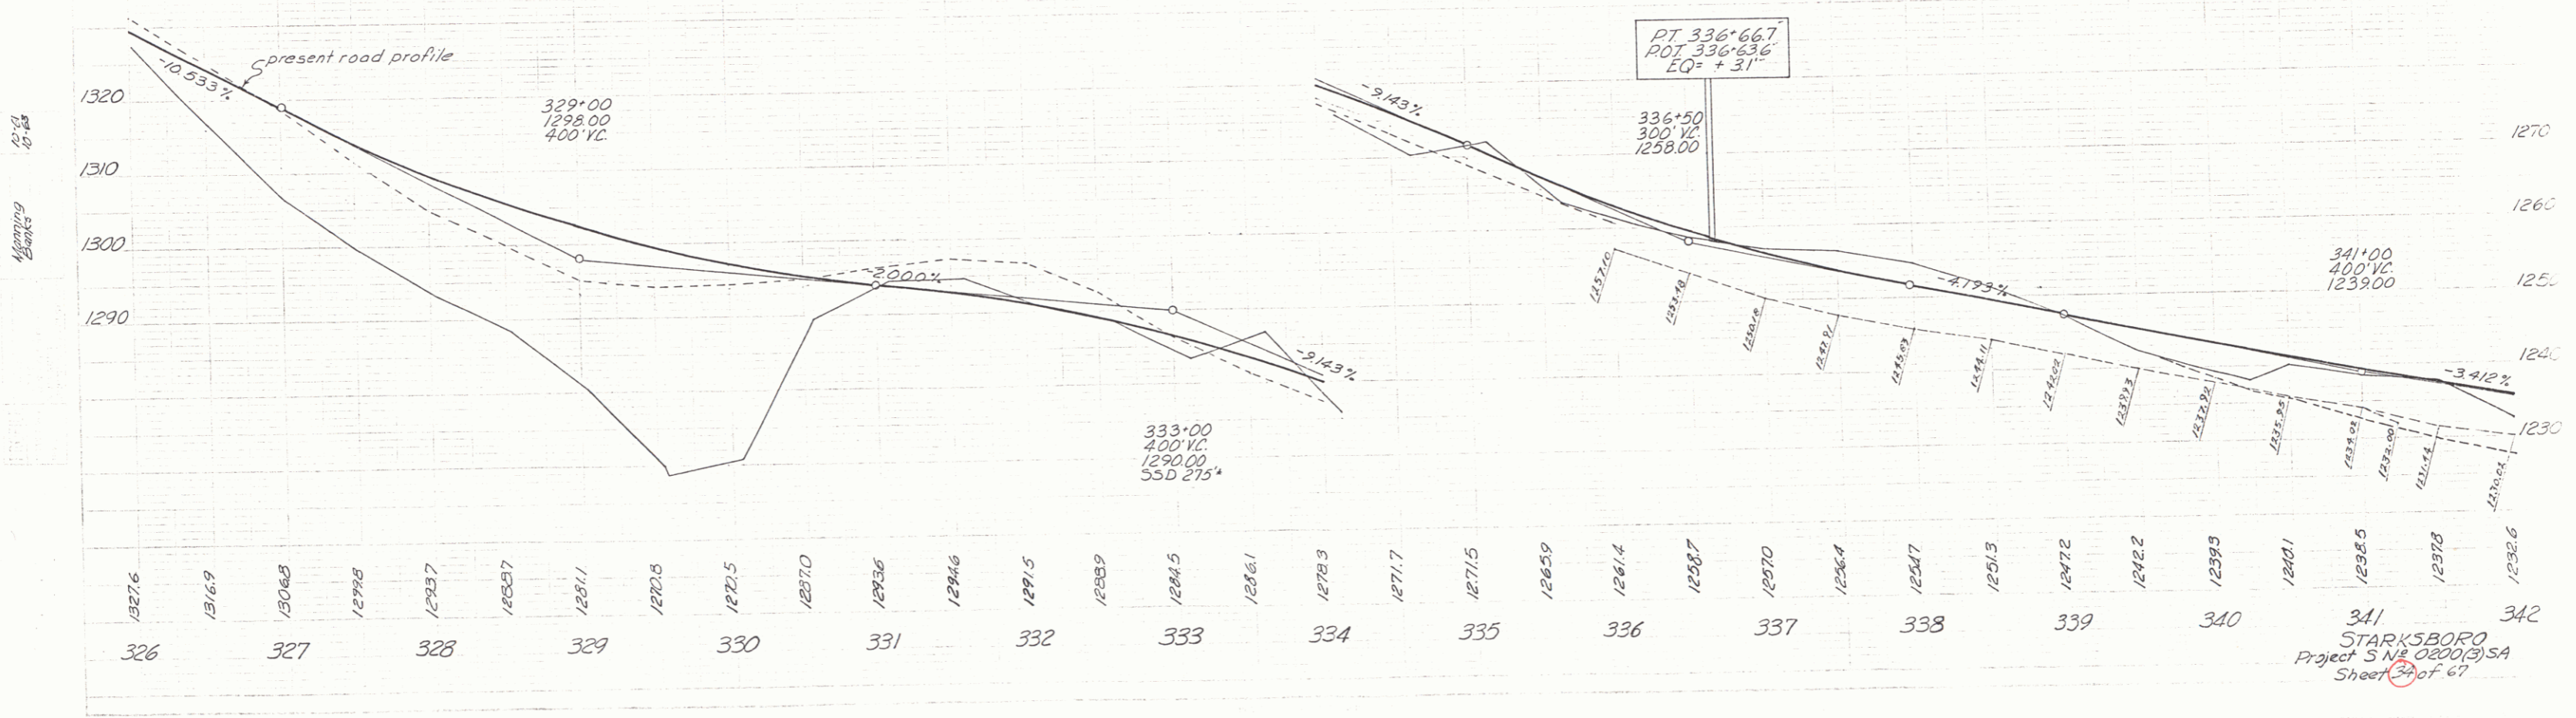


10' = 1" (Vertical)
 1" = 100' (Horizontal)
 C.E.H. 1-62

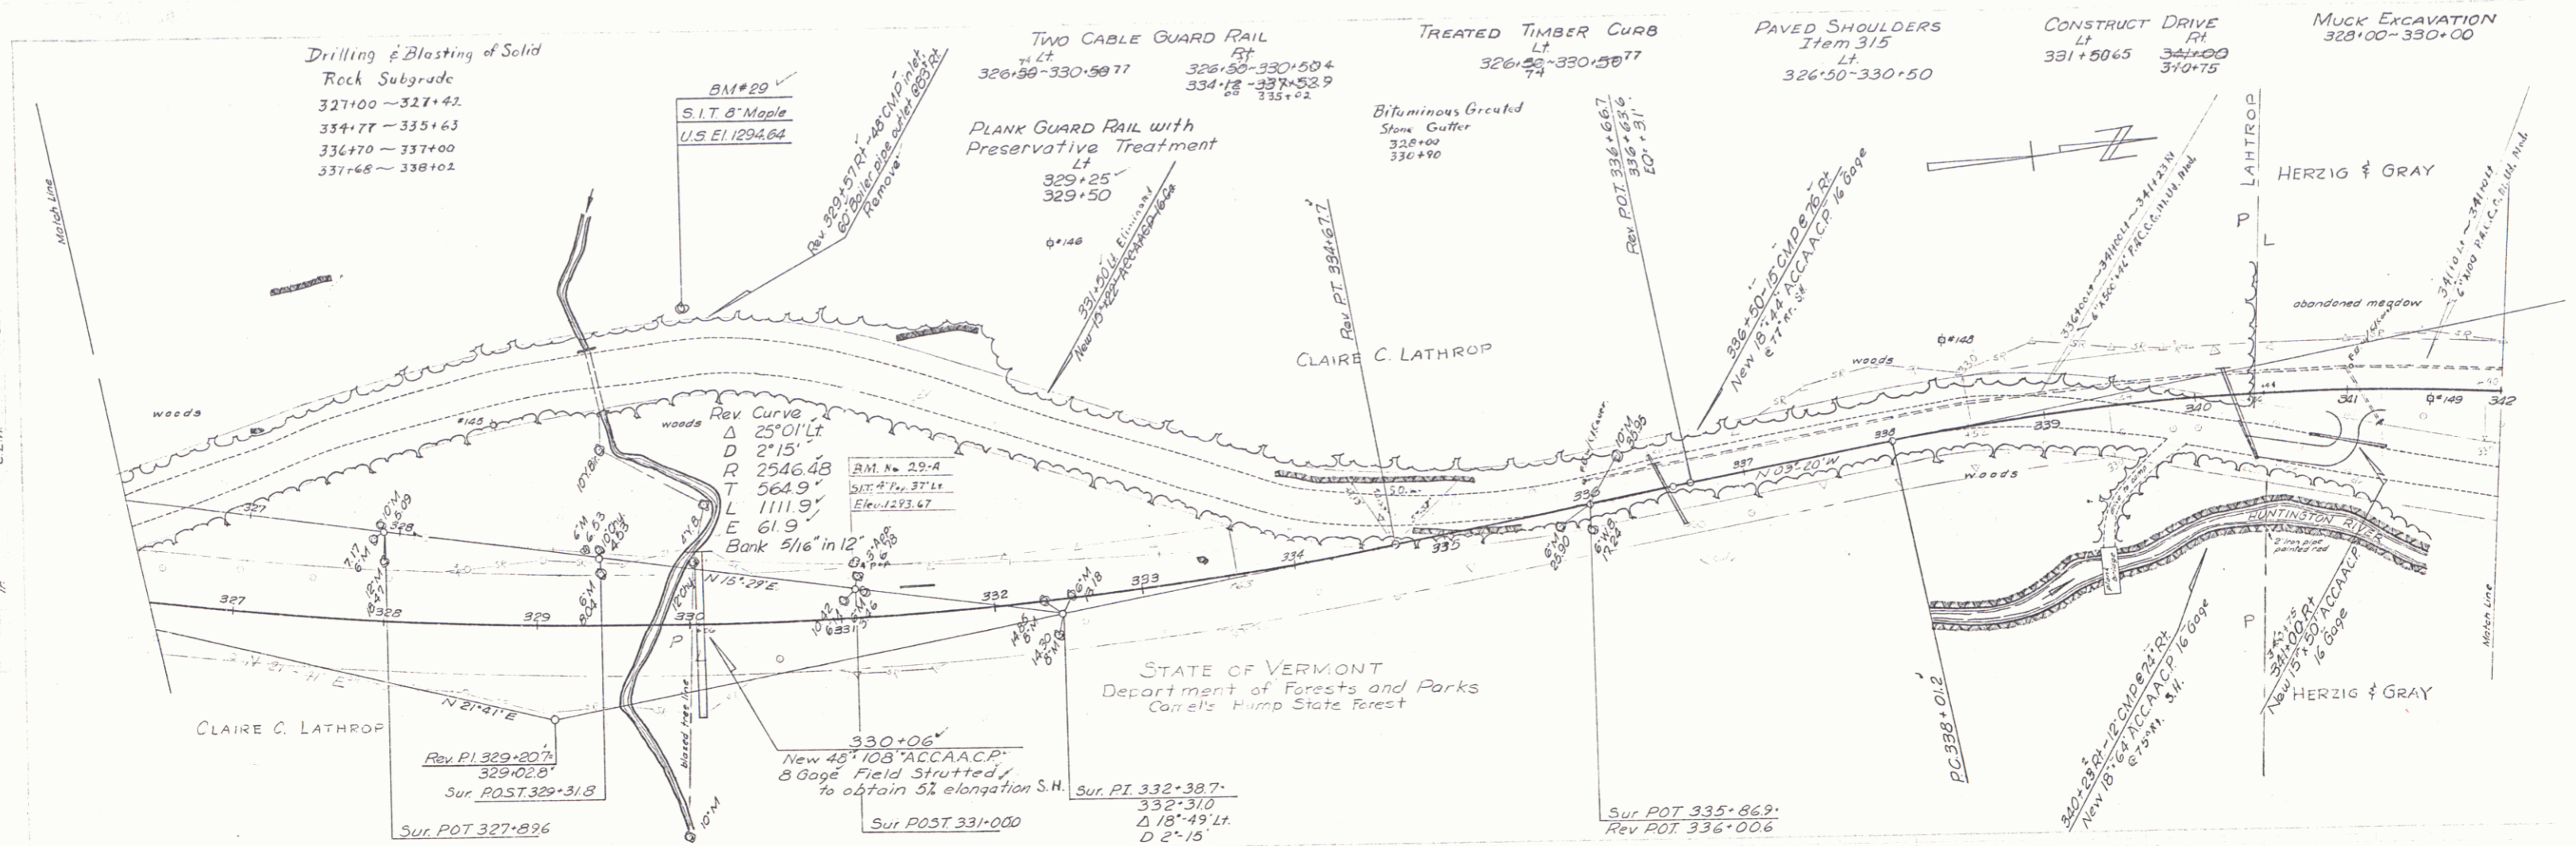

STARKSBORO
 Project S N 0200(3) SA
 Sheet 30 of 67