

INDEX OF SHEETS

SHEET NO. 1	TITLE PAGE
2	TYPICAL CROSS SECTION OF IMPROVEMENT (GRAVEL SURFACE COURSE, ITEM 301)
3	BANKING AND WIDENING TABLES
4	QUANTITY SHEET (ITEMS AND DRAINAGE)
5-7	EARTHWORK SHEETS
8	CONSTRUCTION DETAILS CD (DRAINAGE AND MARKERS)
9	CONSTRUCTION DETAILS CD-1 (DITCHES)
10	STANDARD STRUCTURE SHEET S 40 (BARRICADES, SIGNS AND LIGHTS)
11	STANDARD STRUCTURE SHEET S 46-45 (TWO GABLE GUARD RAIL)
12-18	PLAN AND PROFILE SHEETS
20-49	CROSS SECTIONS

STANDARD STRUCTURE SHEET APPROVED BY THE CHIEF ENGINEER, VERMONT STATE DEPARTMENT OF HIGHWAYS...
S 40 JUNE 10, 1950

PROJECT NAME & NO.	TYPE
Buel's Gore ST #2 West	Gravel Surface Course
RECORD PLANS	
MATERIALS	
SUB-BASE OF GRAVEL Thompson Pl. Starksboro Vt Brace Pl. (River) Huntington Vt	ACCOMP & UNDERDRAIN N.E. METAL CULV. CO. BOSTON, MASS.
GRAVEL SURFACE COURSE Cass Warner Pl. Minesboro Vt	2 CABLE GUARD RAIL BETHLEHEM STEEL CO. SPARKS POINT, MD.
CONTRACTOR- OLSON CONST. CO. RES. ENG'S- SCRIBNER-GRAHAM RECORD PLANS SCRIBNER	CONTRACT DATED AUG 11, 1955 CONTRACT STARTED AUG 16, 1955 CONTRACT COMPLETED JULY 30, 1957 CONTRACT ACCEPTED JULY 30, 1957

STATE OF VERMONT
DEPARTMENT OF HIGHWAYS
PROPOSED IMPROVEMENT


TOWN OF BUEL'S GORE
A. MC CULLOUGH HIGHWAY
APPALACHIAN GAP
COUNTY OF CHITTENDEN

BEGINNING AT A POINT 803.3 FEET WEST OF THE CHITTENDEN-WASHINGTON COUNTY LINE AND EXTENDING WESTERLY 9,193.1 FEET.


LENGTH OF PROJECT 9,193.1 FEET = 1.741 MILES
9.126 1.737

See 1950 Survey for location of right-of-way between bounds.

STATE PROJECT NO.	STATE PROJECT V. YEAR	SHEET NO.	TOTAL SHEETS
1	VI	ST 2 EXT	49

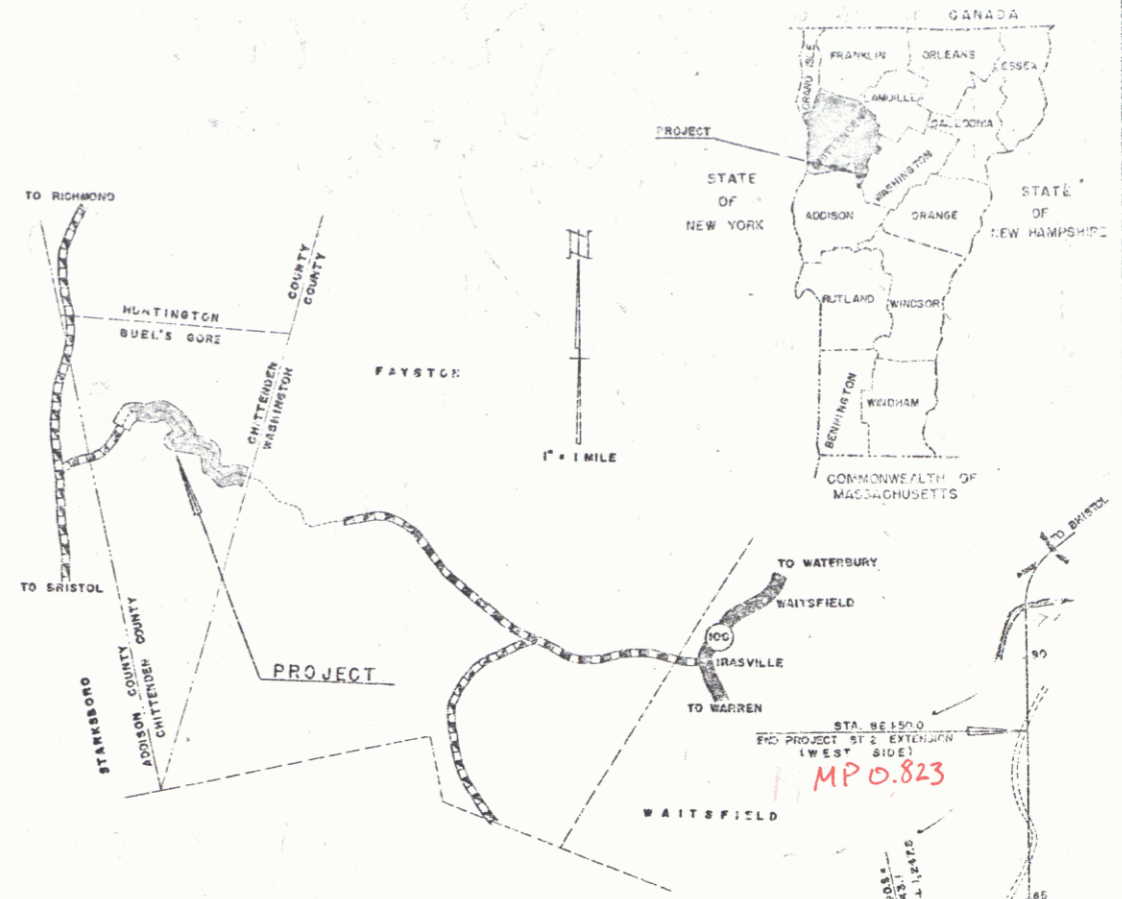

M Buel's Gore '55-57

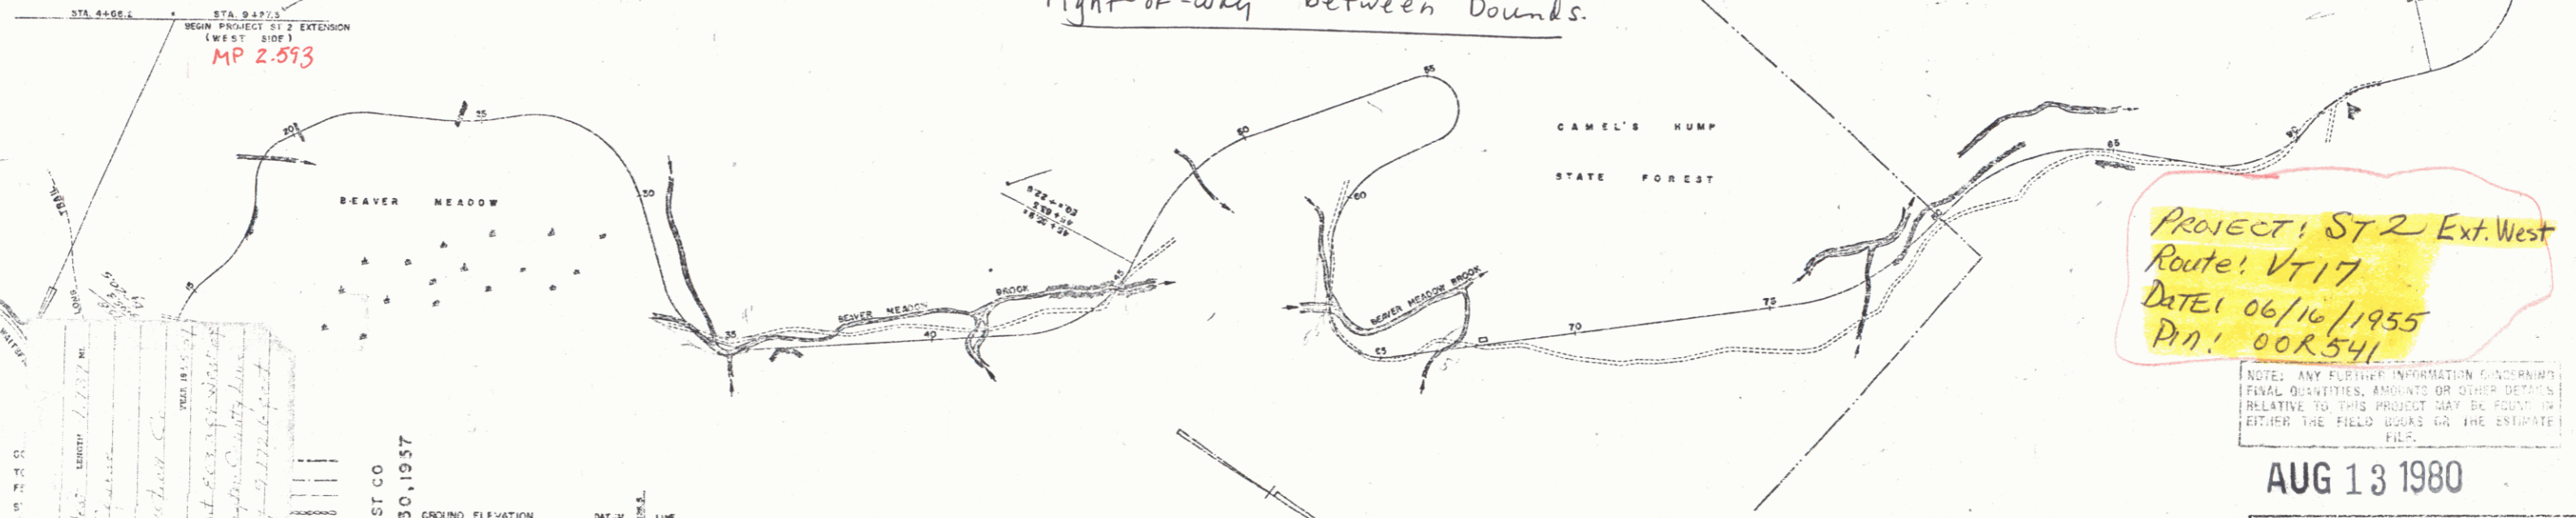

PROJECT: ST 2 Ext. West
ROUTE: VT 17
DATE: 06/16/1955
P.N.: 00R541

PROJECT: ST 2 Ext. West
Route: VT 17
DATE: 06/16/1955
P.N.: 00R541

NOTE: ANY FURTHER INFORMATION CONCERNING FINAL QUANTITIES, AMOUNTS OR OTHER DETAILS RELATIVE TO THIS PROJECT MAY BE FOUND IN EITHER THE FIELD BOOKS OR THE ESTIMATE FILE.

AUG 13 1980

BUELS GORE ST 2 WEST
CONTRACTOR OLSON CONST CO
CONST. COMPLETED JULY 30, 1957

GROUND ELEVATION	DATUM	UNIT
GRADE ELEVATION	DATUM	UNIT

CURVE DATA

DEFLECTION OF ANGLE	A
DEGREE OF CURVE	D
RADIUS OF CURVE	R
TANGENT DISTANCE	T
LENGTH OF CURVE	L
EXTERNAL DISTANCE	E
POINT OF INTERSECTION	P.I.
POINT OF CURVE	P.C.
POINT OF TANGENT	P.T.
POINT ON TANGENT	P.O.T.
POINT ON SUB-TANGENT	P.O.S.T.

SCALES

TITLE	1" = 200'
TYPICAL	1" = 4'
PLAN	1" = 80'
PROFILE HORIZONTAL	1" = 80'
PROFILE VERTICAL	1" = 10'
CROSS-SECTIONS	1" = 8'

THESE PLANS ARE SUBJECT TO SUCH REVISIONS AS MAY BE REQUIRED BY THE BUREAU OF PUBLIC ROADS OR THE COMMISSIONER OF HIGHWAYS.

CONSTRUCTION IS TO BE CARRIED OUT IN ACCORDANCE WITH THE PLANS AND THE STANDARD ROAD AND BRIDGE SPECIFICATIONS OF 1946, AS APPROVED JULY 25, 1959 BY THE BUREAU OF PUBLIC ROADS, INCLUDING ALL SUBSEQUENT APPROVED REVISIONS AND SUCH REVISED SPECIFICATIONS AND SPECIAL PROVISIONS AS ARE SUBMITTED WITH THE PLANS.

DEPARTMENT OF COMMERCE
BUREAU OF PUBLIC ROADS

APPROVED: *[Signature]* DATE: 6-20-55
APPROVED: *[Signature]* DATE:
APPROVED: *[Signature]* DATE: 6-24-55
APPROVED: *[Signature]* DATE: JUNE 16, 1955
APPROVED: *[Signature]* DATE: JUNE 16, 1955

PROJECT: ST NO. 2 EXTENSION
SHEET 1 OF 49 SHEETS