
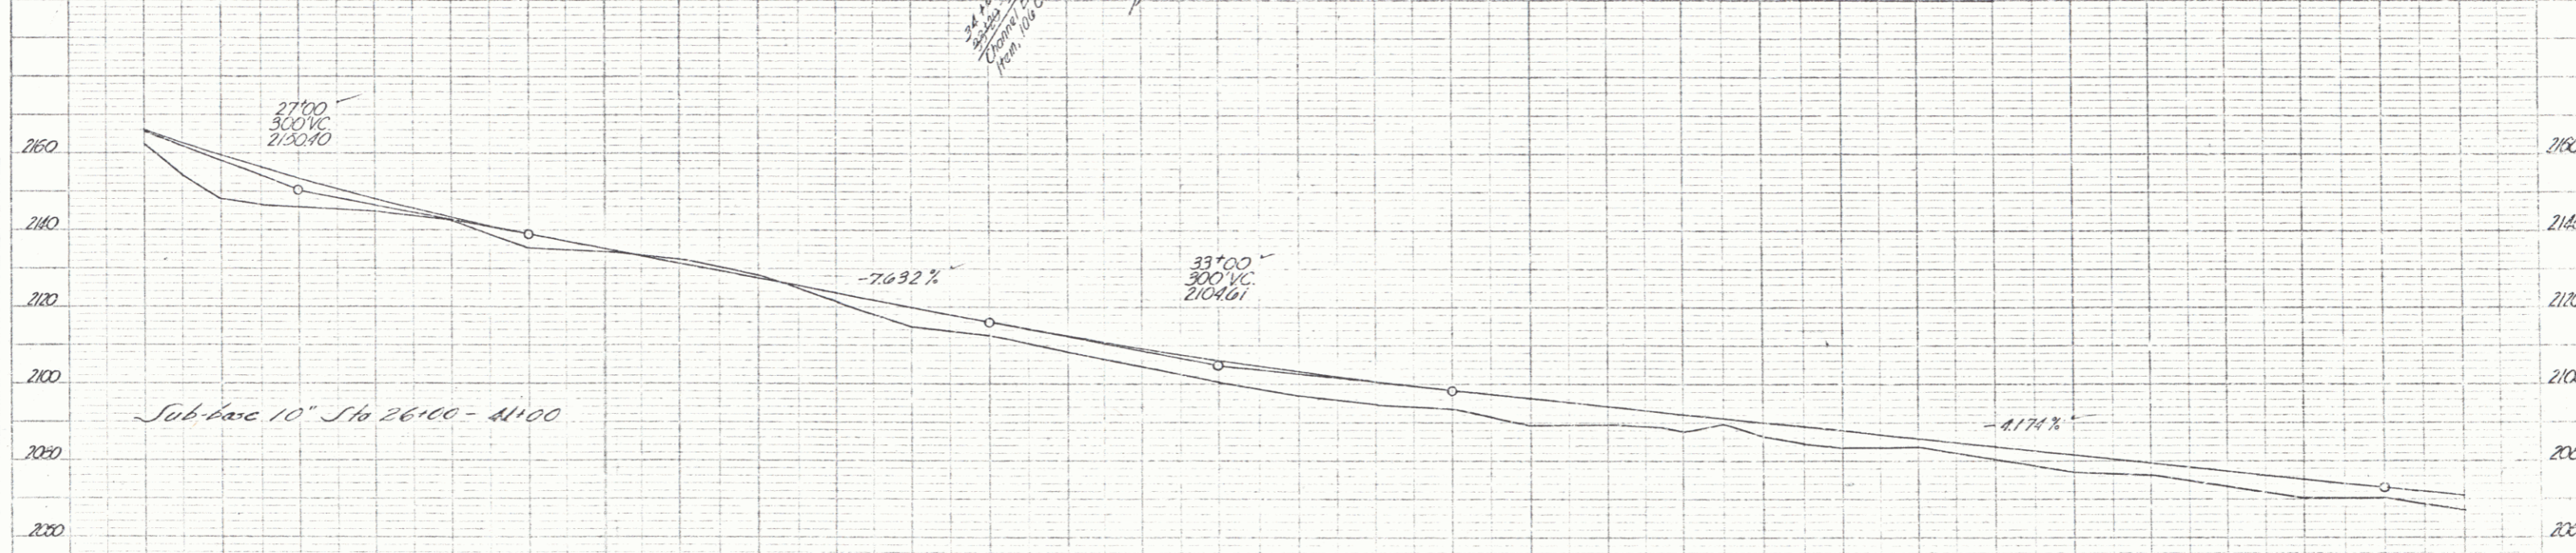


PLAN	DATE
REVISIONS	
NO. 1	
NO. 2	
NO. 3	
NO. 4	
NO. 5	
NO. 6	
NO. 7	
NO. 8	
NO. 9	
NO. 10	

PROFILE	DATE
REVISIONS	
NO. 1	
NO. 2	
NO. 3	
NO. 4	
NO. 5	
NO. 6	
NO. 7	
NO. 8	
NO. 9	
NO. 10	

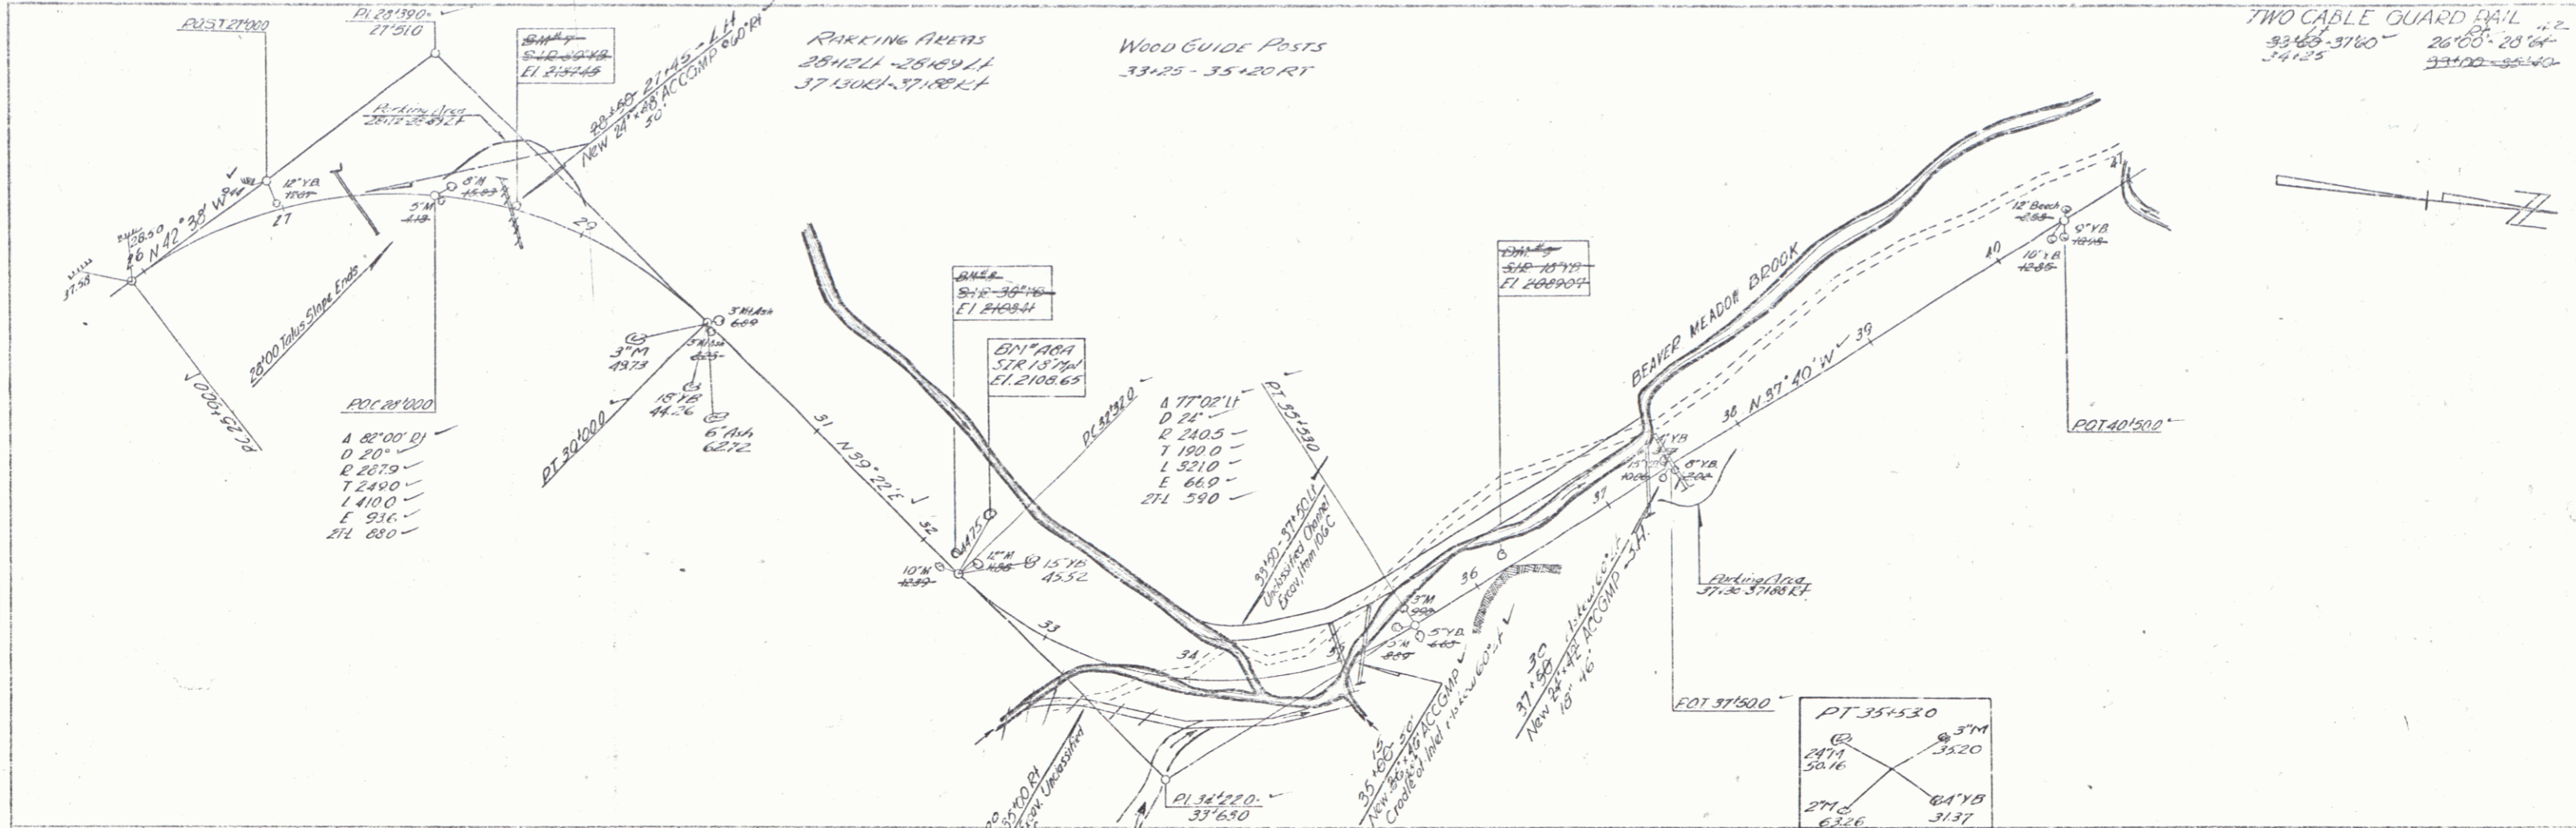

BM#7 2+11.11 5/8 38+53 51R 30+YR Elev 2137.45
 BM#8 45+41 5/8 36 22 51R 30+YR Elev 2108.87
 BM#9 55+11 5/8 36+24 51R 18+YR Elev 2089.07
 BM#10A 51R 18+YR 42+11 5/8 32+20 Elev 2108.65

AUG 13 1980

BUEL'S GORE West Side
 Project # 2 (extension)
 Sheet 13 of 49