


FED. ROAD DIST. NO.	STATE	PROJ. NO.	FISCAL YEAR	SHEET NO.	TOTAL SHEETS
9	VT.				

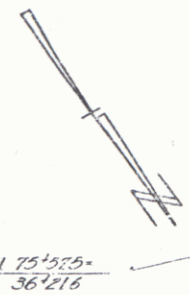

AUG 13 1980

BUEL'S GORE West Side

Surveyed by *Payor*  
 Designed by *Kelcham*  
 Drawn by *Kelcham*  
 Traced by *Kelcham*  
 Checked by *Series 37*  
 No. 2 (of 2) Filed  
 Sheet 15 of 20 Sheets