


DATE	8-13-80
BY	W. J. ...
CHECKED	...
SCALE	AS SHOWN
PROJECT	...
NO. OF SHEETS	...
SHEET NO.	...

DATE	8-13-80
BY	W. J. ...
CHECKED	...
SCALE	AS SHOWN
PROJECT	...
NO. OF SHEETS	...
SHEET NO.	...

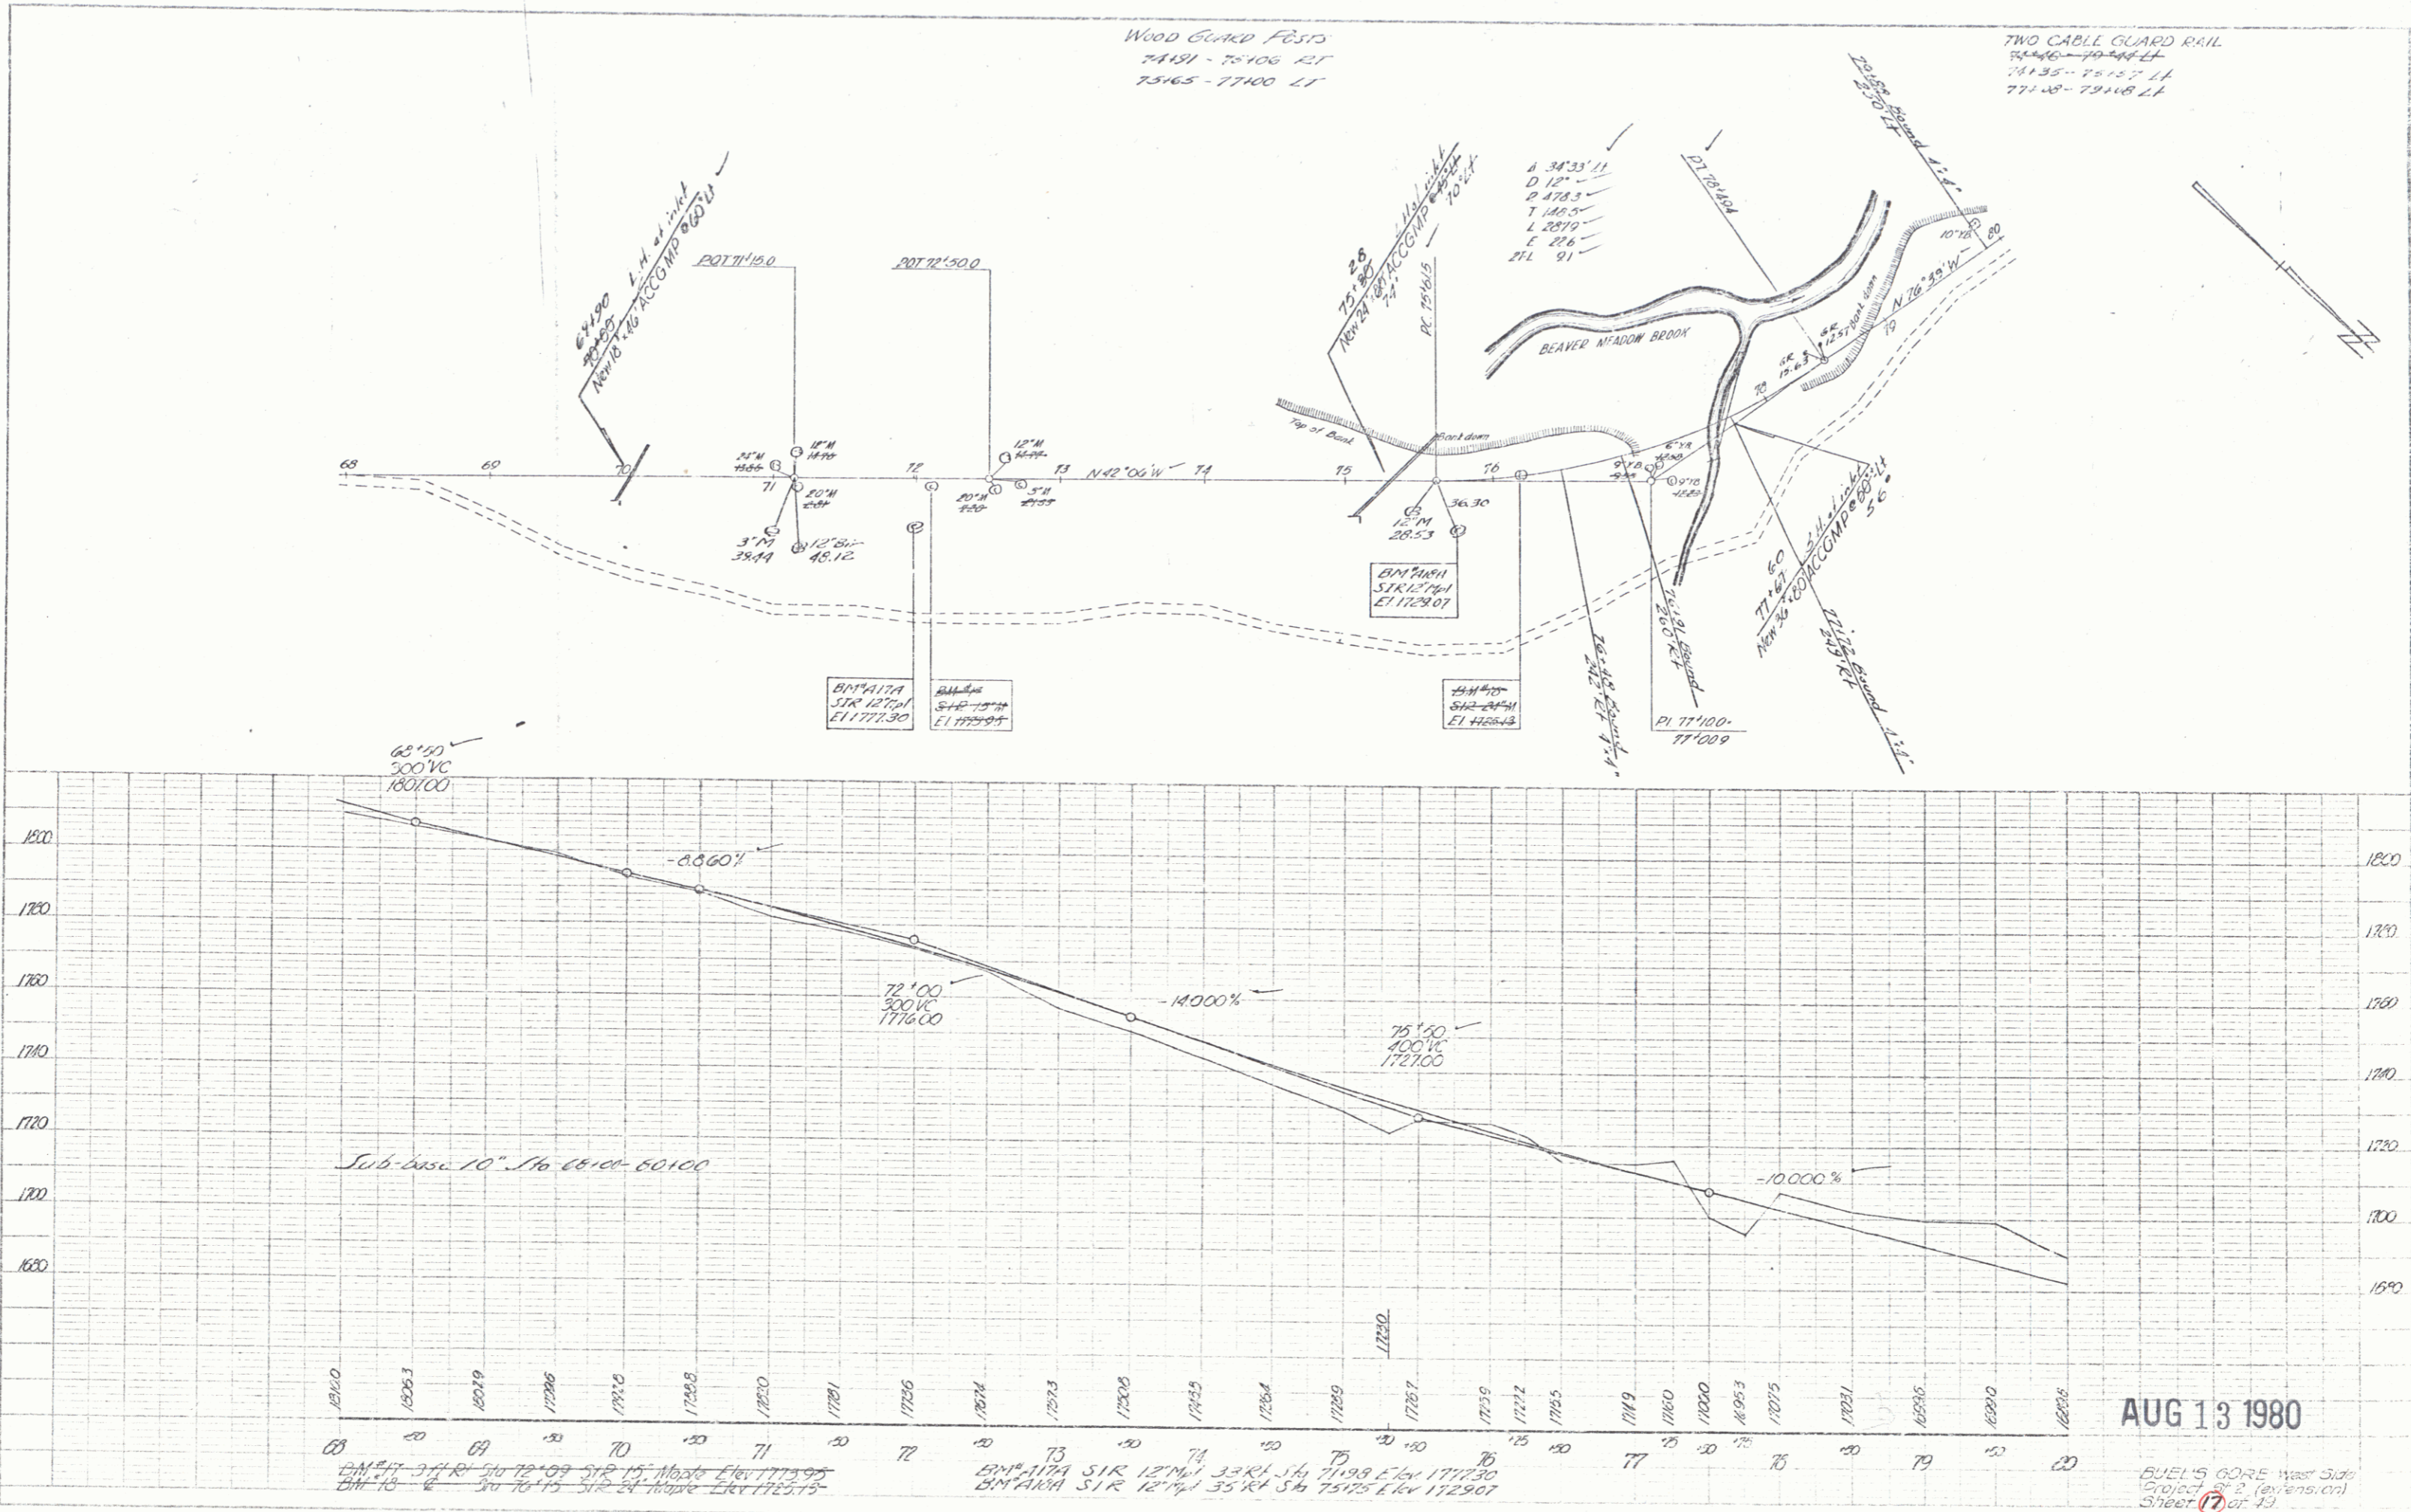

AUG 13 1980

BUEL'S GORE West Side  
Project 822 (revisions)  
Sheet 43