
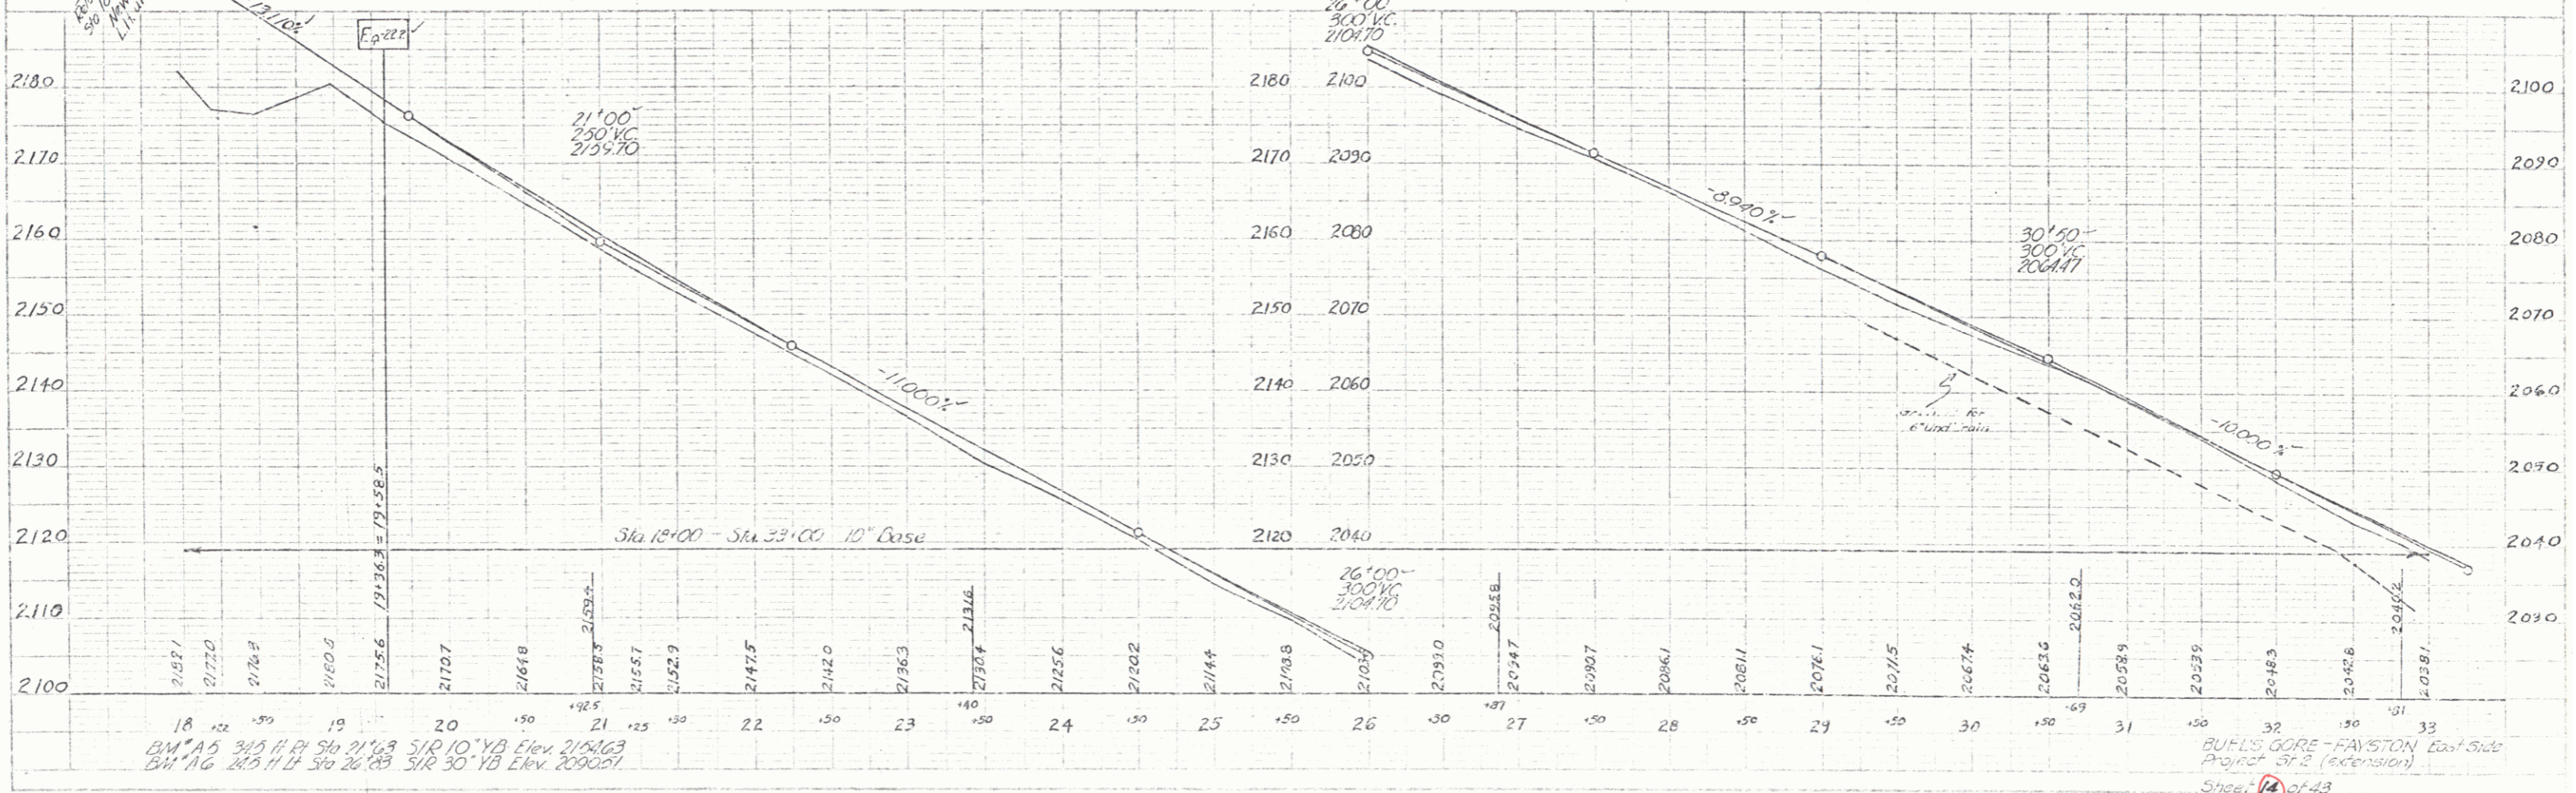


PLAN
 BY: B. J. BOSTER
 DATE: 12-89
 PROJECT: BULLS GORE - FAYSTON
 SHEET: 14 of 43

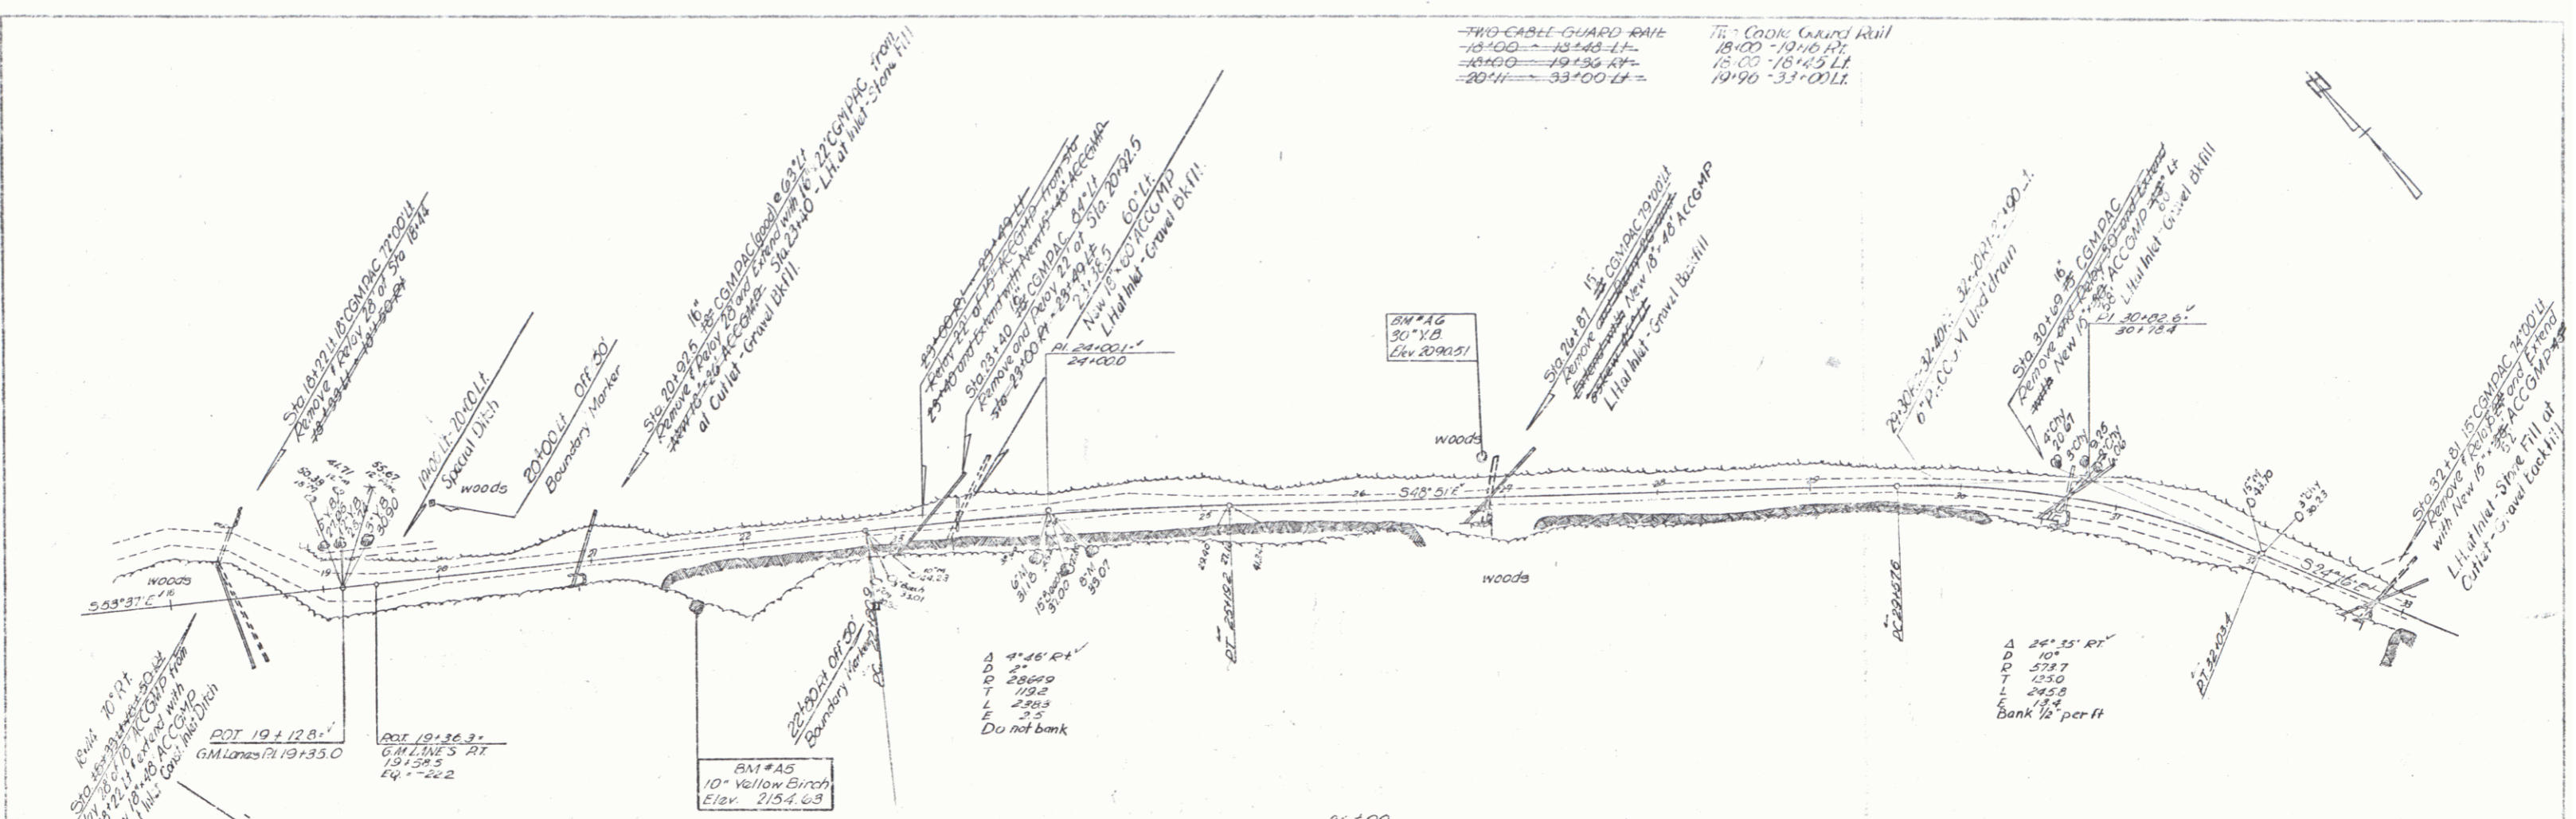

BM # A5 345 11 ft Sta 21+63 SIR 10' YB Elev. 2154.63
 BM # A6 245 11 ft Sta 26+83 SIR 30' YB Elev. 2090.51

BULLS GORE - FAYSTON East Side
 Project # 2 (extension)
 Sheet 14 of 43

AUG 18 1980

3