
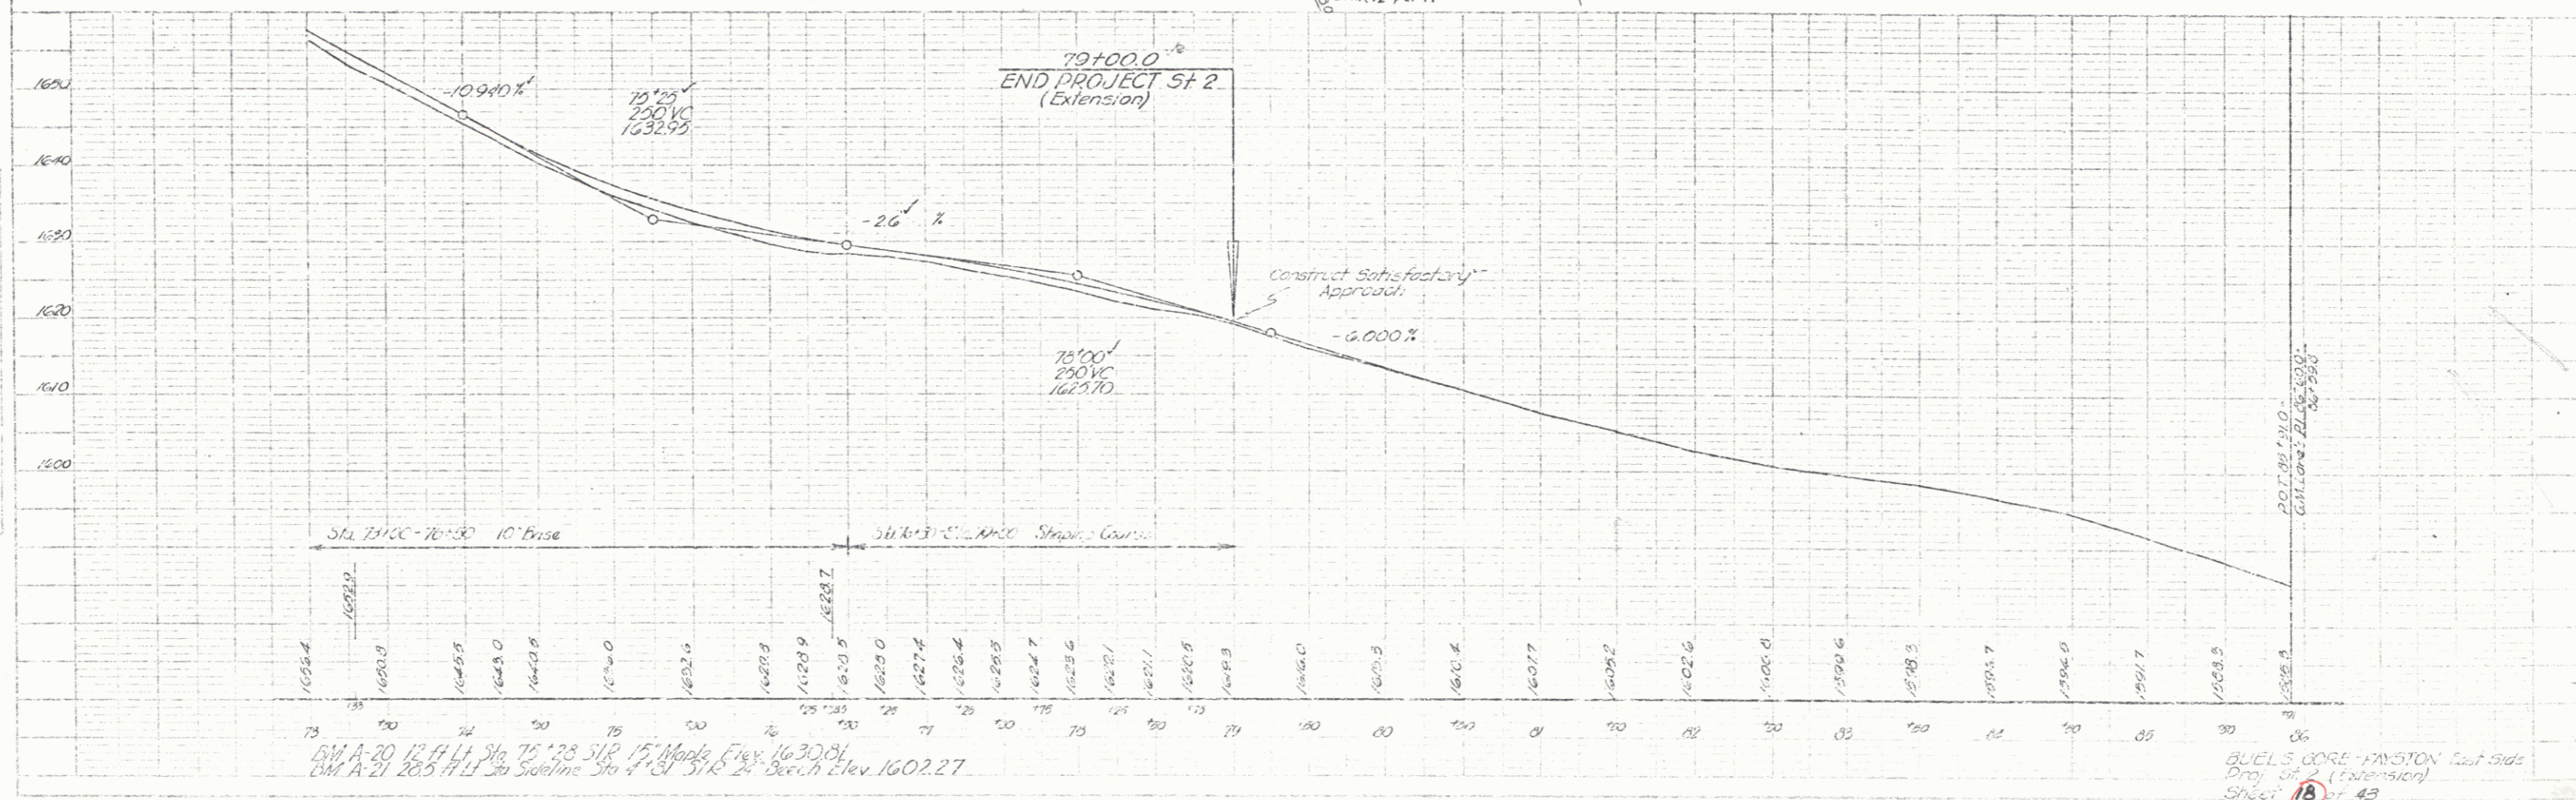


DATE	7-30
BY	W.H.C.
CHECKED	
SCALE	AS SHOWN
PROJECT	BUEL'S GORE - WINSTON East Side
NO. OF SHEETS	43
SHEET NO.	18

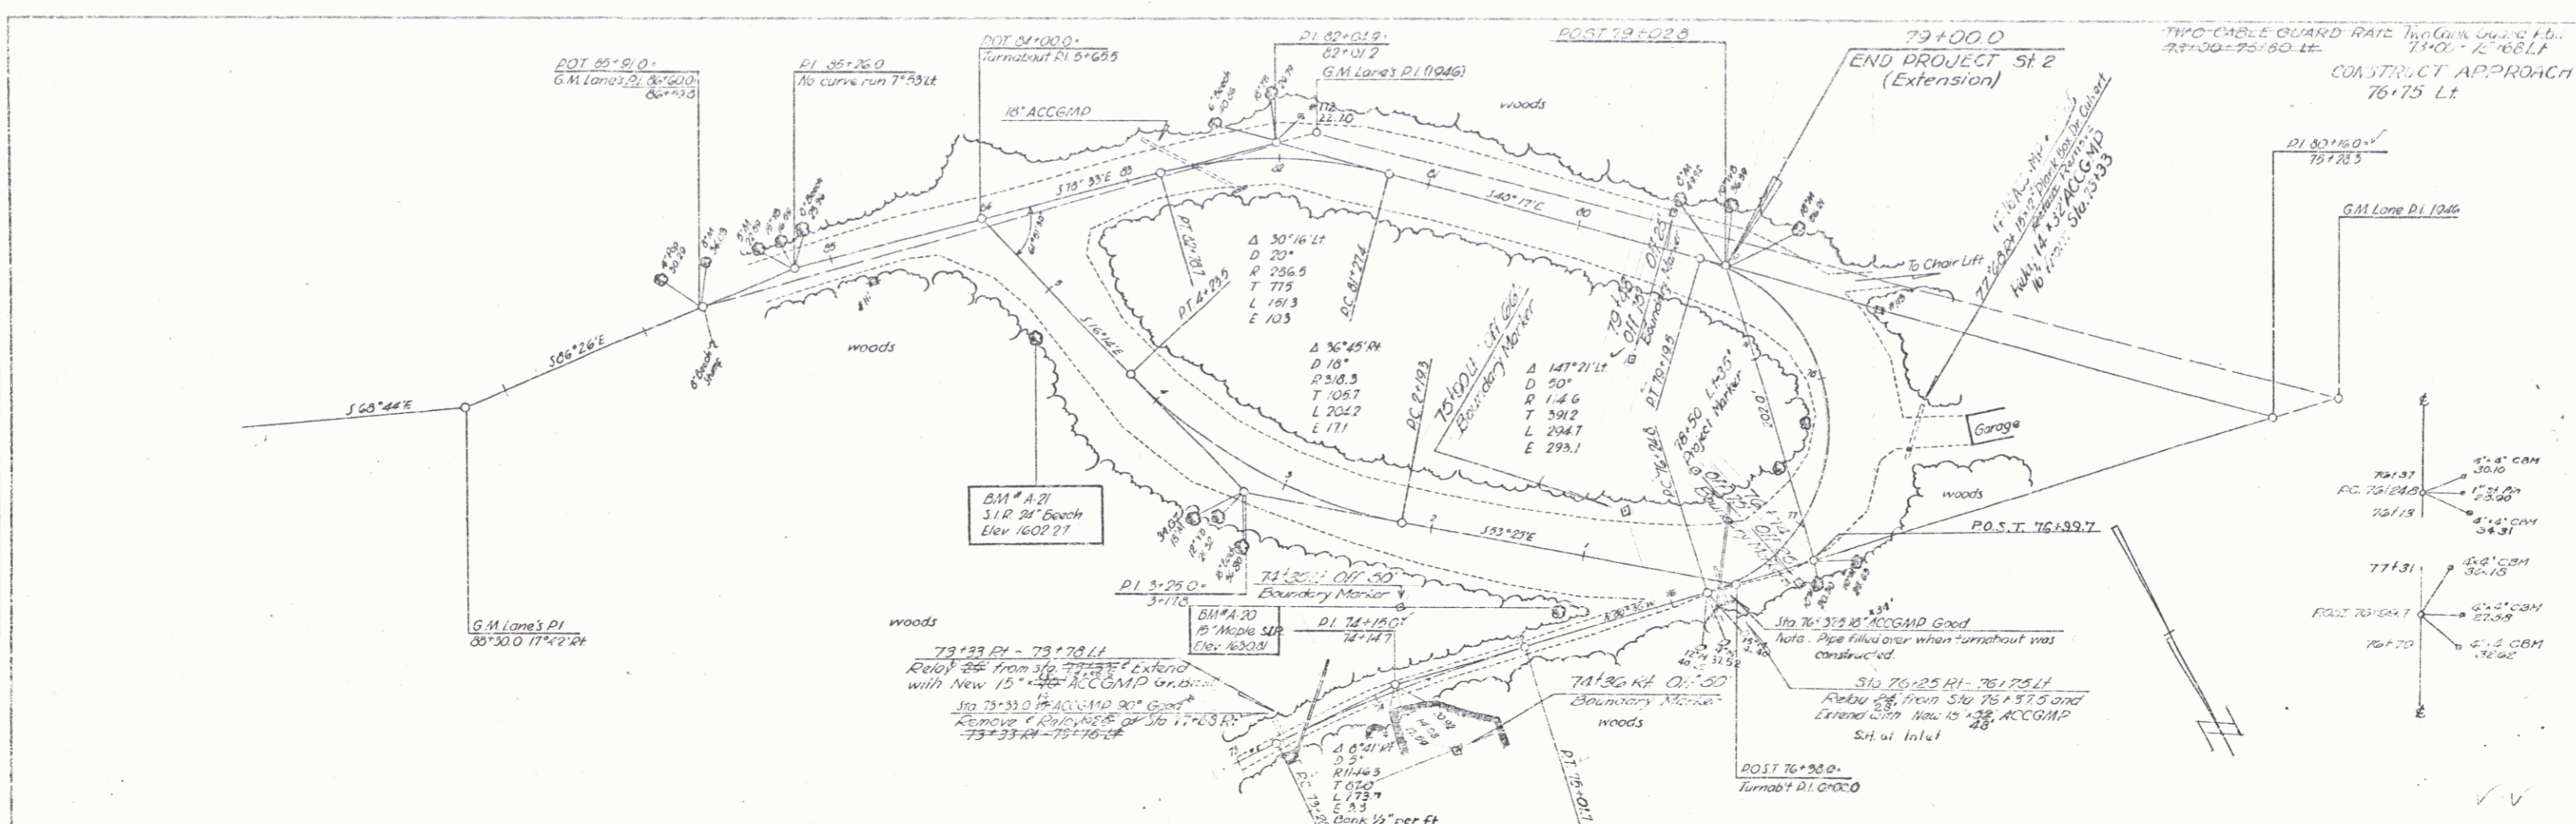

BM A-20 12' Ht. Sta 75+23 51R 15' Maple Elev. 1630.81  
 BM A-21 20.5' Ht. Sta 75+31 51R 24' Beech Elev. 1602.27

BUEL'S GORE - WINSTON East Side  
 Proj. St. 2 (Extension)  
 Sheet 18 of 43

AUG 18 1980

7