
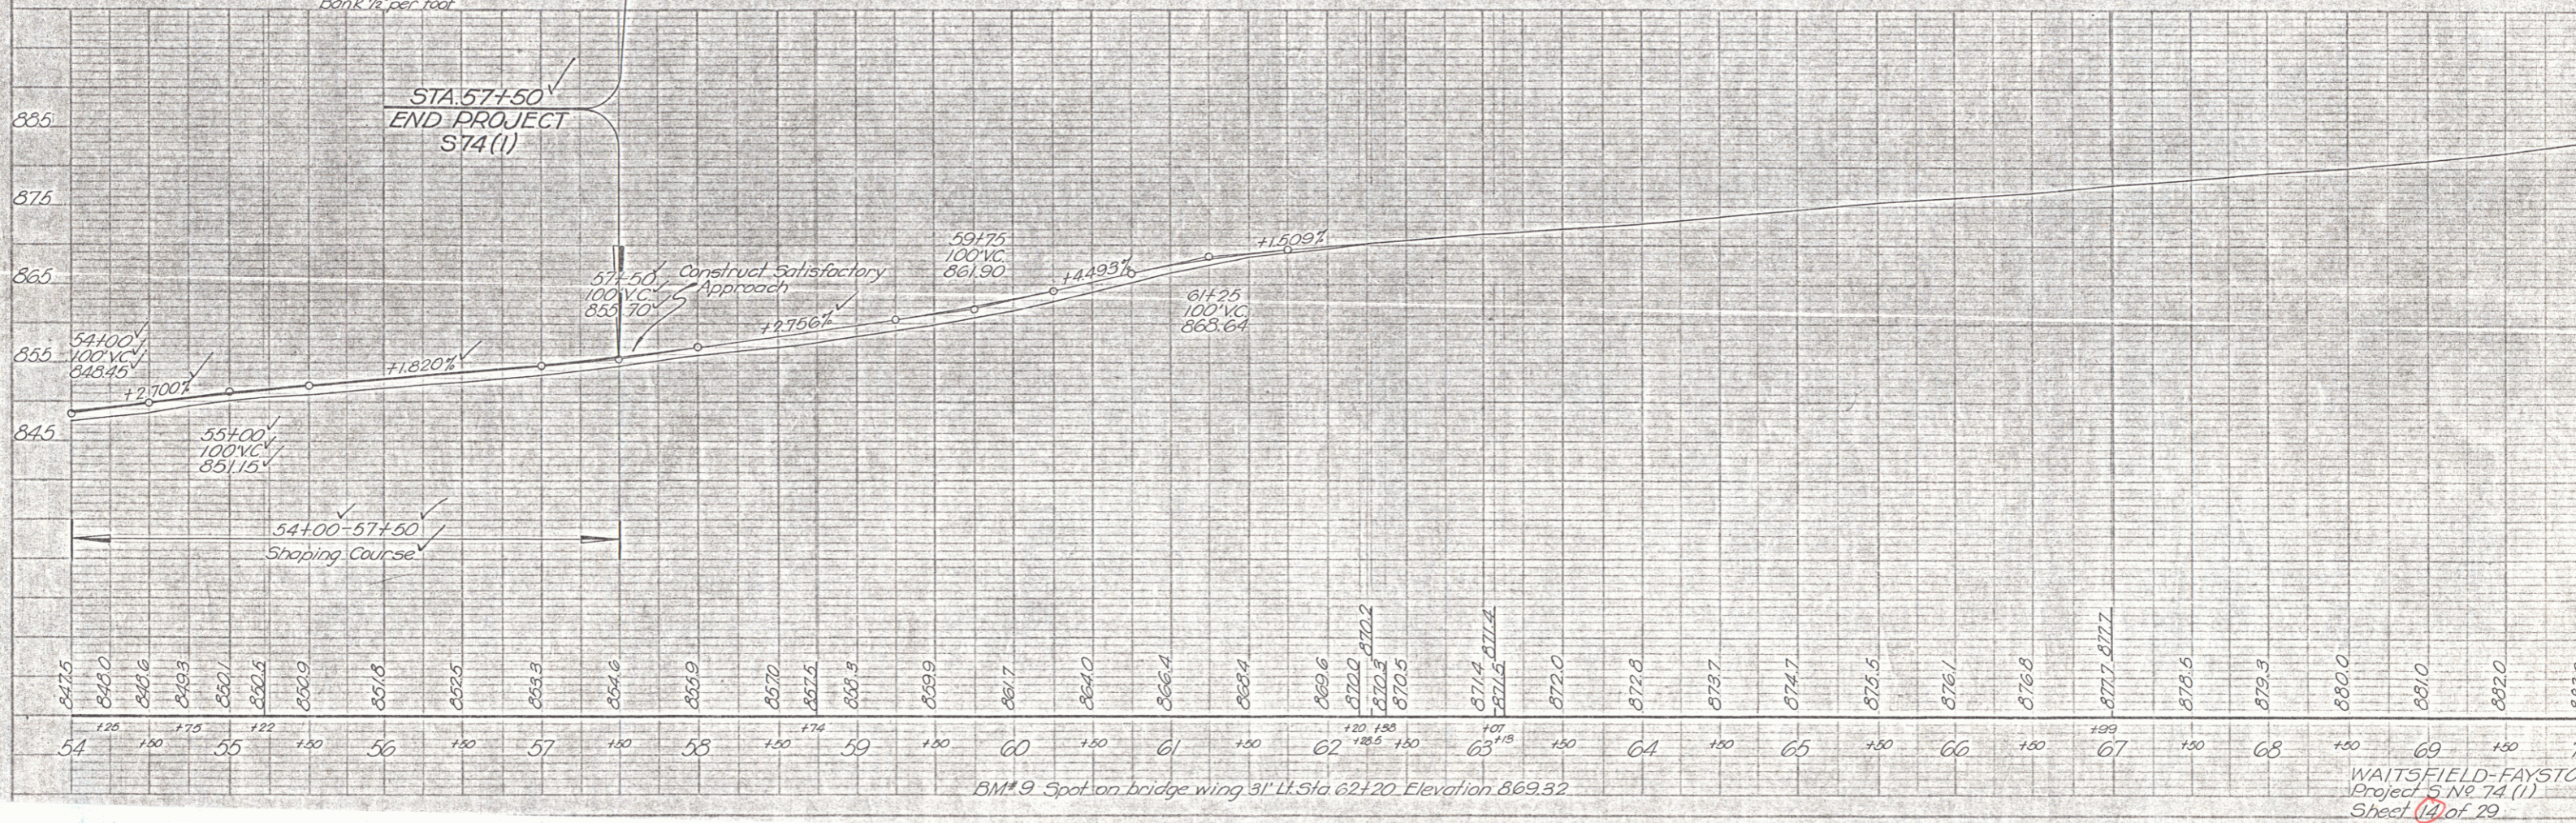


DATE: 5/16/07  
 DRAWN BY: J. HIDEY  
 CHECKED BY: J. HIDEY  
 PROJECT: 54100-57+50  
 SHEET: 10 of 29

DATE: 5/16/07  
 DRAWN BY: J. HIDEY  
 CHECKED BY: J. HIDEY  
 PROJECT: 54100-57+50  
 SHEET: 10 of 29

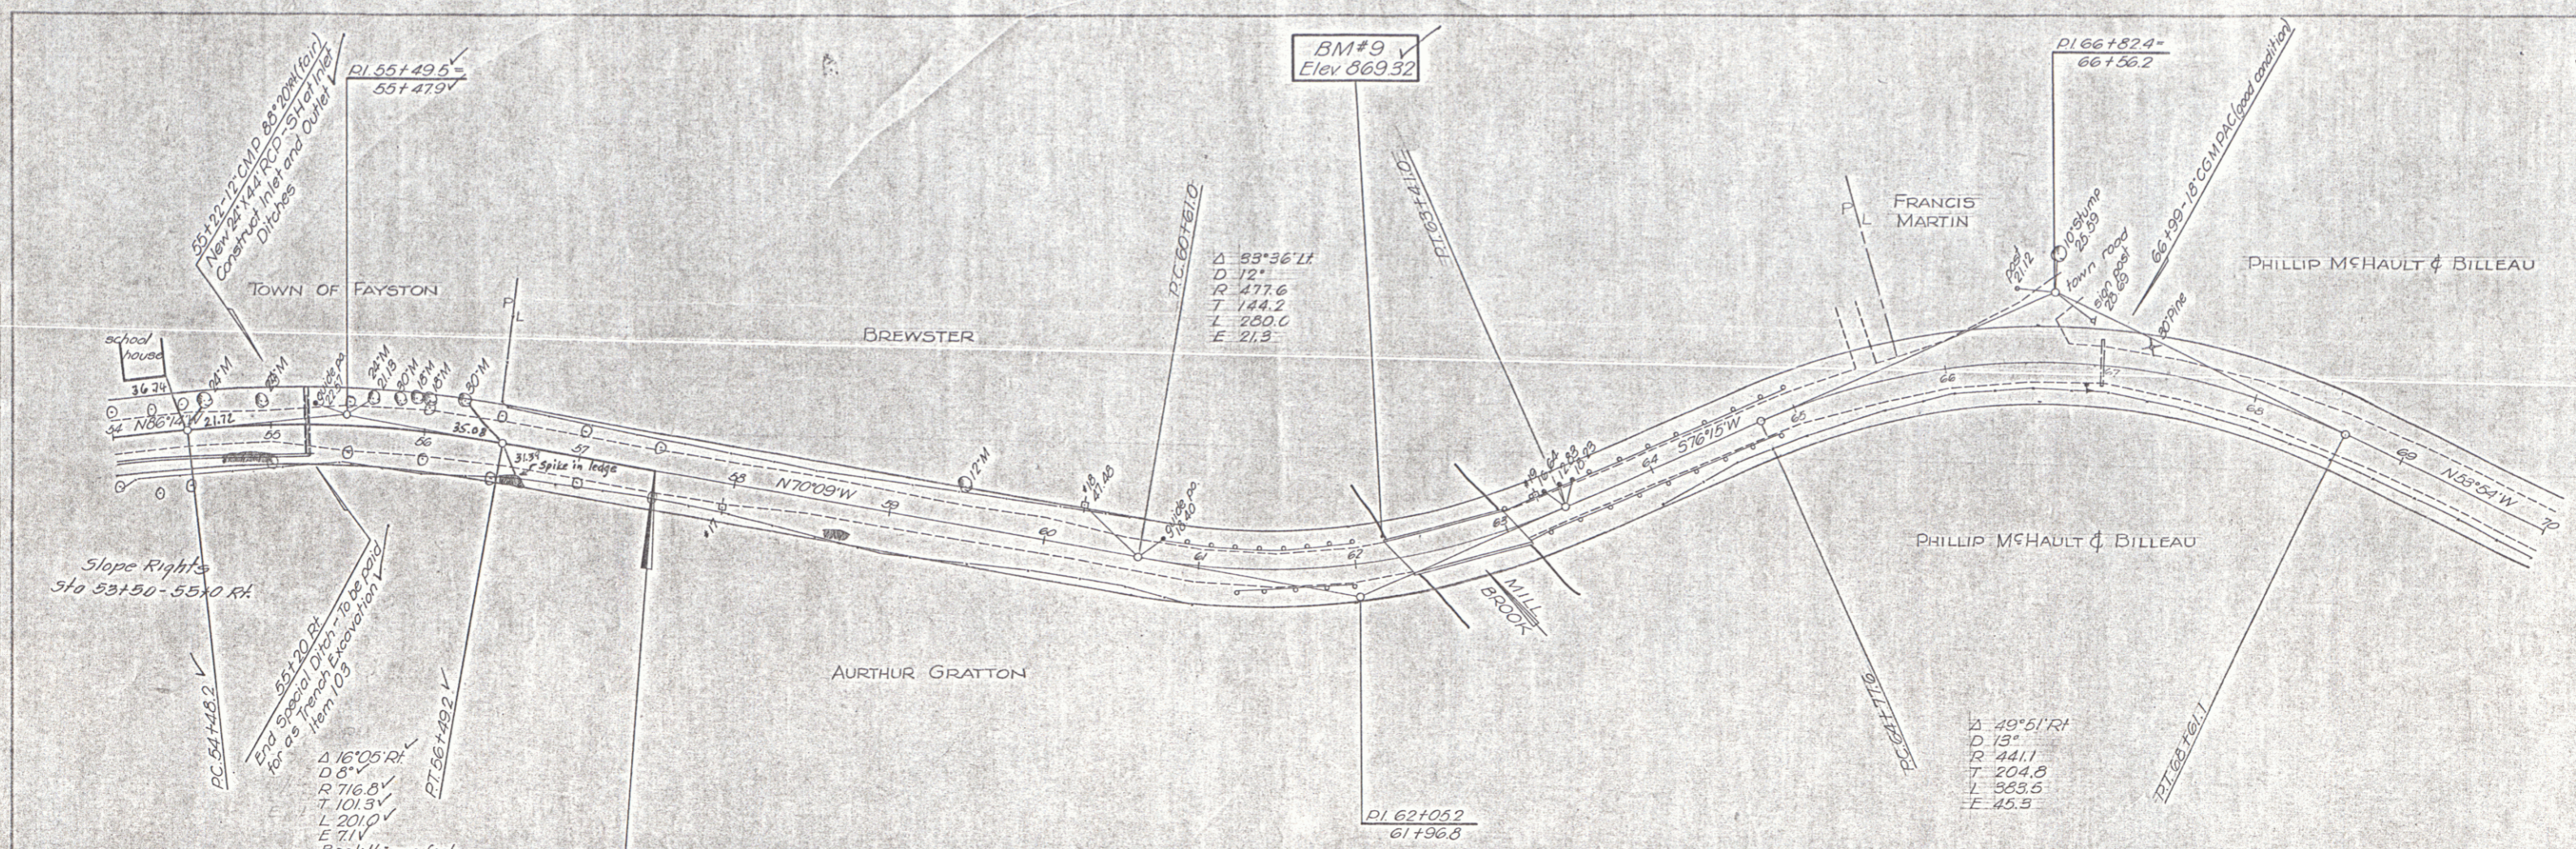

WAITSFIELD-FAYSTON  
 Project 5 No 74 (1)  
 Sheet 10 of 29