

INDEX OF SHEETS

SHEET NO. 1	TITLE PAGE
" 2	TYPICAL CROSS-SECTION OF IMPROVEMENT — GRADING, DRAINAGE, DISE & GUARD RAIL, WITH DOUBLE TRACK COAT OF REFINED TAR (ITEM-22)
" 3	BANKING AND WIDENING TABLES
" 4	PLAN AND PROFILE SHEETS
" 5	STANDARD STRUCTURE SHEET 3-30 GUARD RAIL
" 6	" " " 3-40 BARRICADES, SIGNS & LIGHTS
" 7	CROSS SECTION SHEETS

STANDARD STRUCTURE SHEETS APPROVED BY THE CHIEF ENGINEER, 3 30 AUGUST 15, 1933

FED. ROAD DIST. NO.	STATE	FED. AID PROJ. NO.	FISCAL YEAR	SHEET NO.	TOTAL SHEETS
9	Vt.	70-D	1936	1	7

CONTRACT-2


STATE OF VERMONT
STATE HIGHWAY DEPARTMENT

PLAN AND PROFILE OF PROPOSED
STATE HIGHWAY
FEDERAL AID PROJECT

TOWN OF WATERFORD

ST. JOHNSBURY VT. - LITTLETON N.H. ROAD


BEGINNING AT A POINT 1.188 MILES NORTHERLY OF THE INTERSTATE BRIDGE
PROJECT 263 AND EXTENDING SOUTHERLY 0.066 MILES
LENGTH OF PROJECT EXCL. BRIDGE 236 FT. = 0.044 MILES

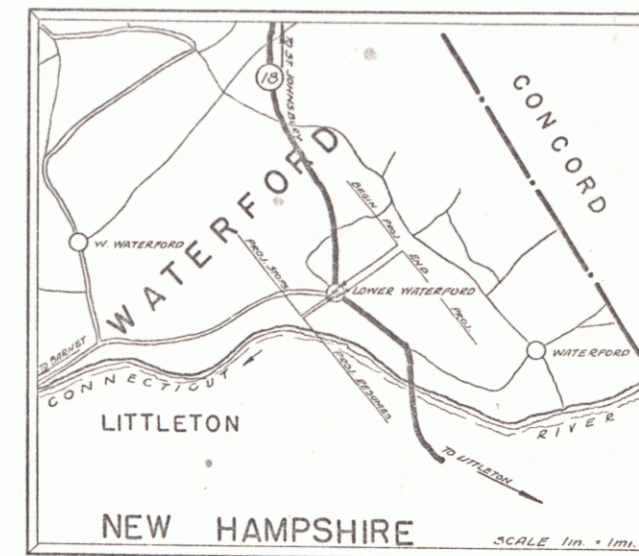

(To Be Returned To R.O.W. Division)
Town of Waterford
Perpetual
Town File
Highway-Map Division
MP 1.20
B 115

PROJECT: FAP 70-D
P.N.: 00R548
Route: VT 115

RECORD PLANS

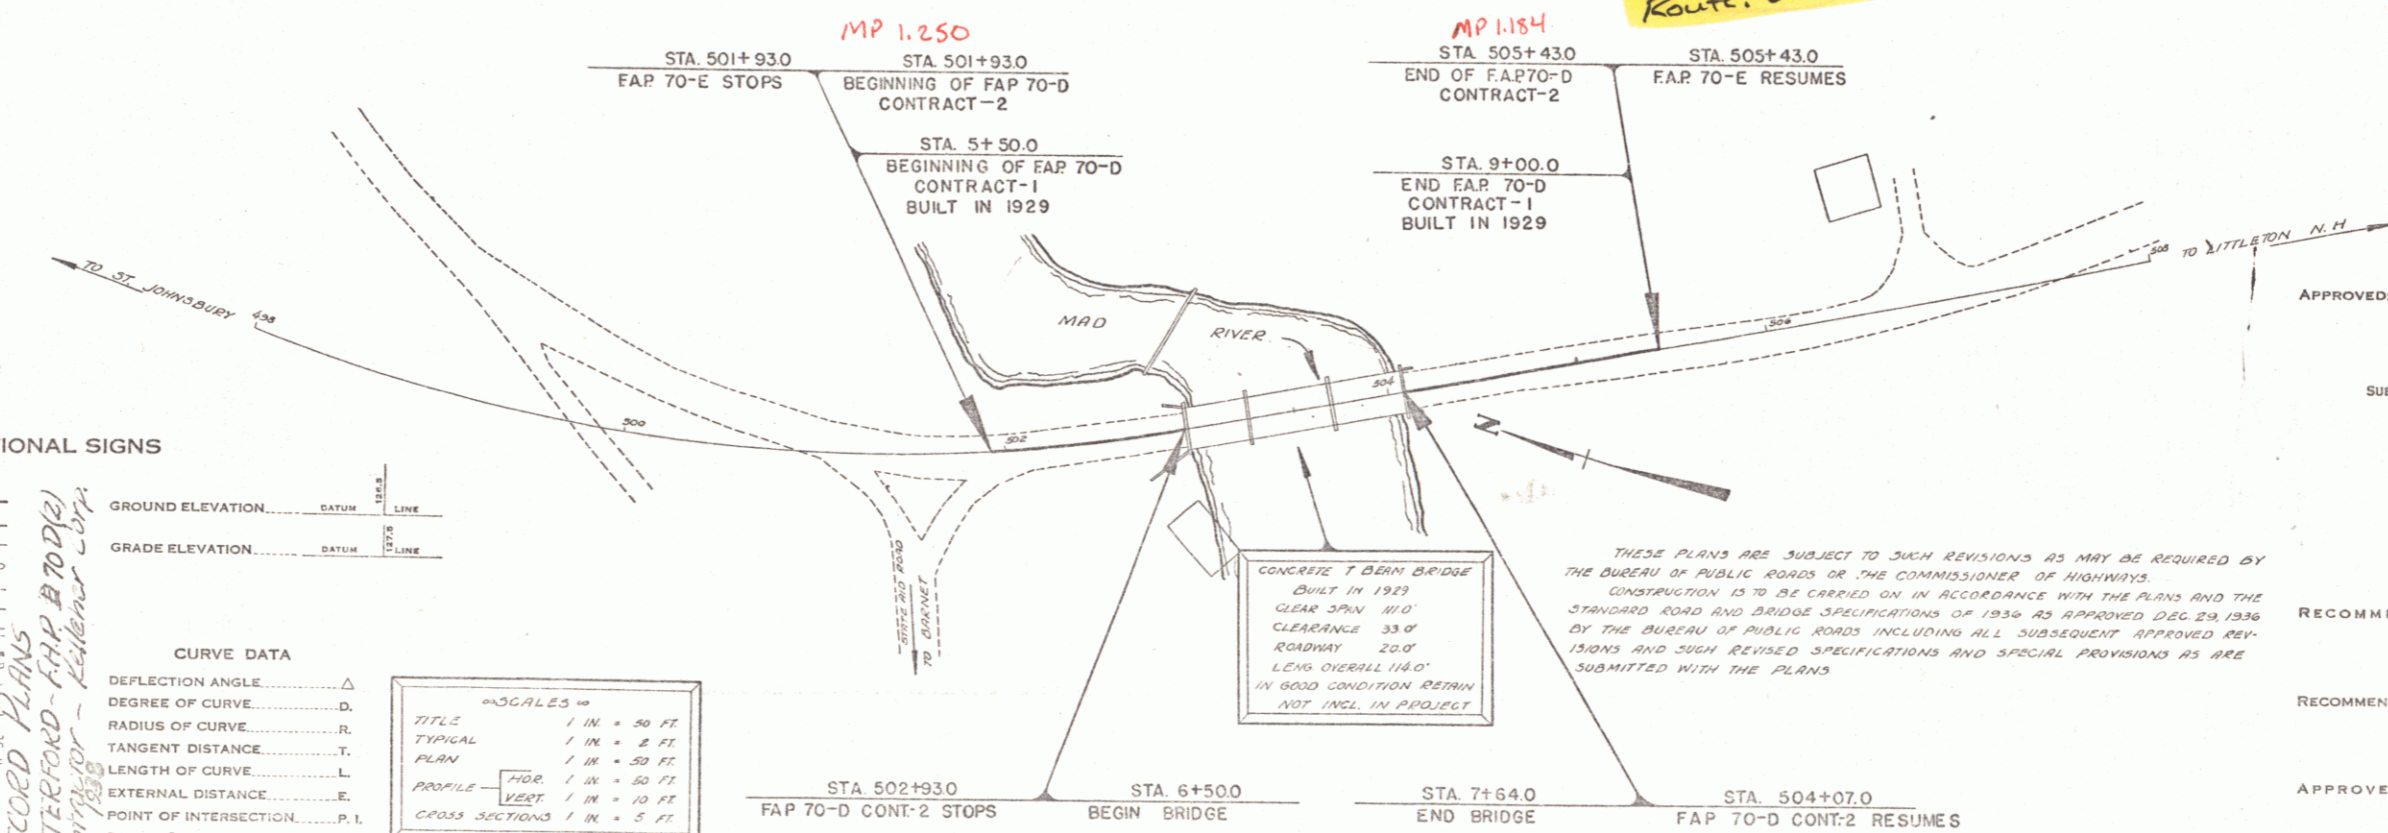

CONVENTIONAL SIGNS

COUNTY LINE	-----
TOWN LINE	-----
FENCE LINE	-----
STONE WALL	-----
UNFENCED PROPERTY	-----
GUARD RAIL	-----
TRAVELED WAY	-----
RAILROAD	-----
RETAINING WALL	-----
CENTER LINE	-----
SURVEY LINE	-----
CULVERT	-----
DROP INLET	-----
TROLLEY POLE	-----
POWER POLE	-----
TELEPHONE POLE	-----
TREES	-----
HEDGE	-----

GROUND ELEVATION — SATUM — LINE
GRADE ELEVATION — SATUM — LINE

CURVE DATA

DEFLECTION ANGLE	Δ
DEGREE OF CURVE	D
RADIUS OF CURVE	R
TANGENT DISTANCE	T
LENGTH OF CURVE	L
EXTERNAL DISTANCE	E
POINT OF INTERSECTION	P.I.
POINT OF CURVE	P.C.
POINT OF TANGENT	P.T.
POINT ON TANGENT	P.O.T.

SCALES

TITLE	1 IN. = 50 FT.
TYPICAL	1 IN. = 2 FT.
PLAN	1 IN. = 50 FT.
PROFILE — HOR.	1 IN. = 50 FT.
PROFILE — VERT.	1 IN. = 10 FT.
CROSS SECTIONS	1 IN. = 5 FT.

APPROVED: June 1, 1937
The Sargent
COMMISSIONER OF HIGHWAYS
SUBMITTED BY ORDER OF THE STATE HIGHWAY BOARD

RECOMMENDED
DISTRICT ENGINEER BUREAU OF PUBLIC ROADS
RECOMMENDED FOR APPROVAL
CHIEF ENGINEER BUREAU OF PUBLIC ROADS
APPROVED
DIRECTOR - BUREAU OF PUBLIC ROADS

THESE PLANS ARE SUBJECT TO SUCH REVISIONS AS MAY BE REQUIRED BY THE BUREAU OF PUBLIC ROADS OR THE COMMISSIONER OF HIGHWAYS. CONSTRUCTION IS TO BE CARRIED ON IN ACCORDANCE WITH THE PLANS AND THE STANDARD ROAD AND BRIDGE SPECIFICATIONS OF 1936 AS APPROVED DEC. 29, 1936 BY THE BUREAU OF PUBLIC ROADS INCLUDING ALL SUBSEQUENT APPROVED REVISIONS AND SUCH REVISED SPECIFICATIONS AND SPECIAL PROVISIONS AS ARE SUBMITTED WITH THE PLANS.

APPROVED: May 19, 1937
District Highway Commissioner
APPROVED: June 1, 1937
Road Engineer

SERIES FAP NO. 70-D FILED
CONTRACT-2
SHEET 1 OF 7

Dist # 7 1