


POOR ORIGINAL COPY

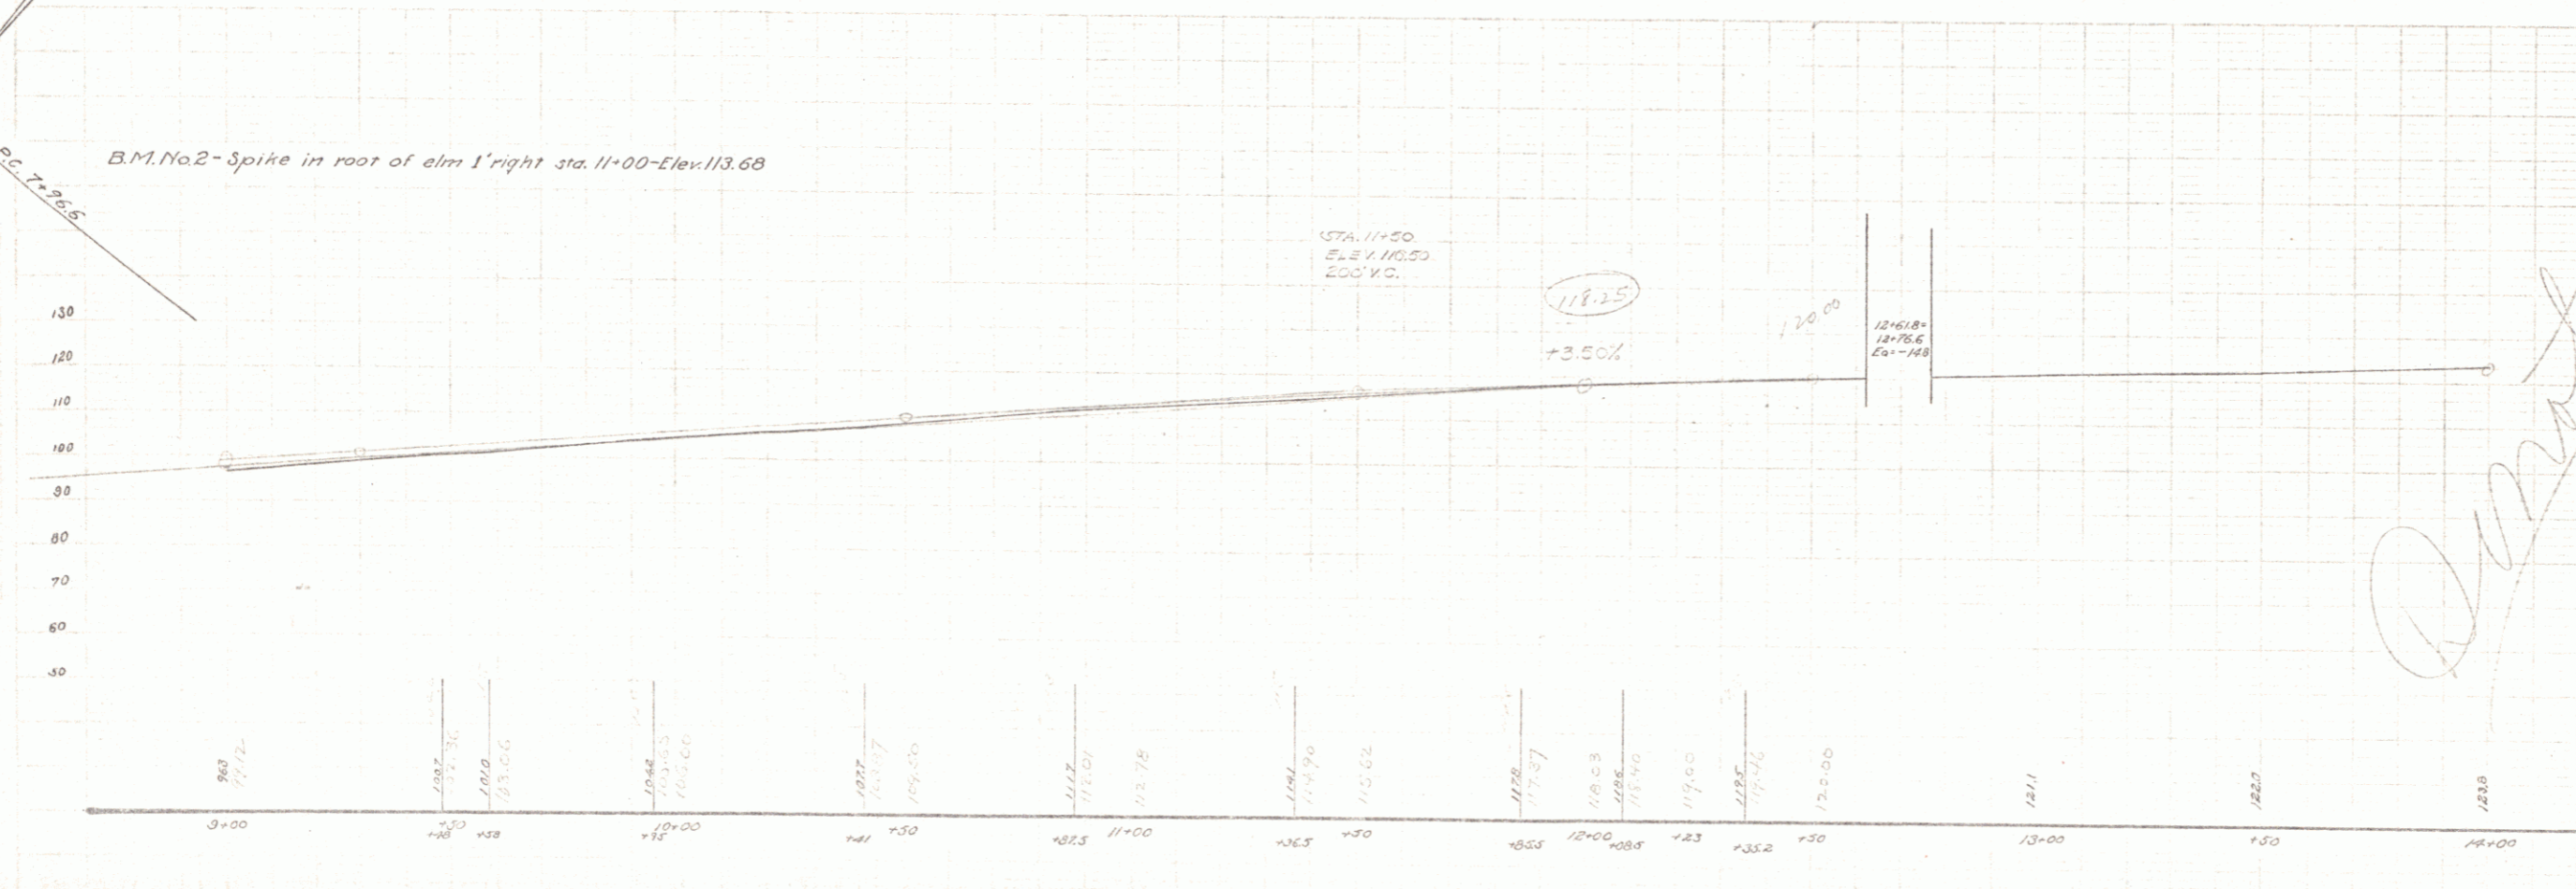

Handwritten signature

DISTRICT No 10
BRIDGE No 80-530
OVER
MAD BROOK
LOWER WATERFORD

SHEET 4