
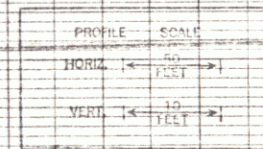
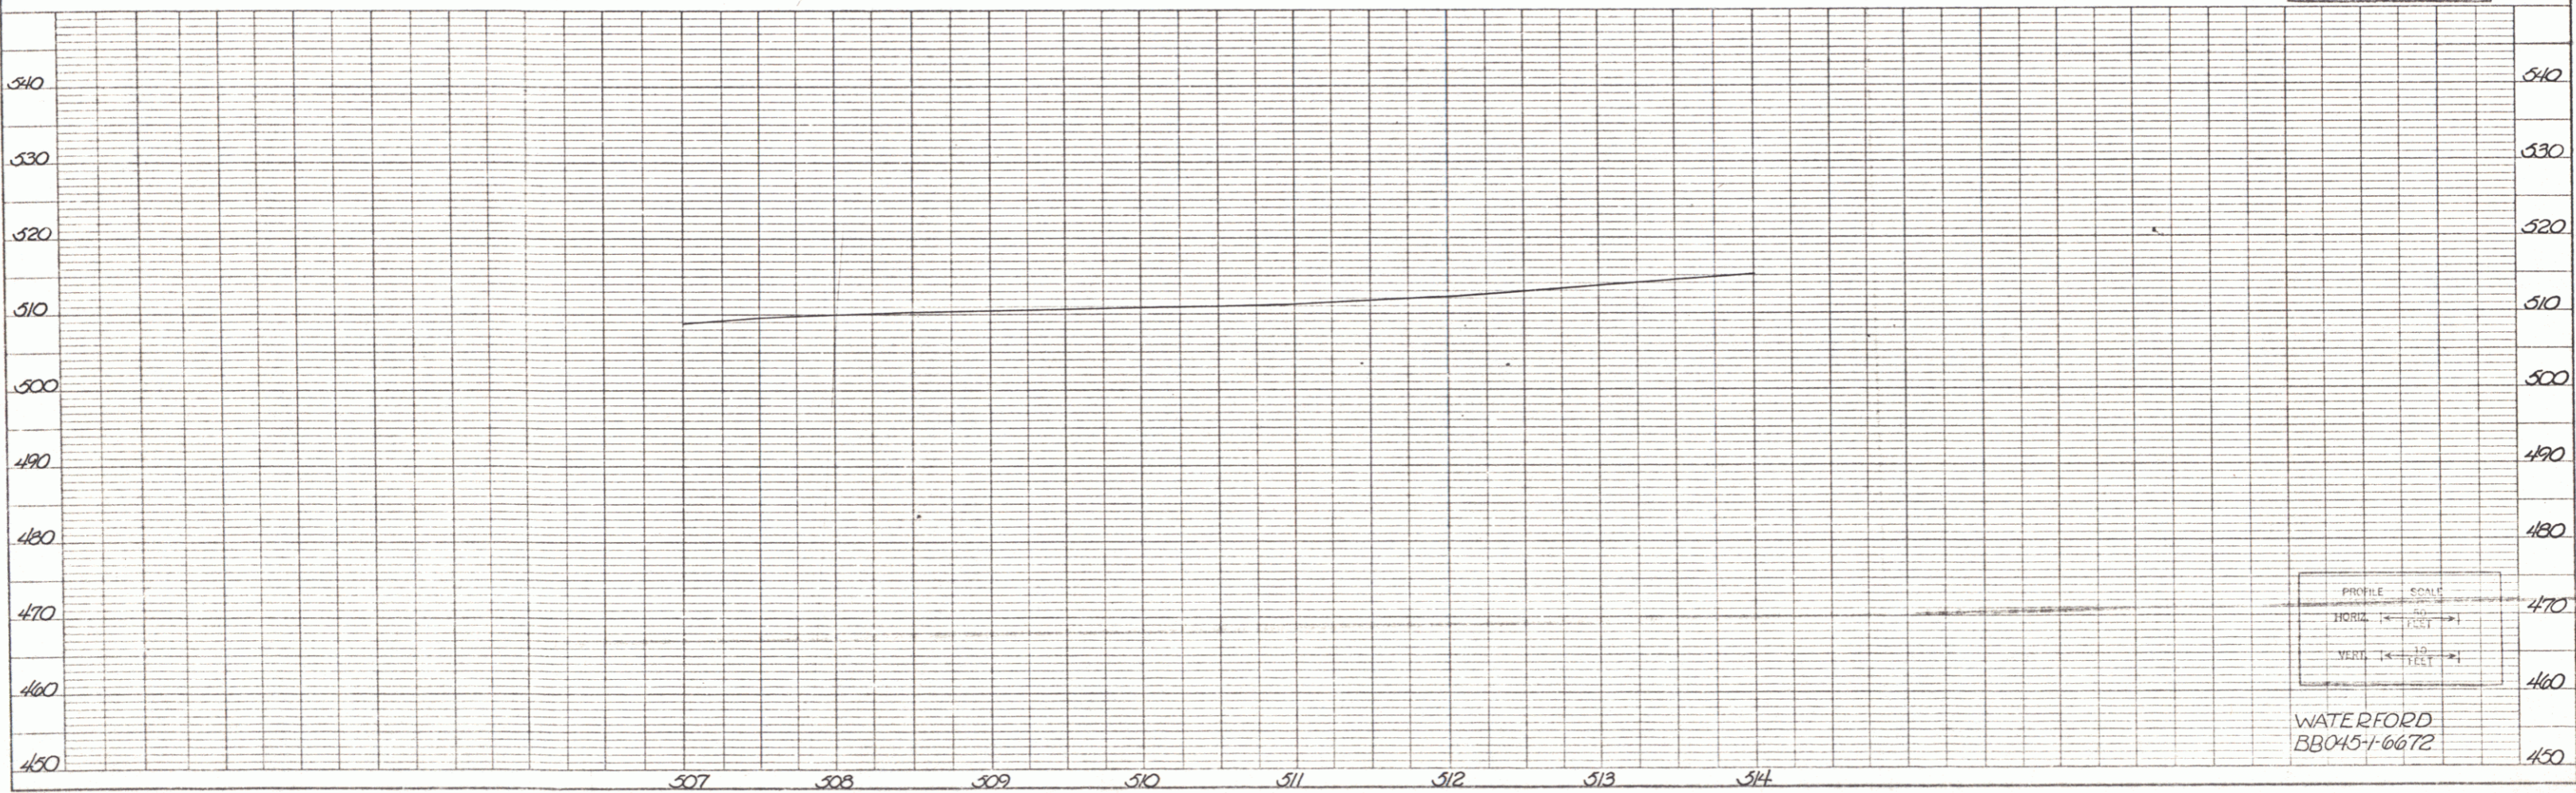


PLAN
 DATE: 9/16/10
 DRAWN BY: [Signature]
 CHECKED BY: [Signature]
 PROJECT: [Signature]
 SHEET NO.: [Signature]

PROFILE
 DATE: 9/16/10
 DRAWN BY: [Signature]
 CHECKED BY: [Signature]
 PROJECT: [Signature]
 SHEET NO.: [Signature]

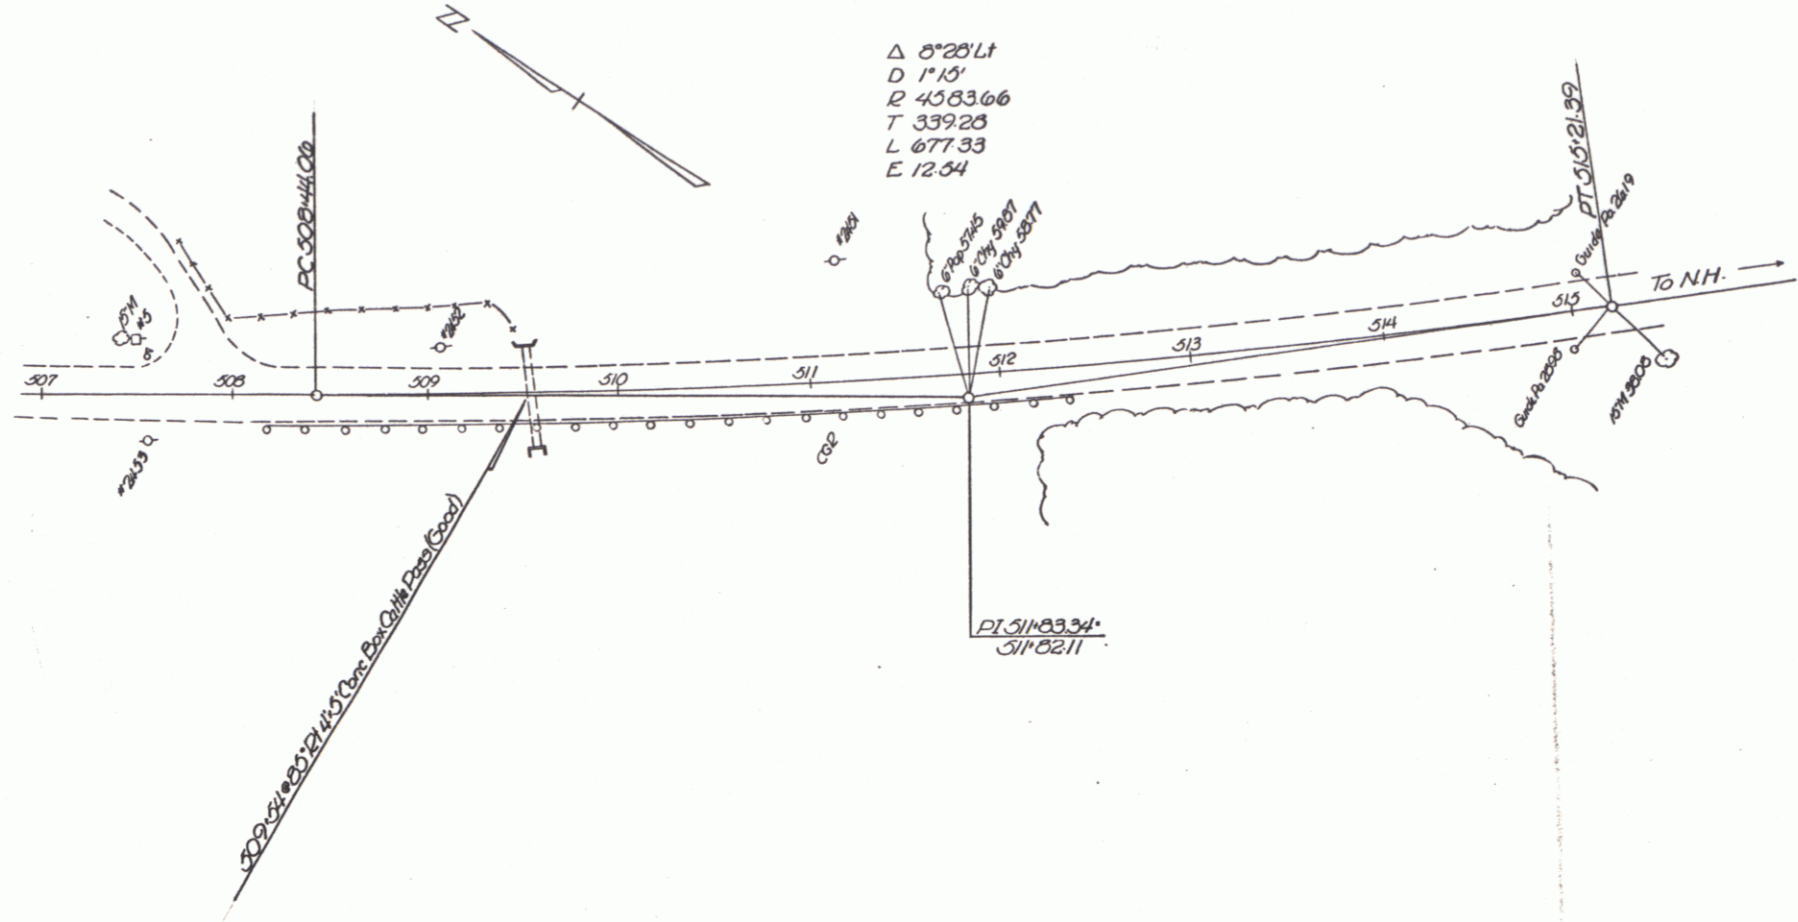

WATERFORD
 BB045-1-0672