


KIDDER

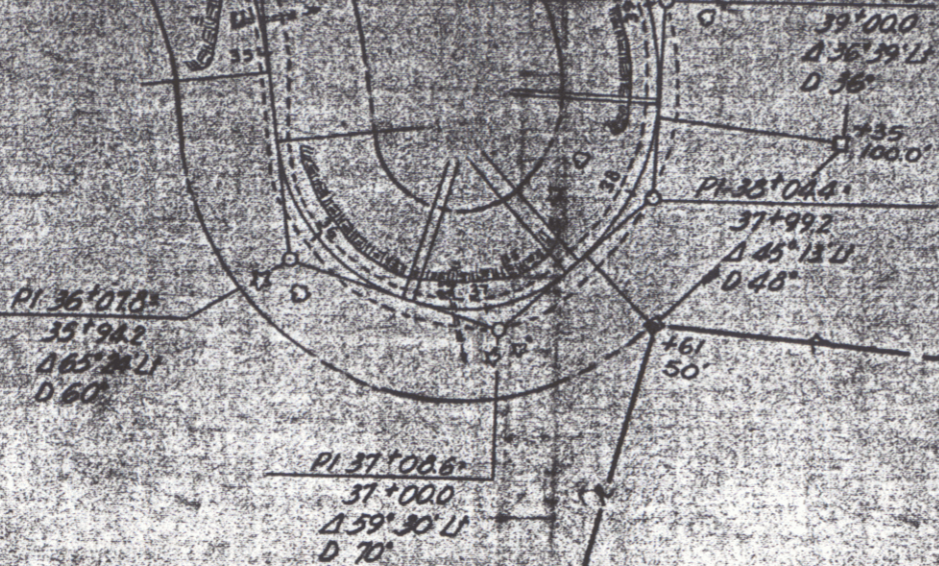

BAIRD LOT

PIERCE LOT

$P1.00^{\circ}609'$
 $75^{\circ}53.3'$
 $1^{\circ}10.1'$
 $D.50'$

SHEET 34

34