


PARCEL	INSTRUMENT	DATE	GRANTOR	GRANTEE	RECORDED	REMARKS
10800	B.C.O.	7-15-37	ROSARIO MARIANO	ST. JOHNSBURY	BANK	AGE DATE
			CITIZENS SAVINGS BANK	ST. JOHNSBURY	77	203-4 7-29-37 STA 160+00

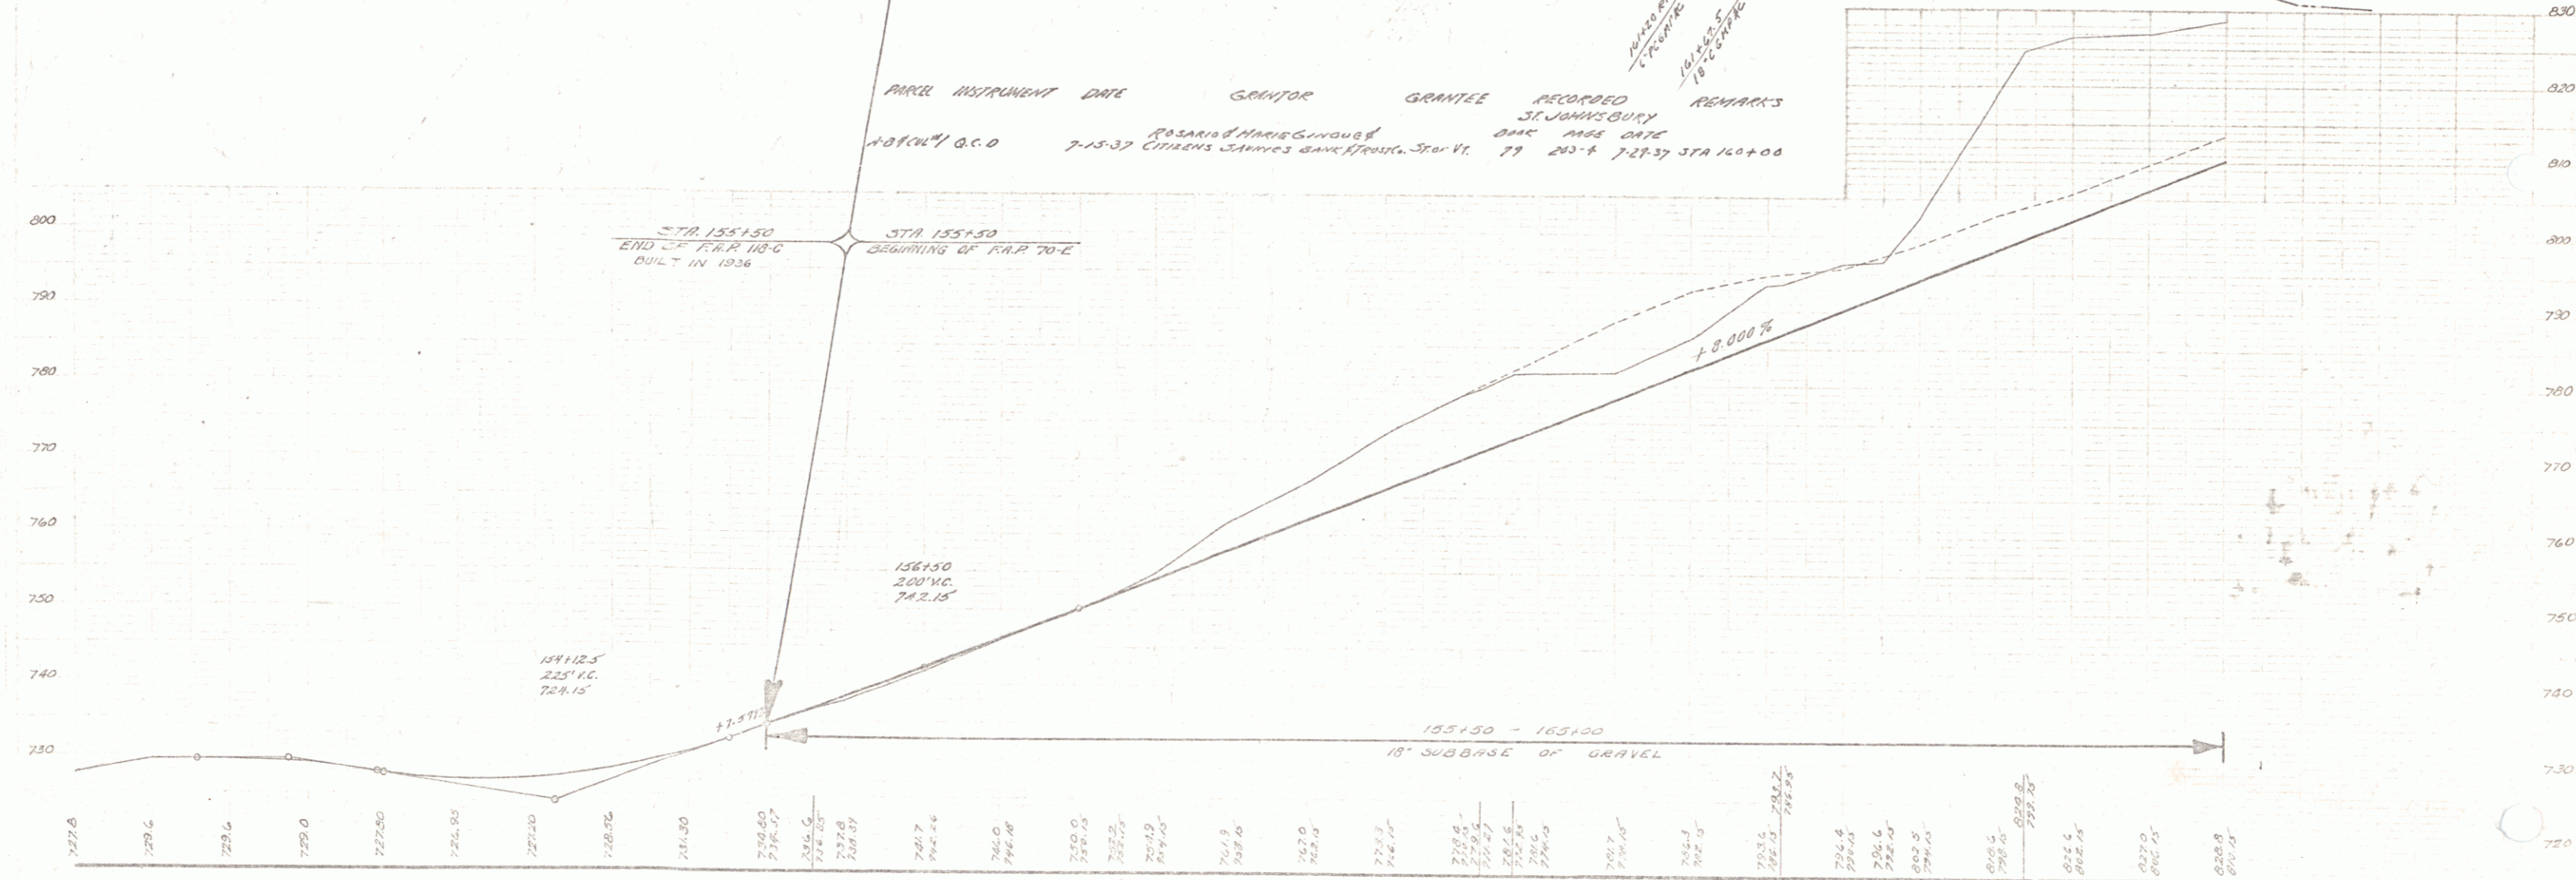

151 BM 19 Spot on S.W. Corner Post on Bridge Sta 151+50 EL. 732.69  
 BM 18 Spike in Trunk of 18" Elm 15' W. Sta 161+39 EL. 708.58