


PARCEL INSTRUMENT DATE	CONTR.	CONTR.	RECORDED	REMARKS
AS 8 CUL. #1	Q.C.D	7-15-37	ROZARIO GINGUE & GREEN'S SPRING OR STRUST Co. ST. 11	283-4 7-29-37 STA. 160+00

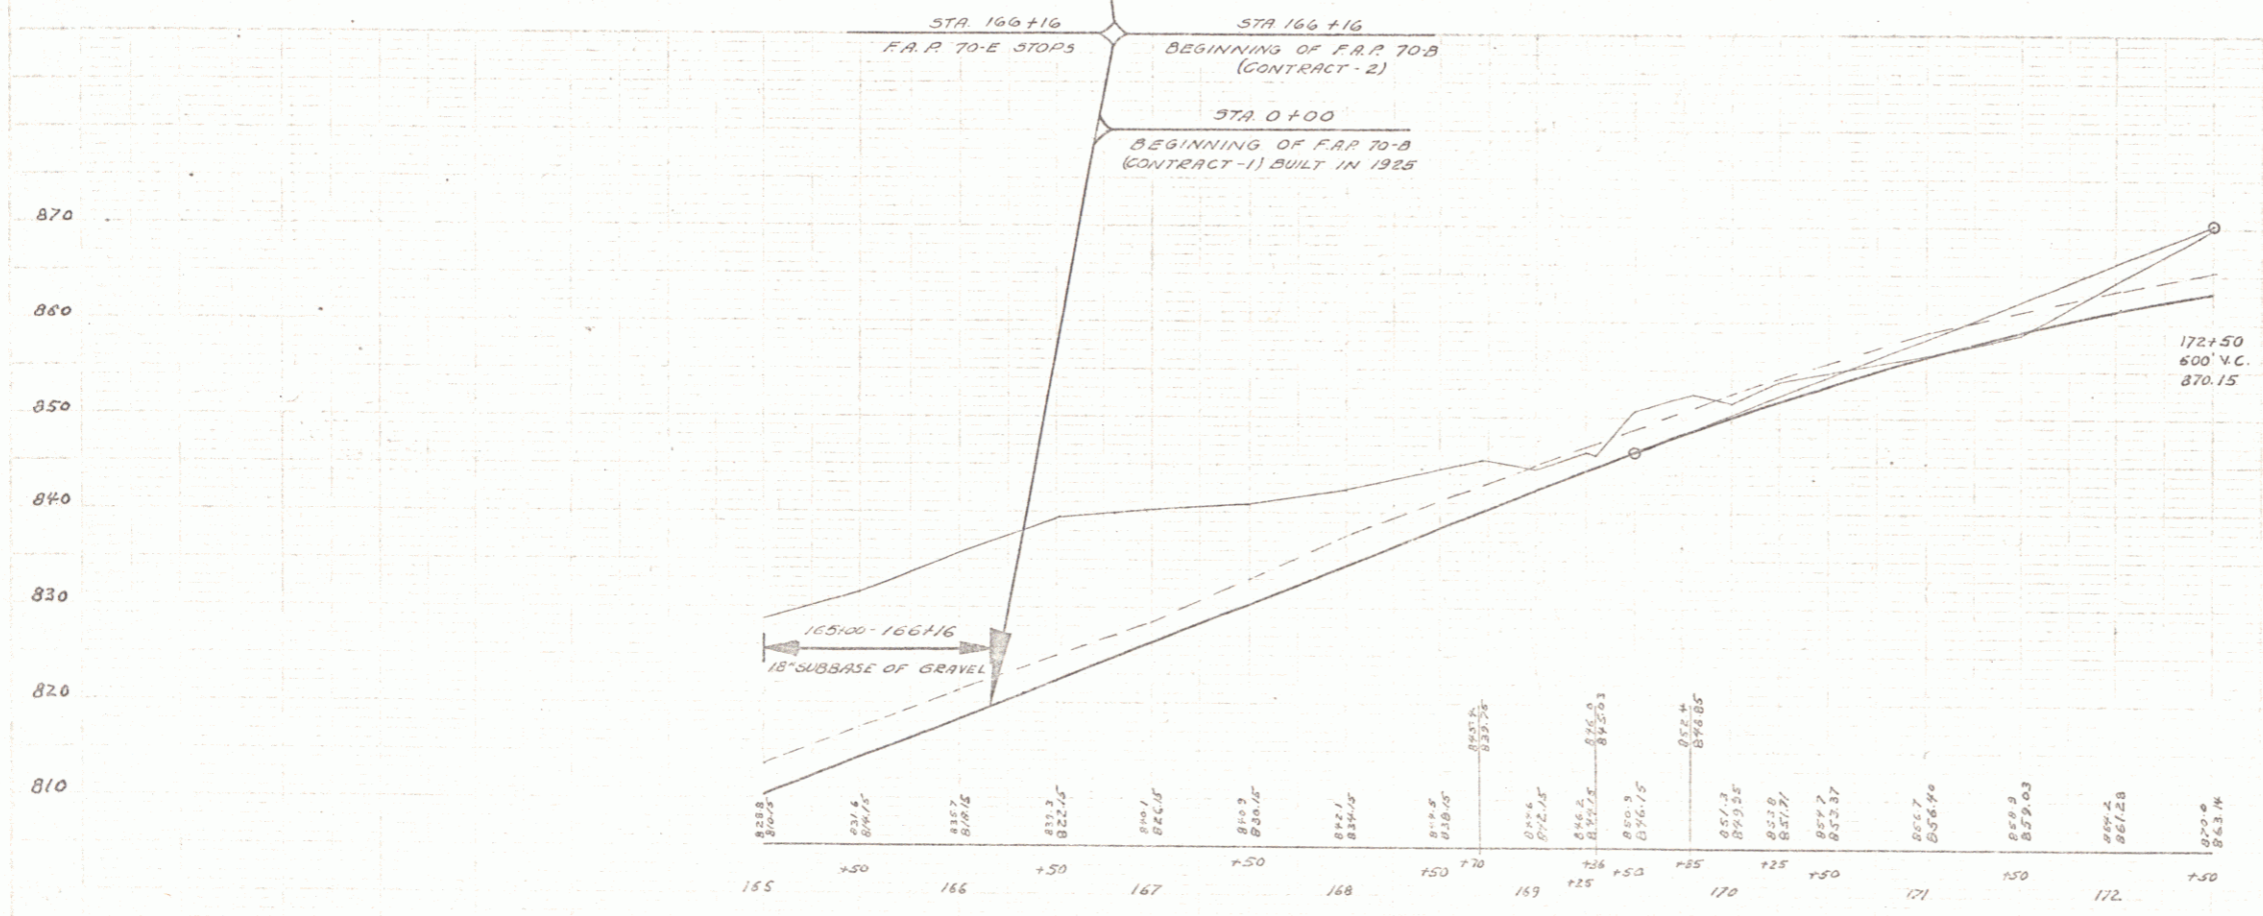

B.M. #15 SPIKE IN TRUNK OF 18" WHITE BIRCH 104 FT. RT. OF STA 166+32 ELEV. 823.10
 B.M. #16 SPIKE IN ROOT OF 18" ELM 43 FT. LT. OF STA 171+15 ELEV. 860.30