





BENTLEY
 M.S. DONALD
 CIVIL
 ENGINEER
 11/14
 2/17
 1937

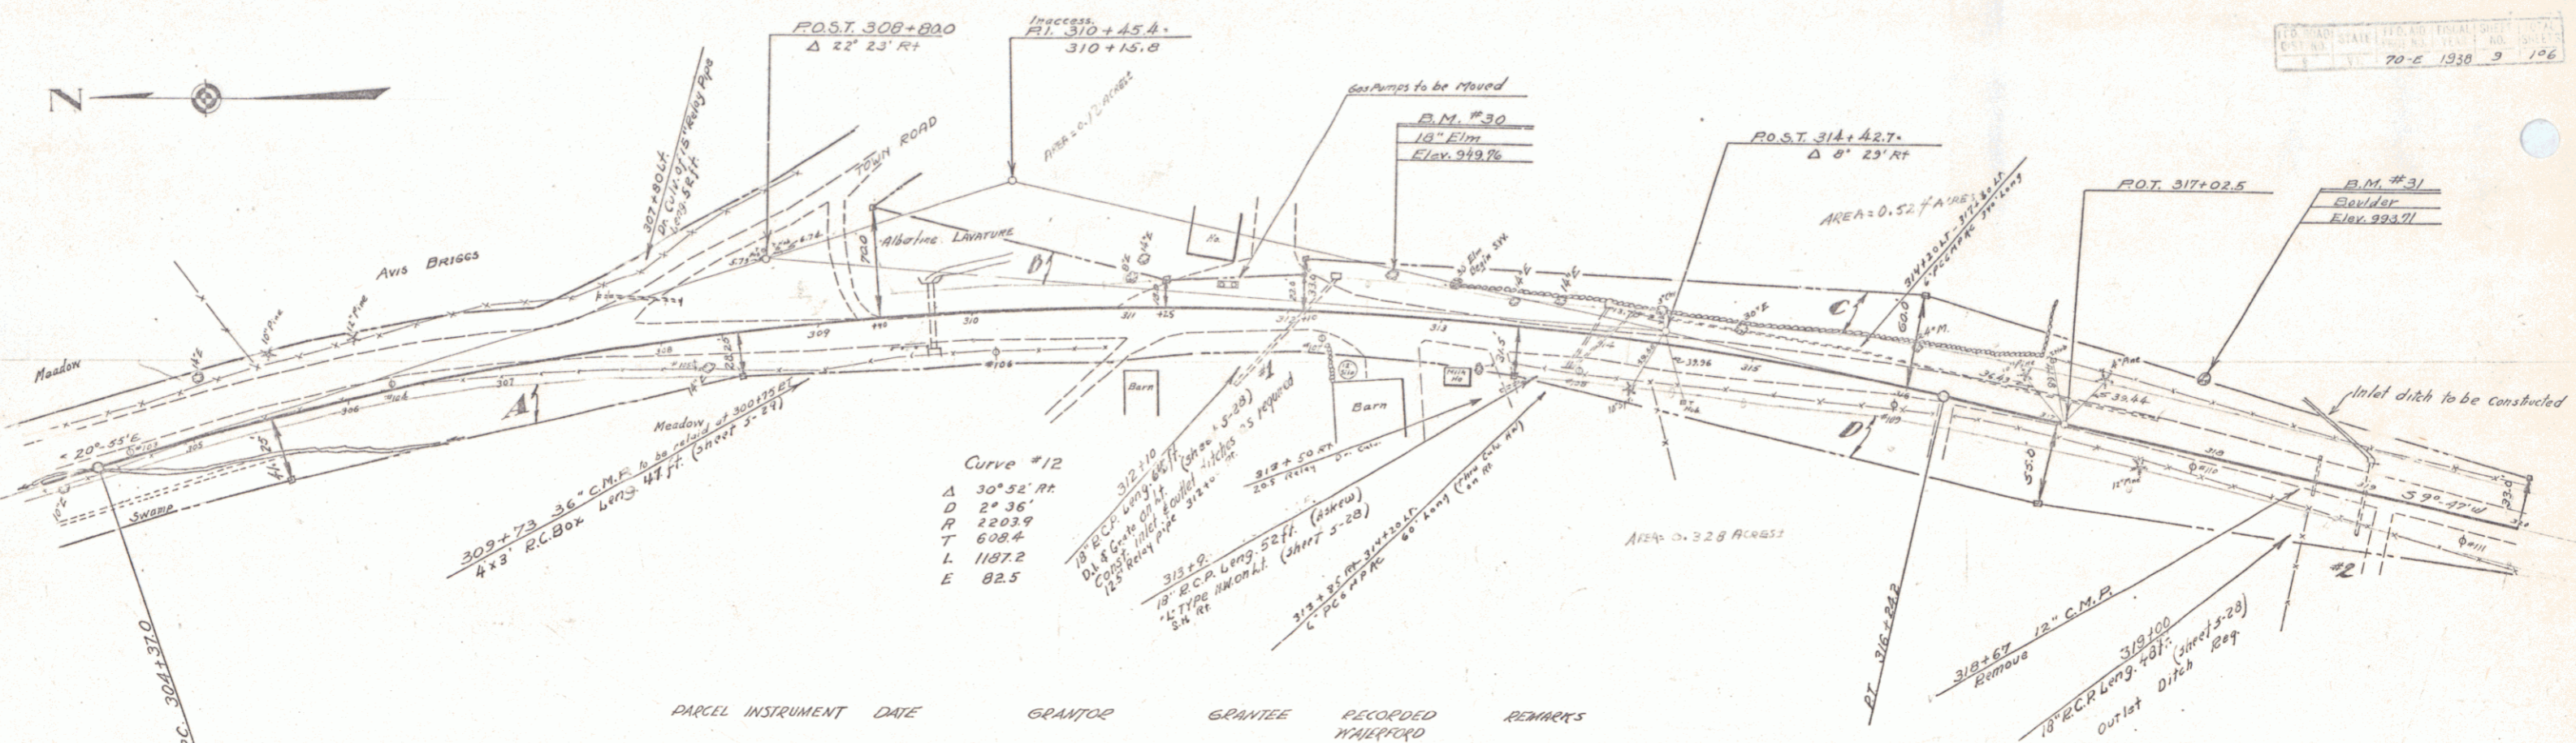

PARCEL	INSTRUMENT	DATE	GRANTOR	GRANTEE	RECORDED	REMARKS
A.B.C.D.	ADMINISTRATIVE	8-12-37	FRANK LAVATURE ESTATE	510 YK	BOOK PAGE DATE CUL STA.	
"	G.C.D.	8-14-37	CITIZENS SAVINGS BANK	"	25 1812-3 8-20-37 70-3310, 20235017 90-322100	
"	"	"	MORTGAGEE	"	25 183-4-5 8-20-37	"

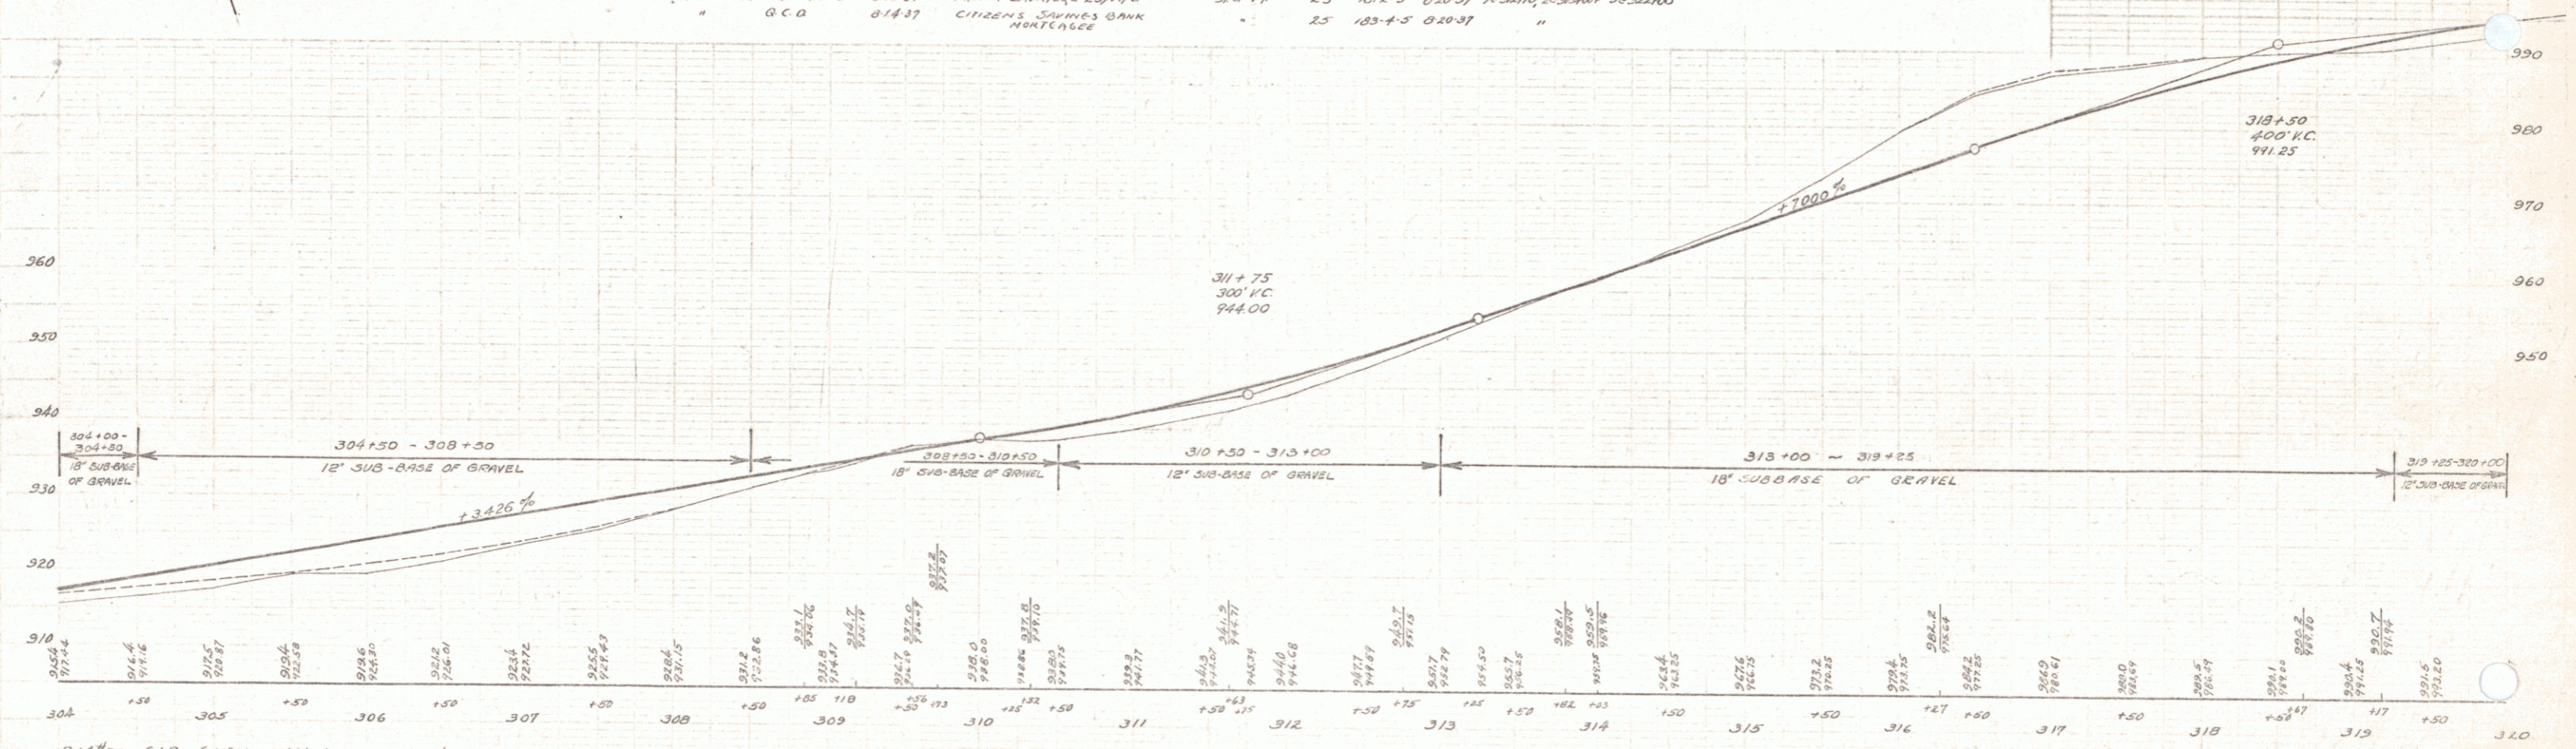

B.M. #30 S.I.R. of 18' Elm 26' W Sh 312 166 Elev 970.76
 B.M. #31 Spotted Boulder 46' W 317+82 " 990.71

SERIES K.P.R. NO 708
 SHEET 9 OF 106