


PARCEL	INSTRUMENT	DATE	GRANTOR	GRANTEE	RECORDED	REMARKS
A-B	M.D.	7-15-37	W.E. DOUGLAS	SP. 41	BOOK PAGE DATE CUL. STA.	103-103-0 1-23-37 41+3351-50

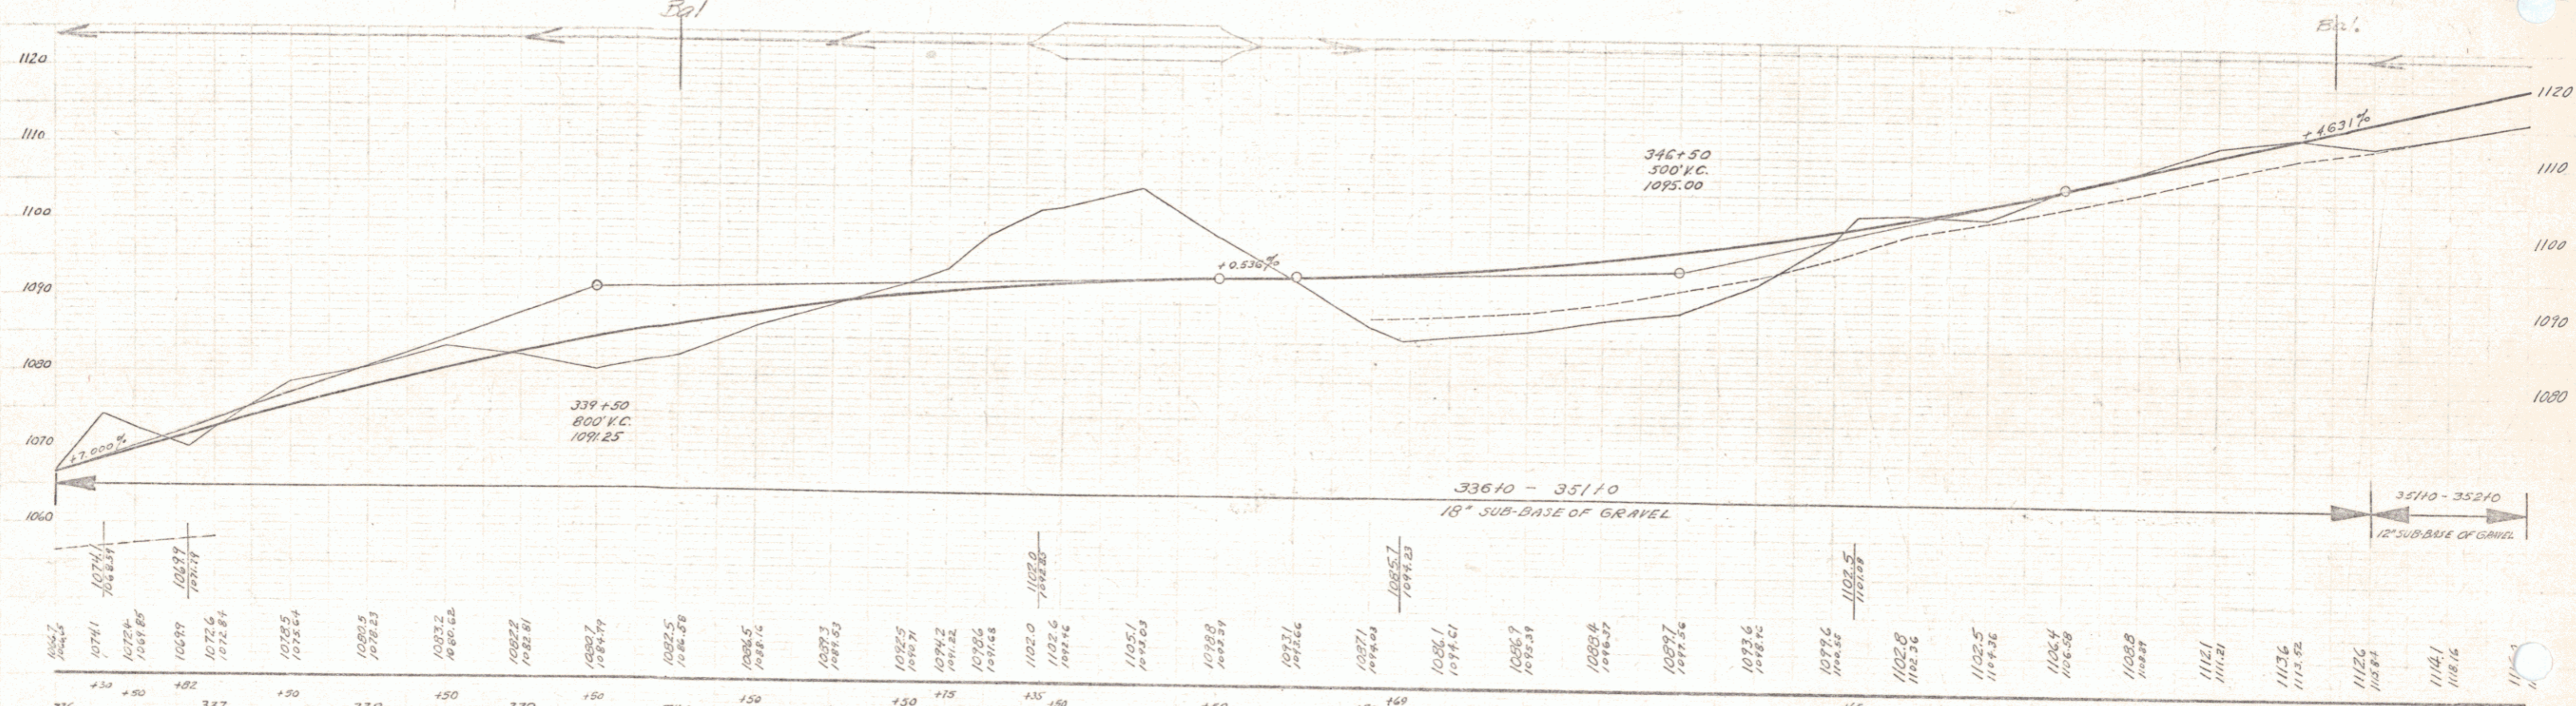

Station	Elevation	Notes
336+50	1074.1	BM 34A S.I.T. 24' Pine 38' W. 30' 390' 41' Elev. 1087.18
337+00	1078.1	BM 35 Spot on Boulder " 351+00 90" " 1112.26
338+50	1082.5	
339+50	1087.1	
340+50	1091.2	
341+50	1095.3	
342+50	1099.4	
343+50	1103.5	
344+50	1107.6	
345+50	1111.7	
346+50	1115.8	
347+50	1119.9	
348+50	1124.0	
349+50	1128.1	
350+50	1132.2	
351+50	1136.3	