




AREA: 1.195 ACRES ±

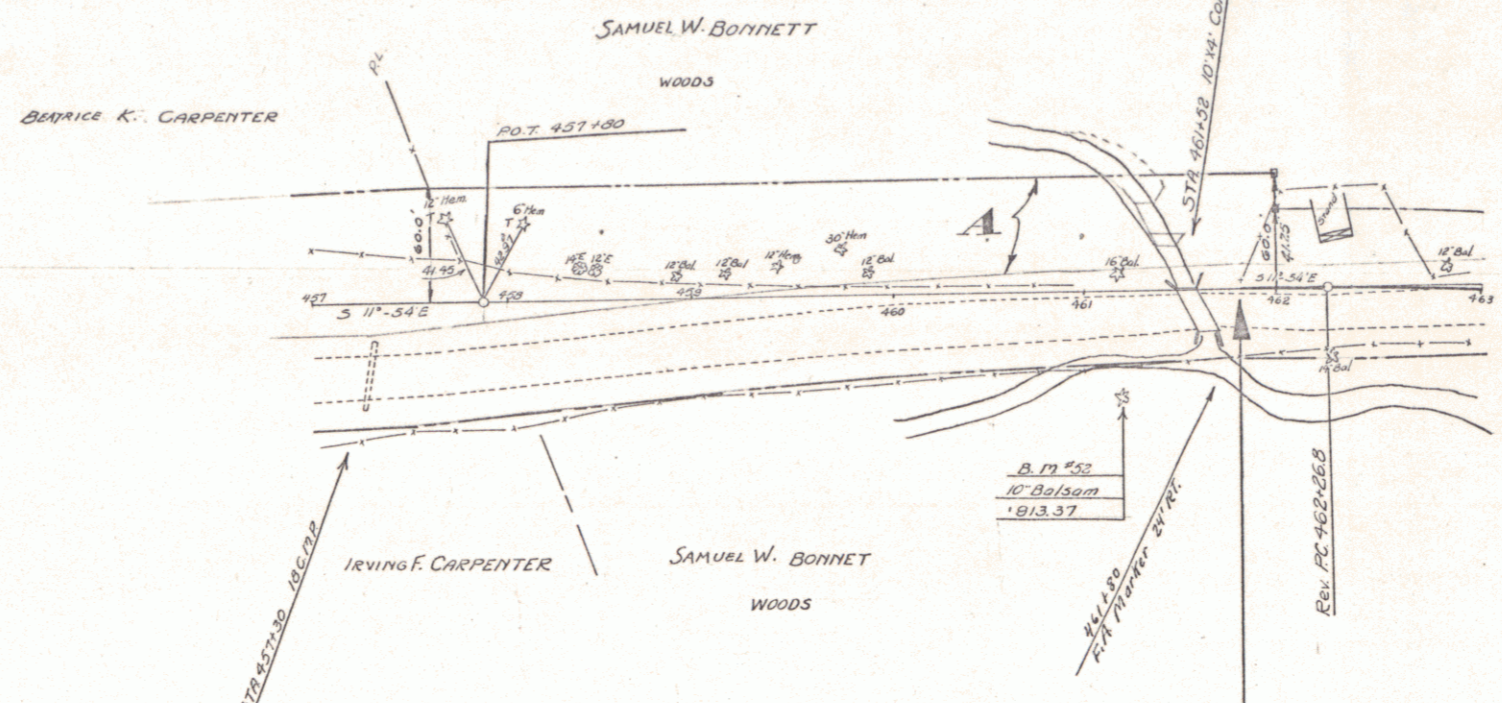

PARCEL	INSTRUMENT	DATE	GRANTOR	GRANTEE	RECORDED	REMARKS
A-B	Q.C.O.	7-15-37	SAMUEL W. & GENE H. BONNETT	5107 FT.	MADE FOR 25 190-7	7-15-37

STA 75+30
 END OF F.A.P. 70-G
 (CONTRACT 1) BUILT IN 1926

STA 96+00
 END OF F.A.P. 70-G
 (CONTRACT 2)

STA 96+00
 F.A.P. 70-E RESUMES

